
PARENT PARCEL: 07-00-004-108-018

CHILD PARCEL: AC CORR PER SURV BY WILFREDO BARBOSA

STARTING POINT: C/L OF MILLS AND CHESTNUT RIDGE RD

24-05422-C

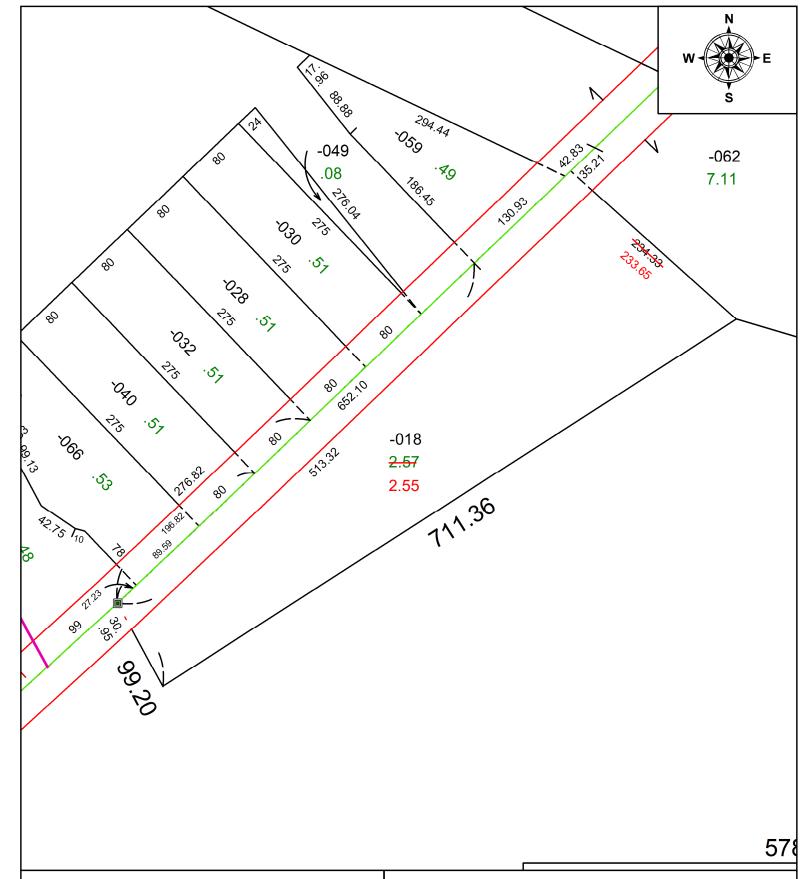

SPLITS/DEEDS PROCESSED

LORAIN COUNTY TAX MAP DEPARTMENT 226 MIDDLE AVE. ELYRIA, OH

 SURVEYED BY:
 WILFREDO BARBOSA
 SURV # 51345

 CLOSURE:
 1: 343696

 MAP PAGE(S):
 07-00-004

 APPOVED BY:
 AC
 DATE:
 December 17, 2024

 SCALE:
 1 in = 100 ft
 PRIOR INSTRUMENT:
 2009- 0287049