
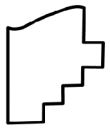


PARENT PARCEL: 05-00-026-101-061 & -062

CHILD PARCEL: 05-00-026-101-132

STARTING POINT: INTERSECTION FALLEN OAK LN AND SLEEPY HOLLOW DRIVE DR.

24-05432-C

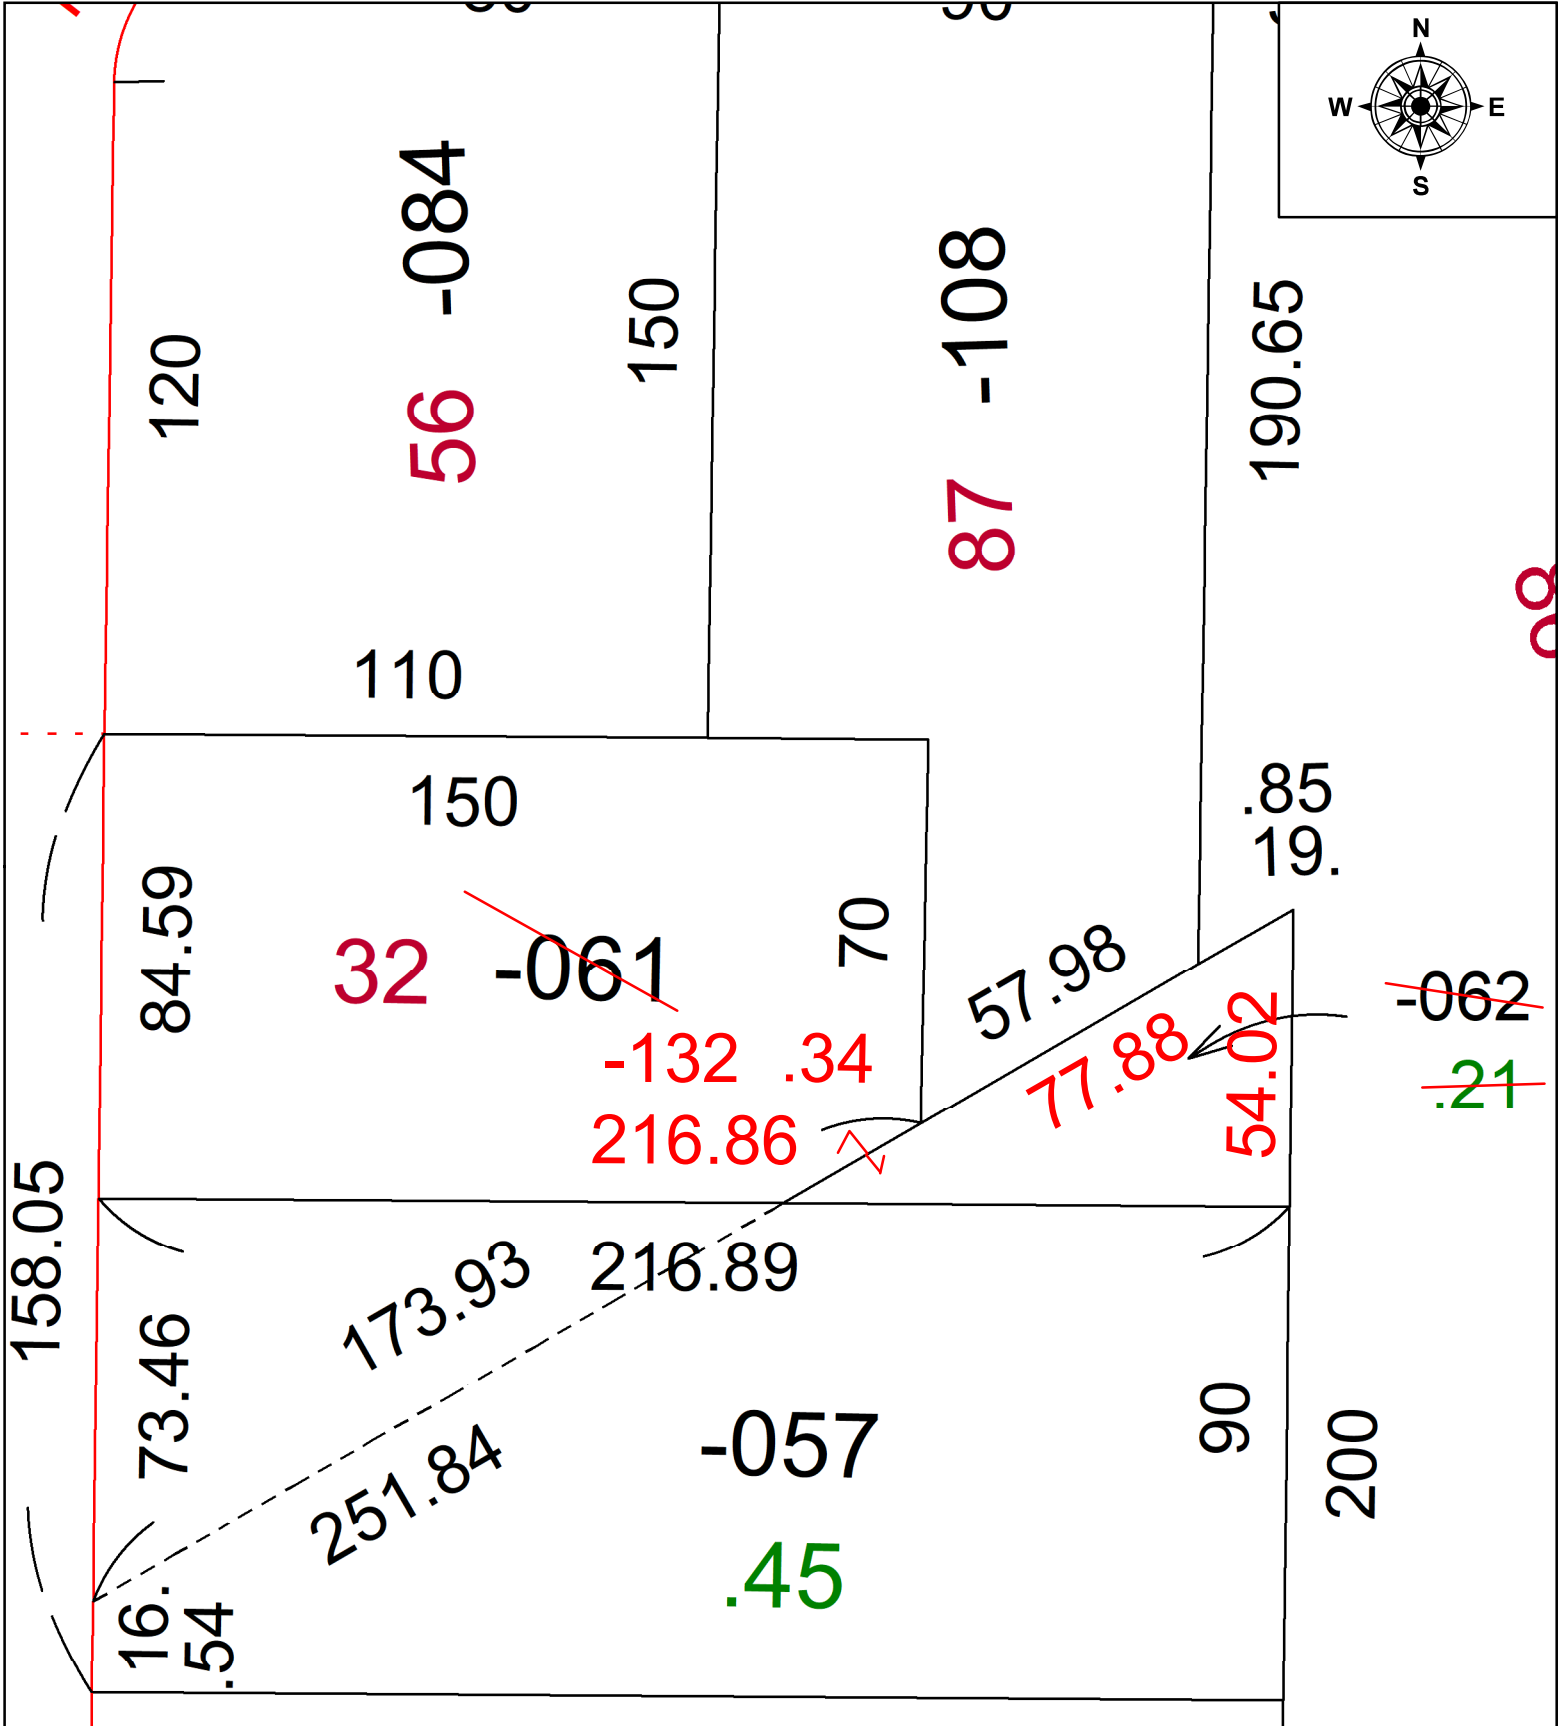

SPLITS/DEEDS PROCESSED
 LORAIN COUNTY TAX MAP DEPARTMENT
 226 MIDDLE AVE. ELYRIA, OH

SURVEYED BY: SCOTT CASEY SURVEY #: 51356
 CLOSURE: 1: 126029
 MAP PAGE(S): 0500026
 APPROVED BY: BB DATE: 1/6/2025
 SCALE: 1" = 30' PRIOR INSTRUMENT: #19960398386