
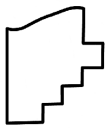


PARENT PARCEL: 07-00-028-103-004

CHILD PARCEL: AC CORR PER SURV BY T.W. LAUNDON

STARTING POINT: C/L OF WHITEHEAD AND SR 303

25-05436-C

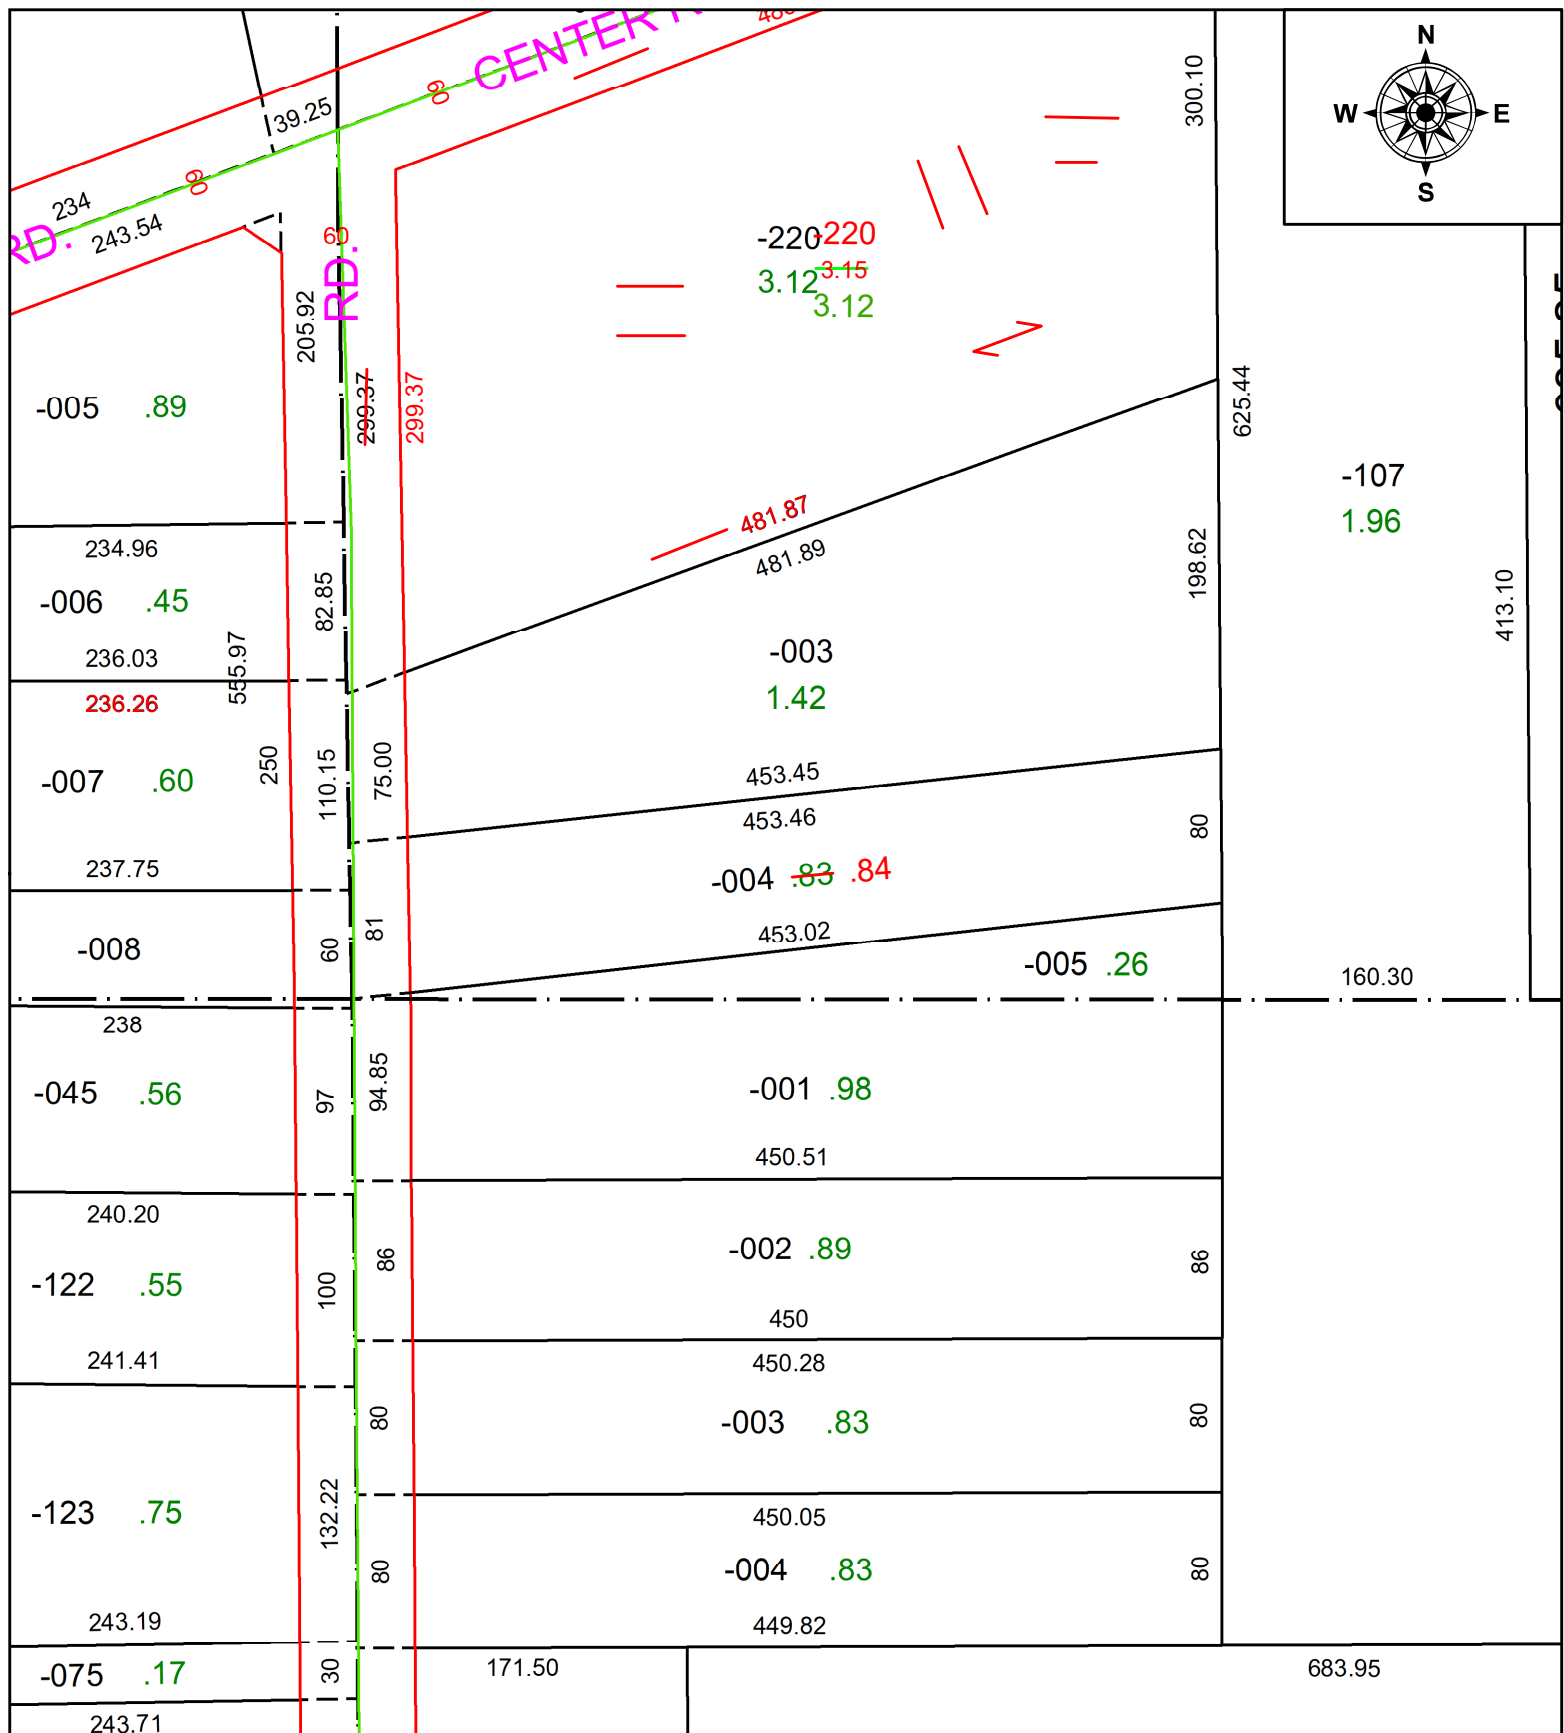

SPLITS/DEEDS PROCESSED
 LORAIN COUNTY TAX MAP DEPARTMENT
 226 MIDDLE AVE. ELYRIA, OH

SURVEYED BY: T.W. LAUNDON SURV # N/A
 CLOSURE: 1: 100789
 MAP PAGE(S): 07-00-028
 APPROVED BY: AC DATE: January 07, 2025
 SCALE: 1 in = 100 ft PRIOR INSTRUMENT: N/A