



PARENT PARCEL: 03-00-113-102-049

CHILD PARCEL: AC CORR PER SURV BY SEAN A. BOLAND

STARTING POINT: C/L OF COOPER FOSTER RD AND S BROADWAY AVE

25-05442-C

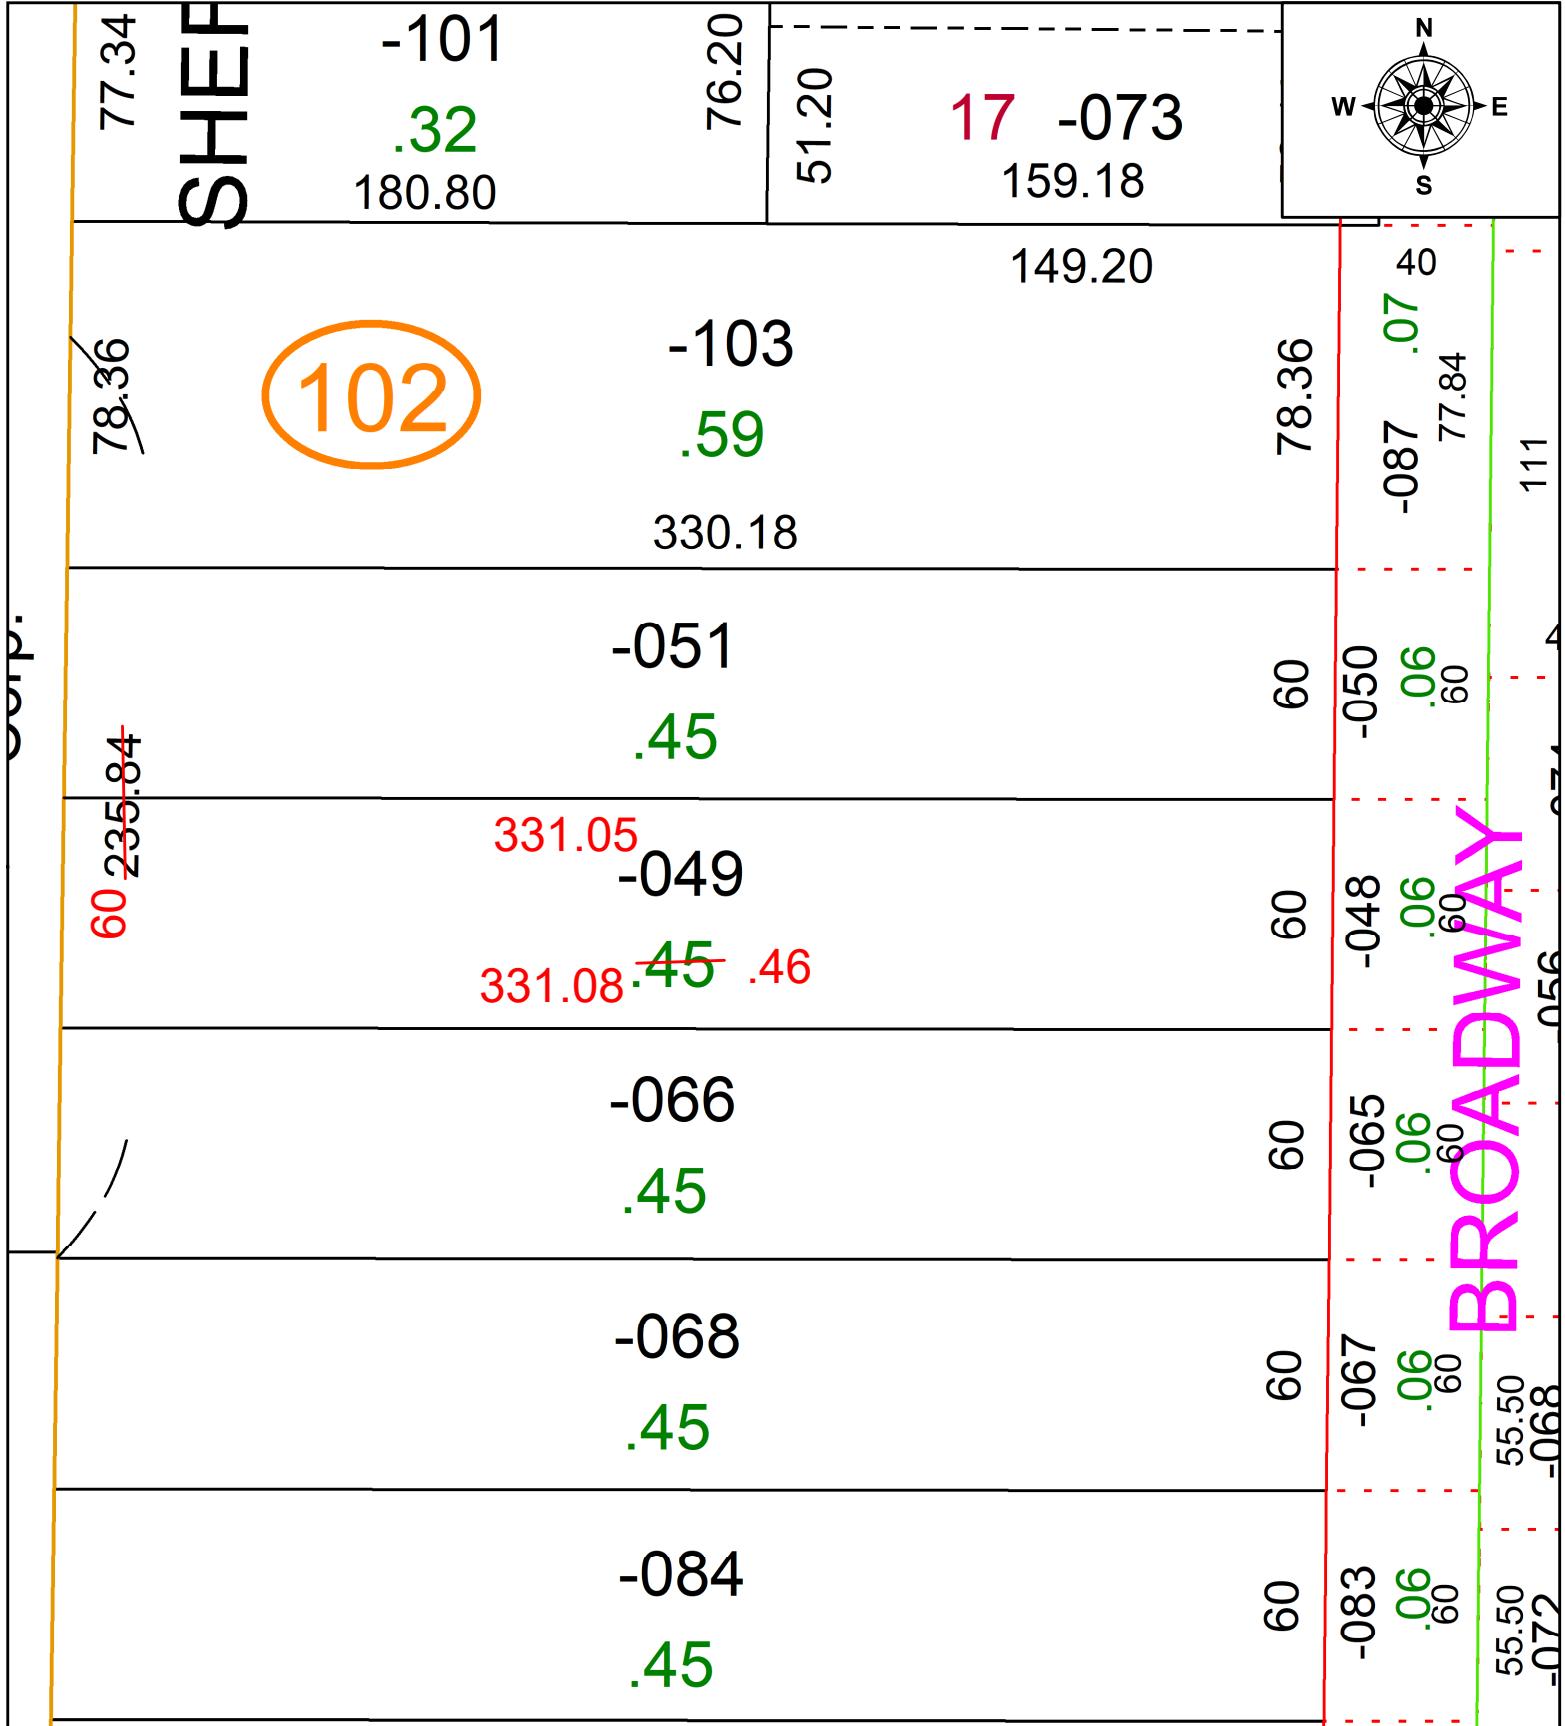

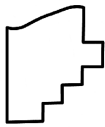 **SPLITS/DEEDS PROCESSED**
 LORAIN COUNTY TAX MAP DEPARTMENT
 226 MIDDLE AVE. ELYRIA, OH

SURVEYED BY: SEAN A. BOLAND SURV # 51367
 CLOSURE: 1: 158732
 MAP PAGE(S): 03-00-113
 APPROVED BY: AC DATE: January 13, 2025
 SCALE: 1 in = 50 ft PRIOR INSTRUMENT: 2024- 0035370