


PARENT PARCEL: 07-00-009-101-084
 CHILD PARCEL: AC. CORR. FROM 0.94 A. TO 0.99 A. PER SURVEY
 STARTING POINT: 1" I.P. MON. BOX FD. NORTH LINE OF O.L.9 & CL OF LEAR NAGLE RD.

25-05444-C

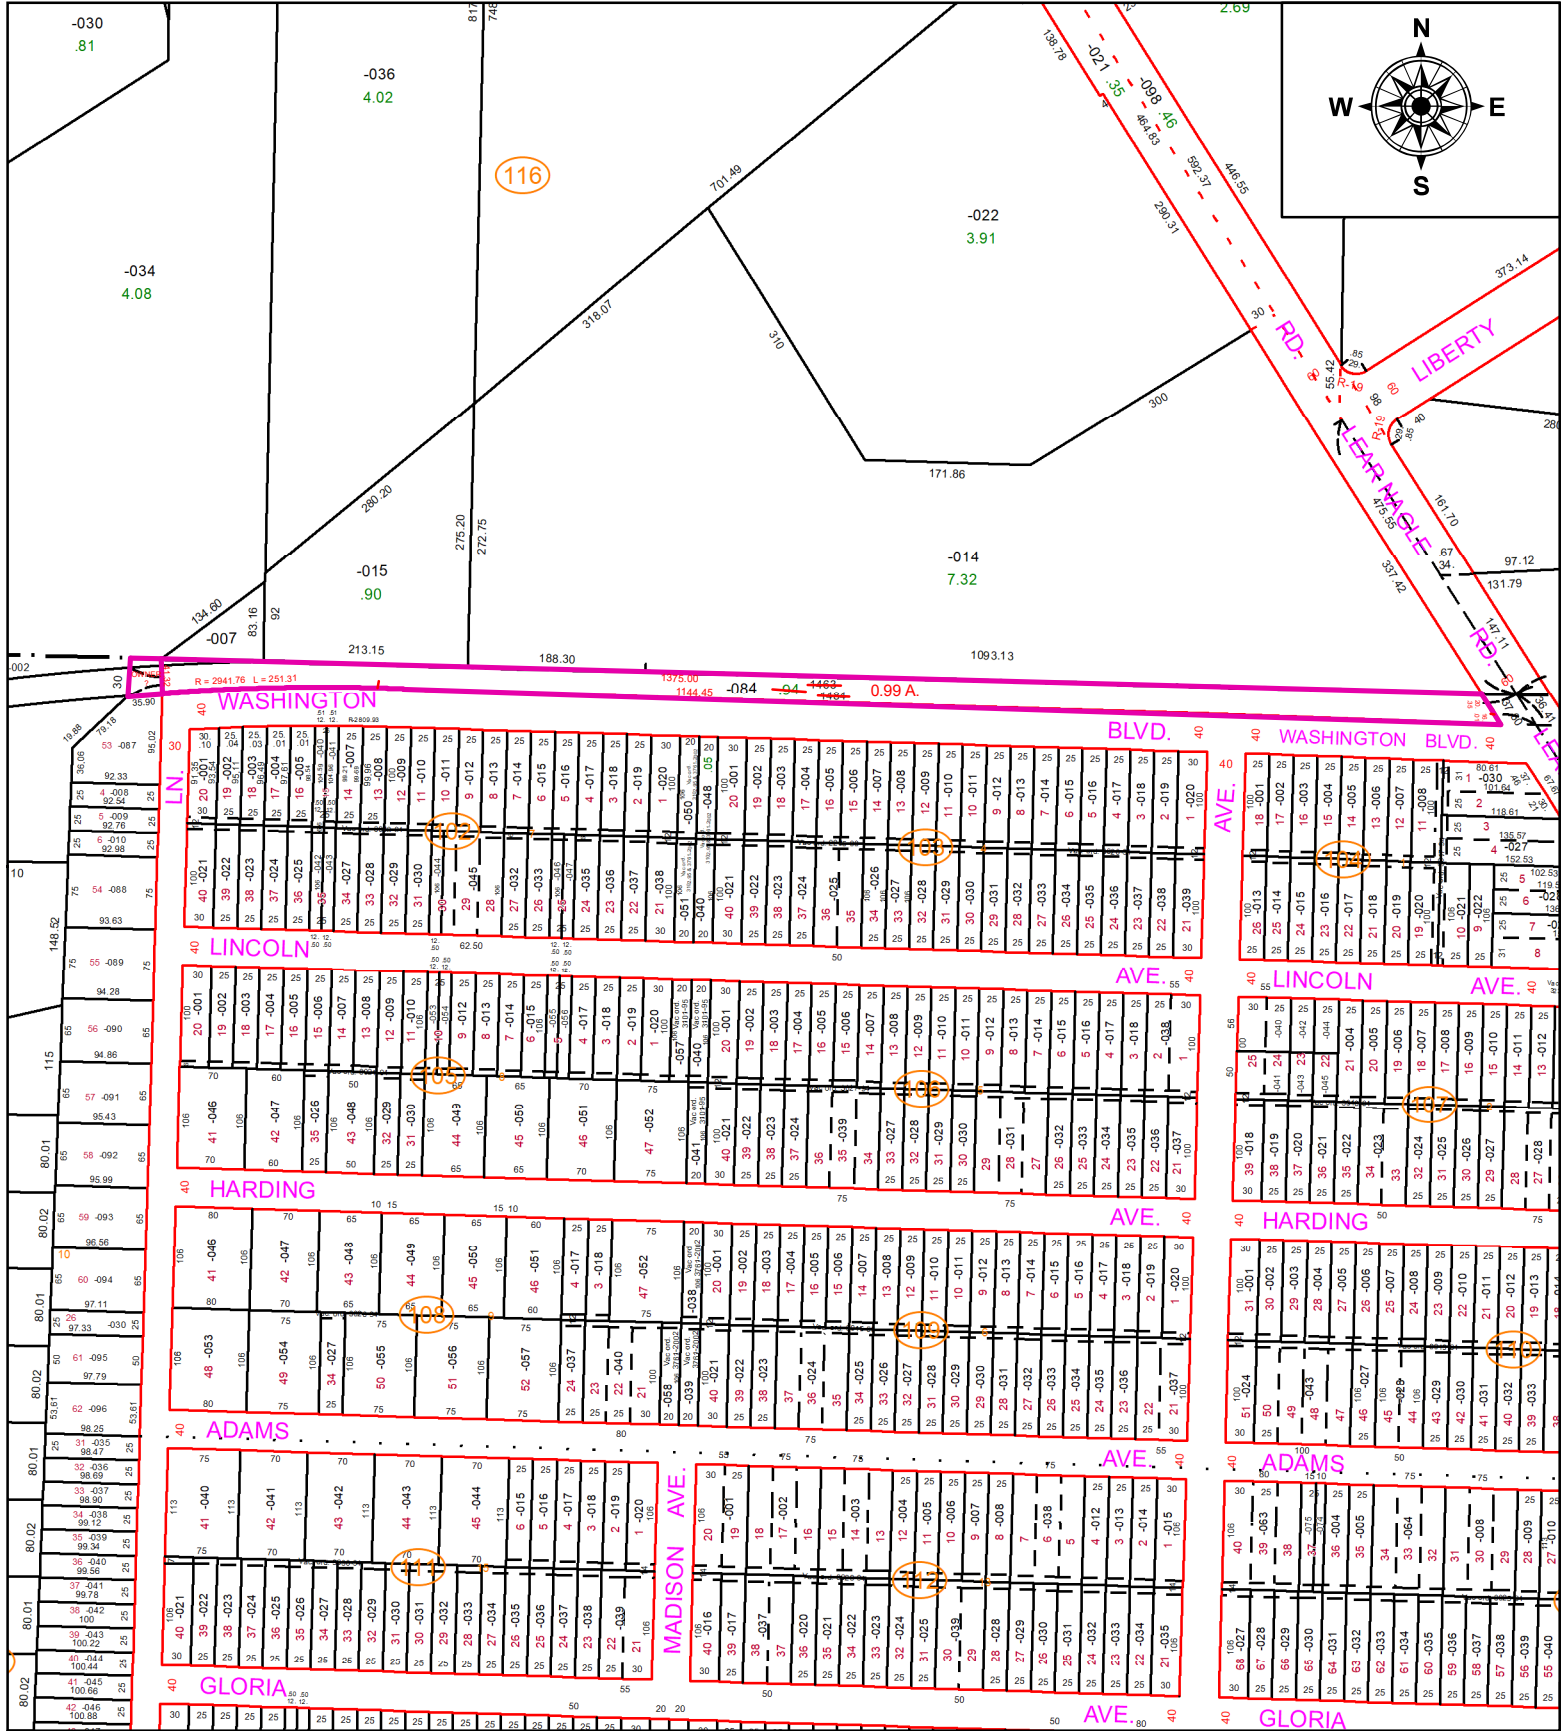

SPLITS/DEEDS PROCESSED
 LORAIN COUNTY TAX MAP DEPARTMENT
 226 MIDDLE AVE. ELYRIA, OH

SURVEYED BY: R. HINTON
 CLOSURE: 1:675769
 MAP PAGE(S): 07-00-009
 APPROVED BY: TJS DATE: 1/24/2025
 SCALE: 1" = 200' PRIOR INSTRUMENT: 2018-0681097