


PARENT PARCEL: 20-04-014-000-003

CHILD PARCEL: AC. CORR. PER INSTRUMENT # 2012-0402520



STARTING POINT: N/A

25-05448-A

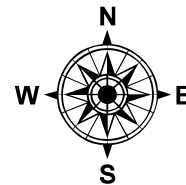

NEW LONDON-LAFAYETTE

TRACT

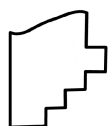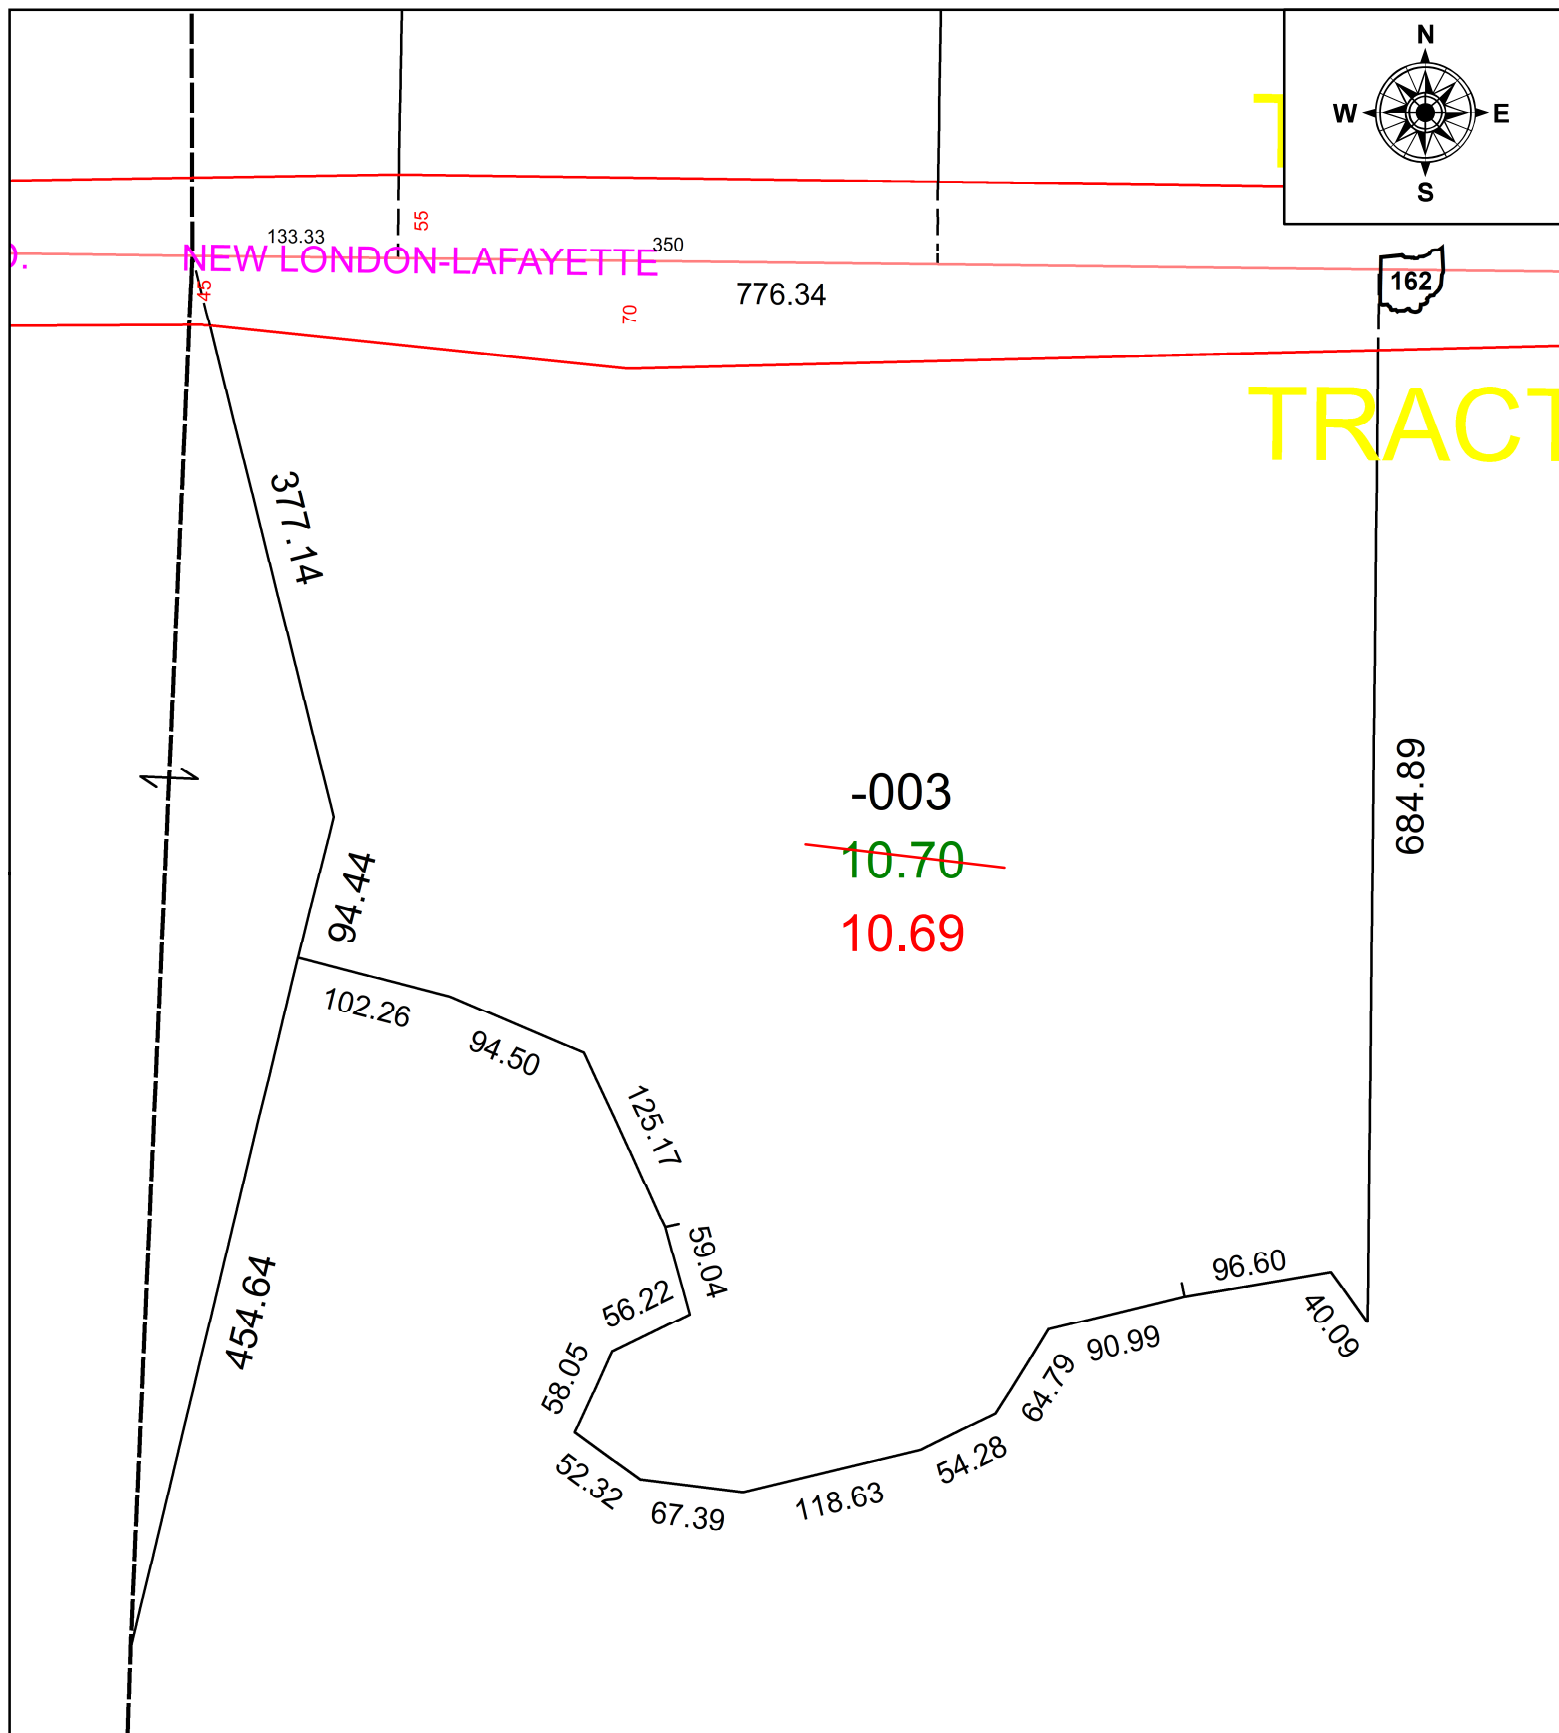

SPLITS/DEEDS PROCESSED
LORAIN COUNTY TAX MAP DEPARTMENT
226 MIDDLE AVE. ELYRIA, OH

SURVEYED BY: TIOOTHY RILEY SURVEY #: 47108
CLOSURE: N/A
MAP PAGE(S): 20-04-014
APPROVED BY: DMA DATE: 1/28/2025
SCALE: 1" = 125' PRIOR INSTRUMENT: 2012-0402520