


PARENT PARCEL: 02-00-093-106-004, -005, -006, -010 THRU -014, -017 THRU -021, & -023

CHILD PARCEL: VACATION PER ORD. 182-24

STARTING POINT:

25-05452-V

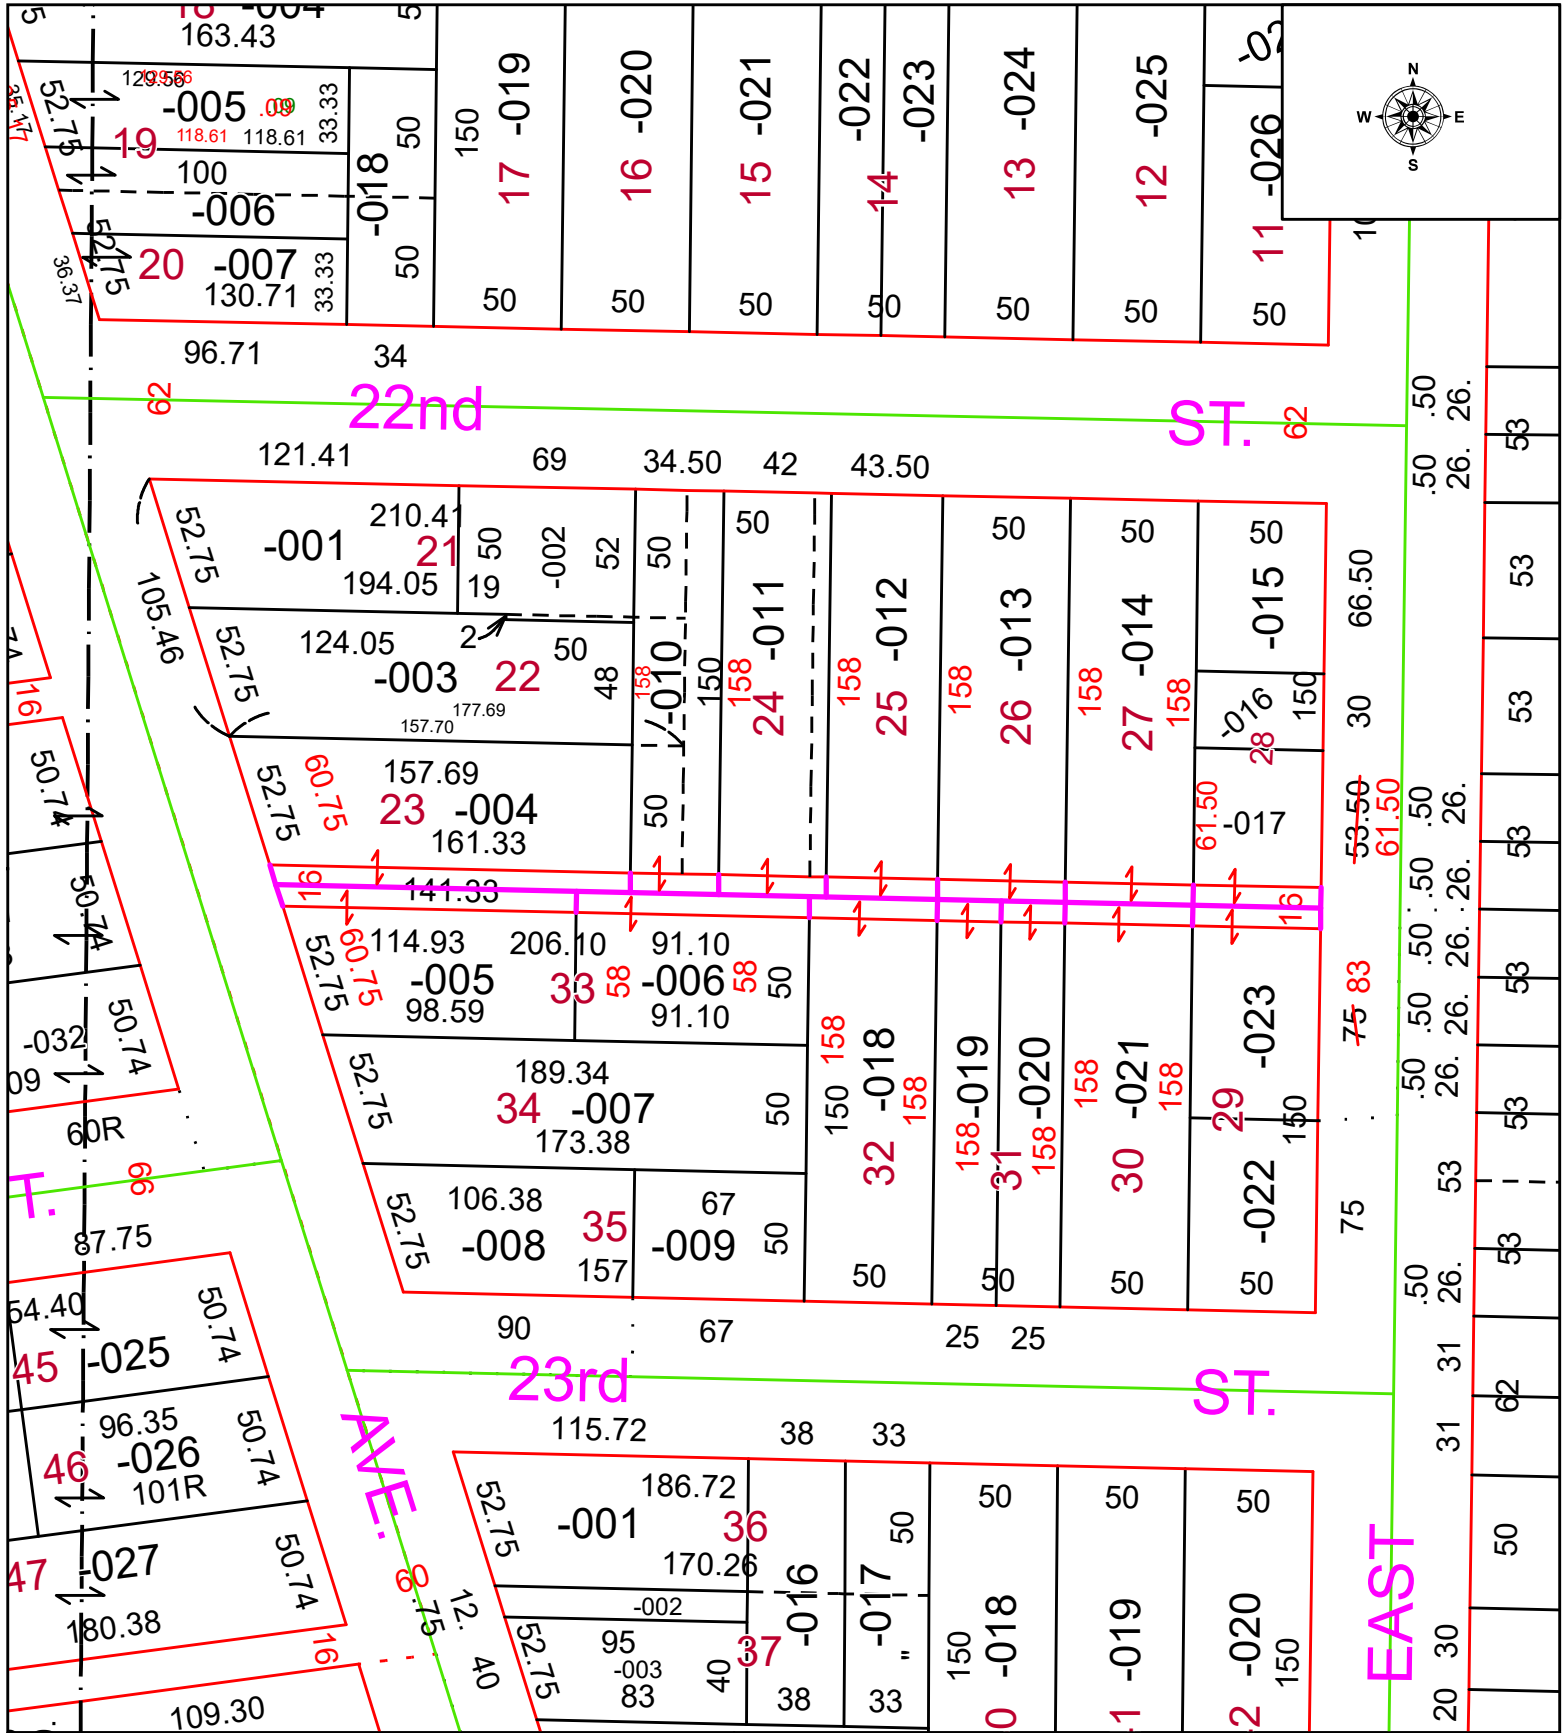

SPLITS/DEEDS PROCESSED
 LORAIN COUNTY TAX MAP DEPARTMENT
 226 MIDDLE AVE. ELYRIA, OH

SURVEYED BY: _____ N/A SURVEY # N/A
 CLOSURE: _____ 1: _____
 MAP PAGE(S): _____ 02-00-093
 APPROVED BY: WRZ DATE: 1/30/2025
 SCALE: 1" = 75' PRIOR INSTRUMENT: _____ N/A