
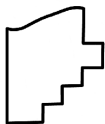
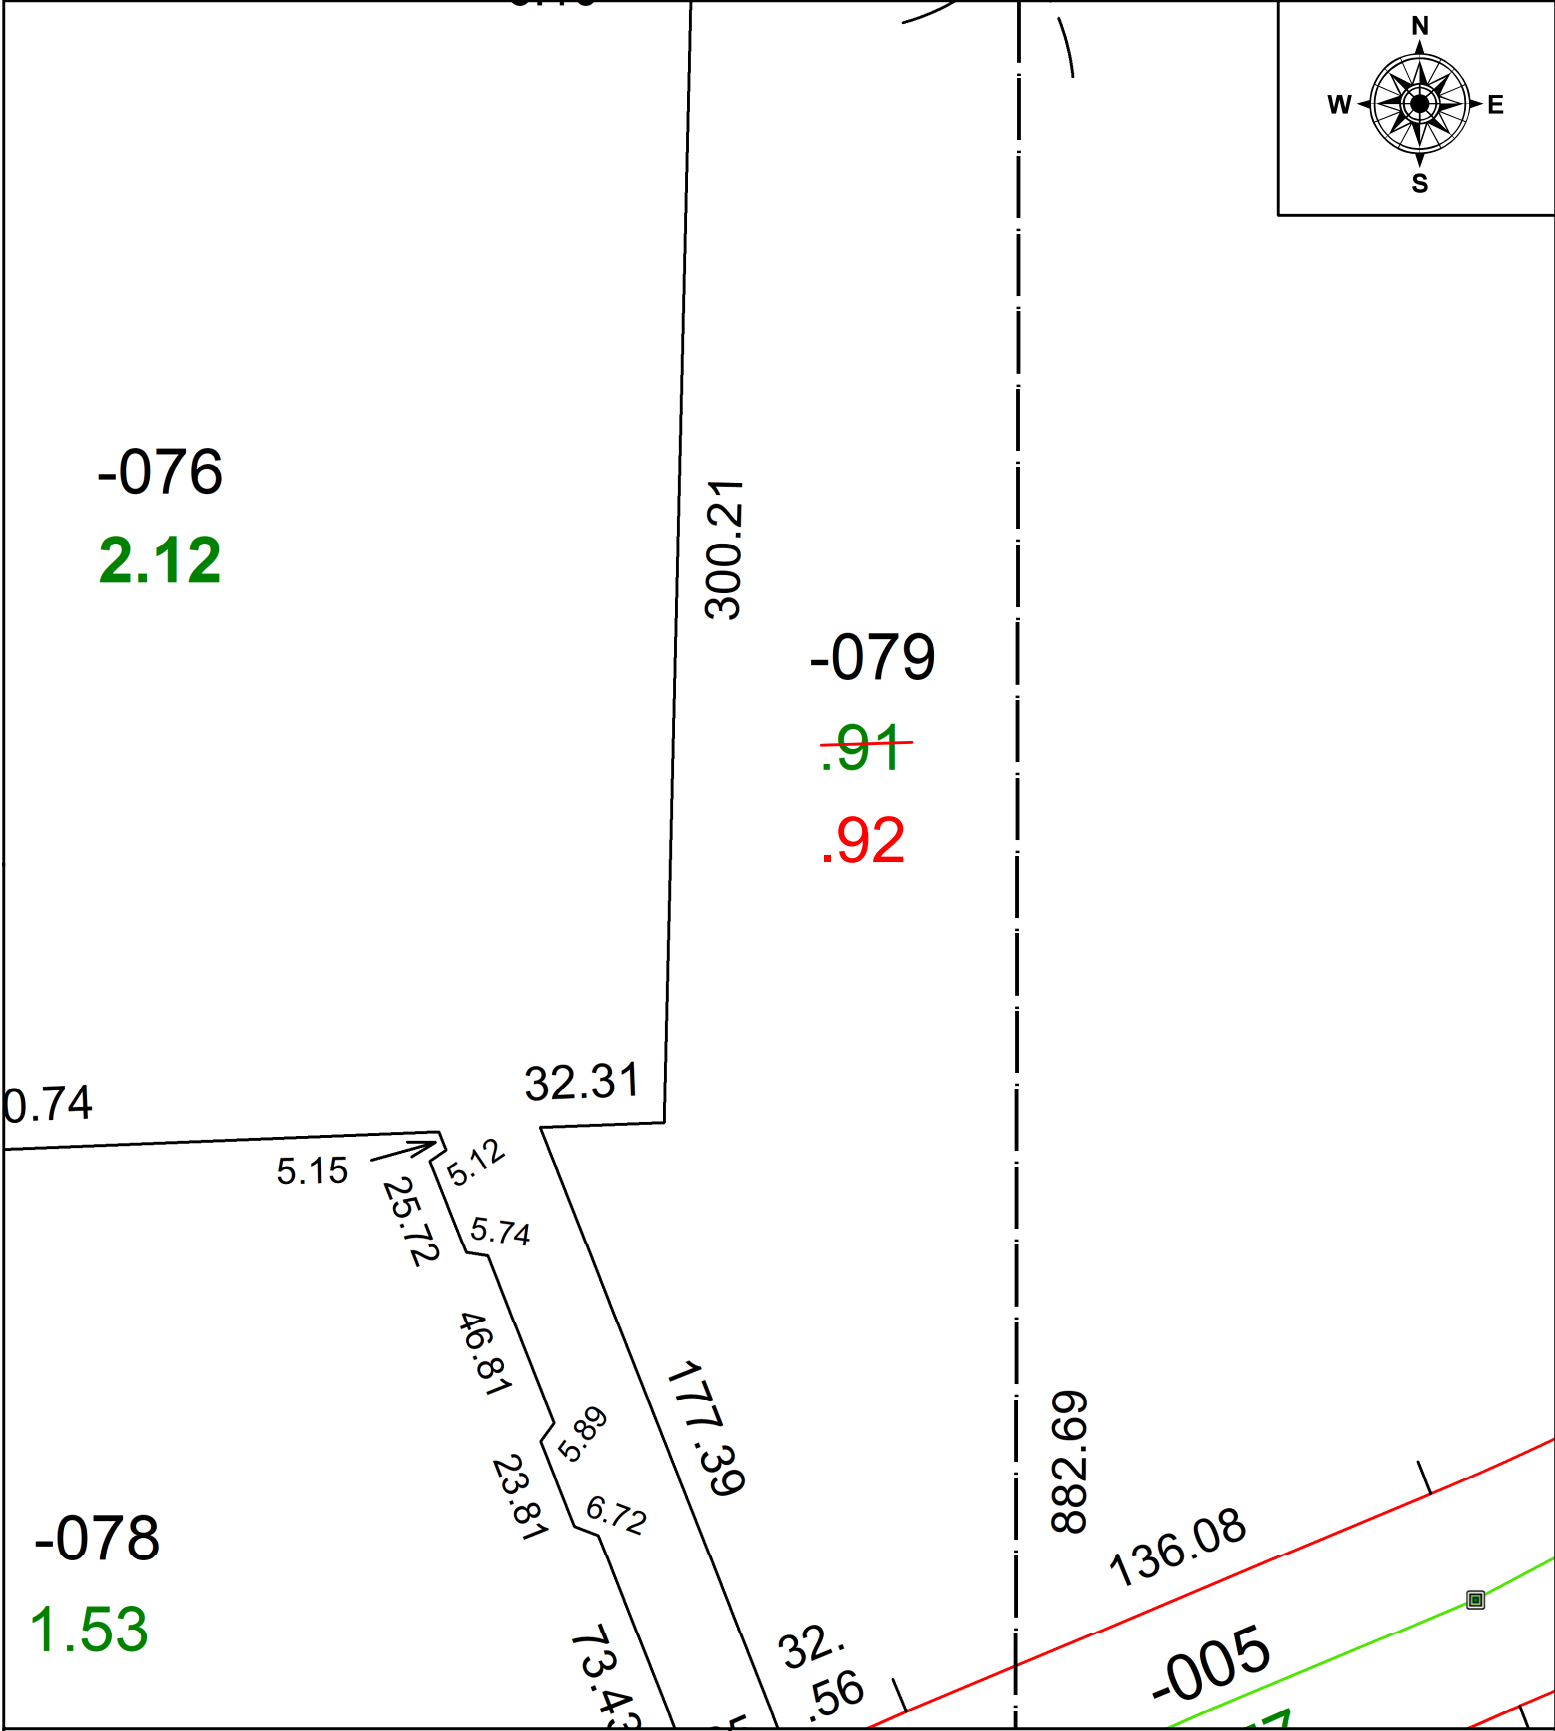


PARENT PARCEL: 03-00-073-000-079  
CHILD PARCEL: AC CORR PER SURV BY DALE HAYWOOD  
STARTING POINT:

25-04972

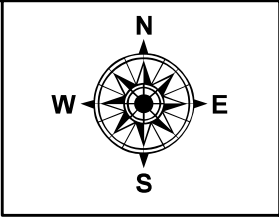

**SPLITS/DEEDS PROCESSED**  
LORAIN COUNTY TAX MAP DEPARTMENT  
226 MIDDLE AVE. ELYRIA, OH

SURVEYED BY:	DALE HAYWOOD	SURV #	N/A
CLOSURE:	1: 100789		
MAP PAGE(S):	03-00-073		
APPROVED BY:	AC	DATE:	February 05, 2025
SCALE:	1 in = 50 ft	PRIOR INSTRUMENT:	2002- 0829622