
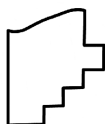
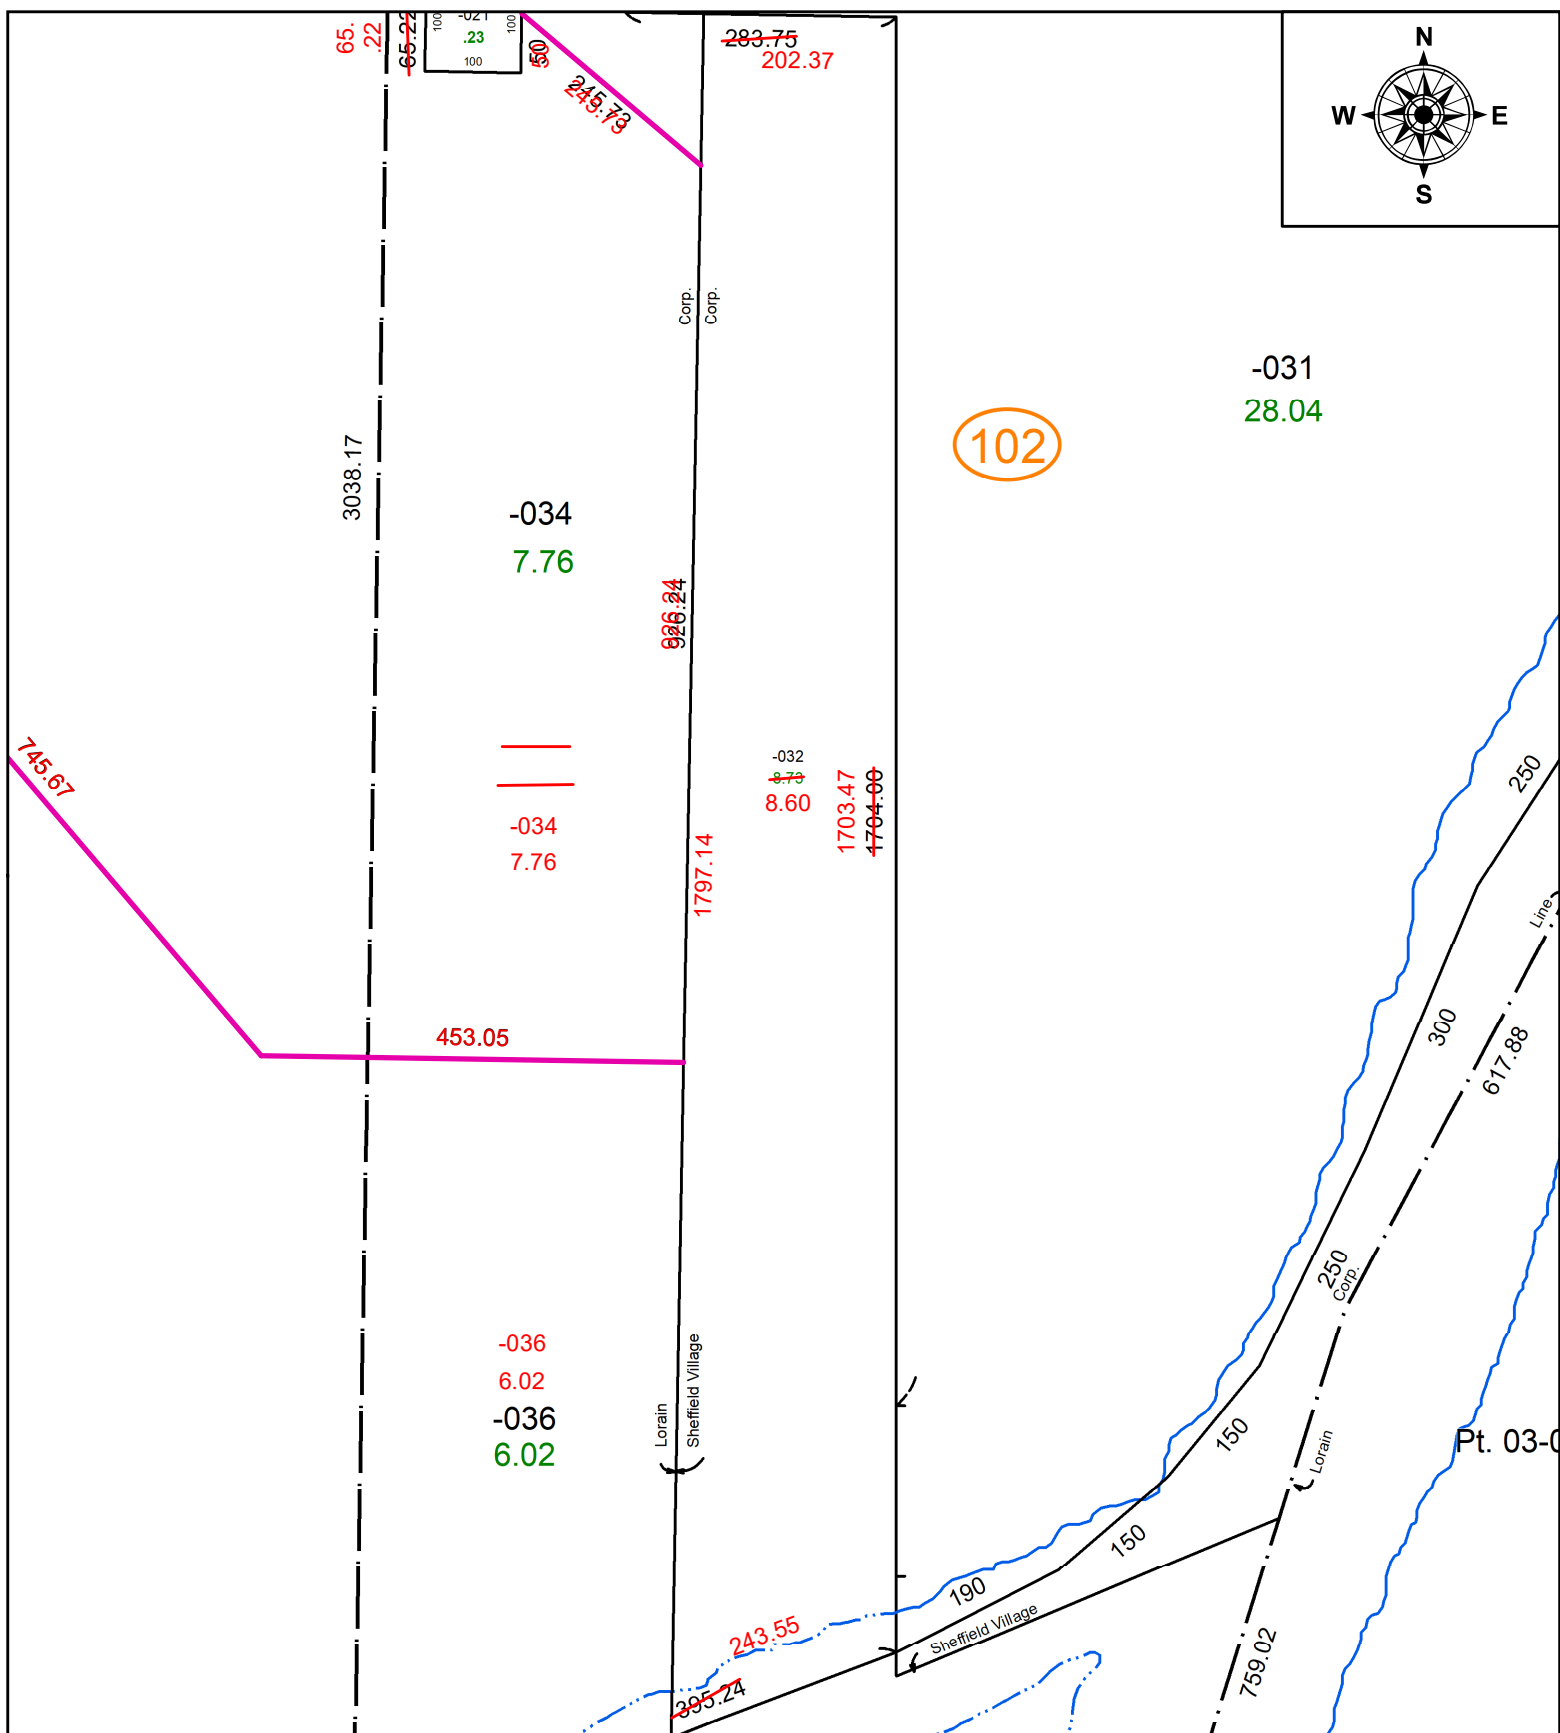


STARTING POINT: C/L OF CROMWELL AND ROOT RD

25-05462-C

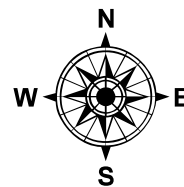

SPLITS/DEEDS PROCESSED
LORAIN COUNTY TAX MAP DEPARTMENT
226 MIDDLE AVE. ELYRIA, OH

SURVEYED BY: MICHAEL P. SPELLACY

SURV # 51400

CLOSURE: 1: 1368091

MAP PAGE(S): 03-00-058

APPROVED BY: AC **DATE:** February 25, 2025

SCALE: 1 in = 200 ft **PRIOR INSTRUMENT:** 2024- 0035734