
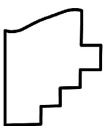


06-25-176-103-022

FR. & DPTH CORR TO AC CORR PER SURVEYOR ROBERT RUFFING

NORTHEASTERLY CORNER OF S/L 72 IN COUNTRY CLUB ESTATES NO. 1

25-05463-C

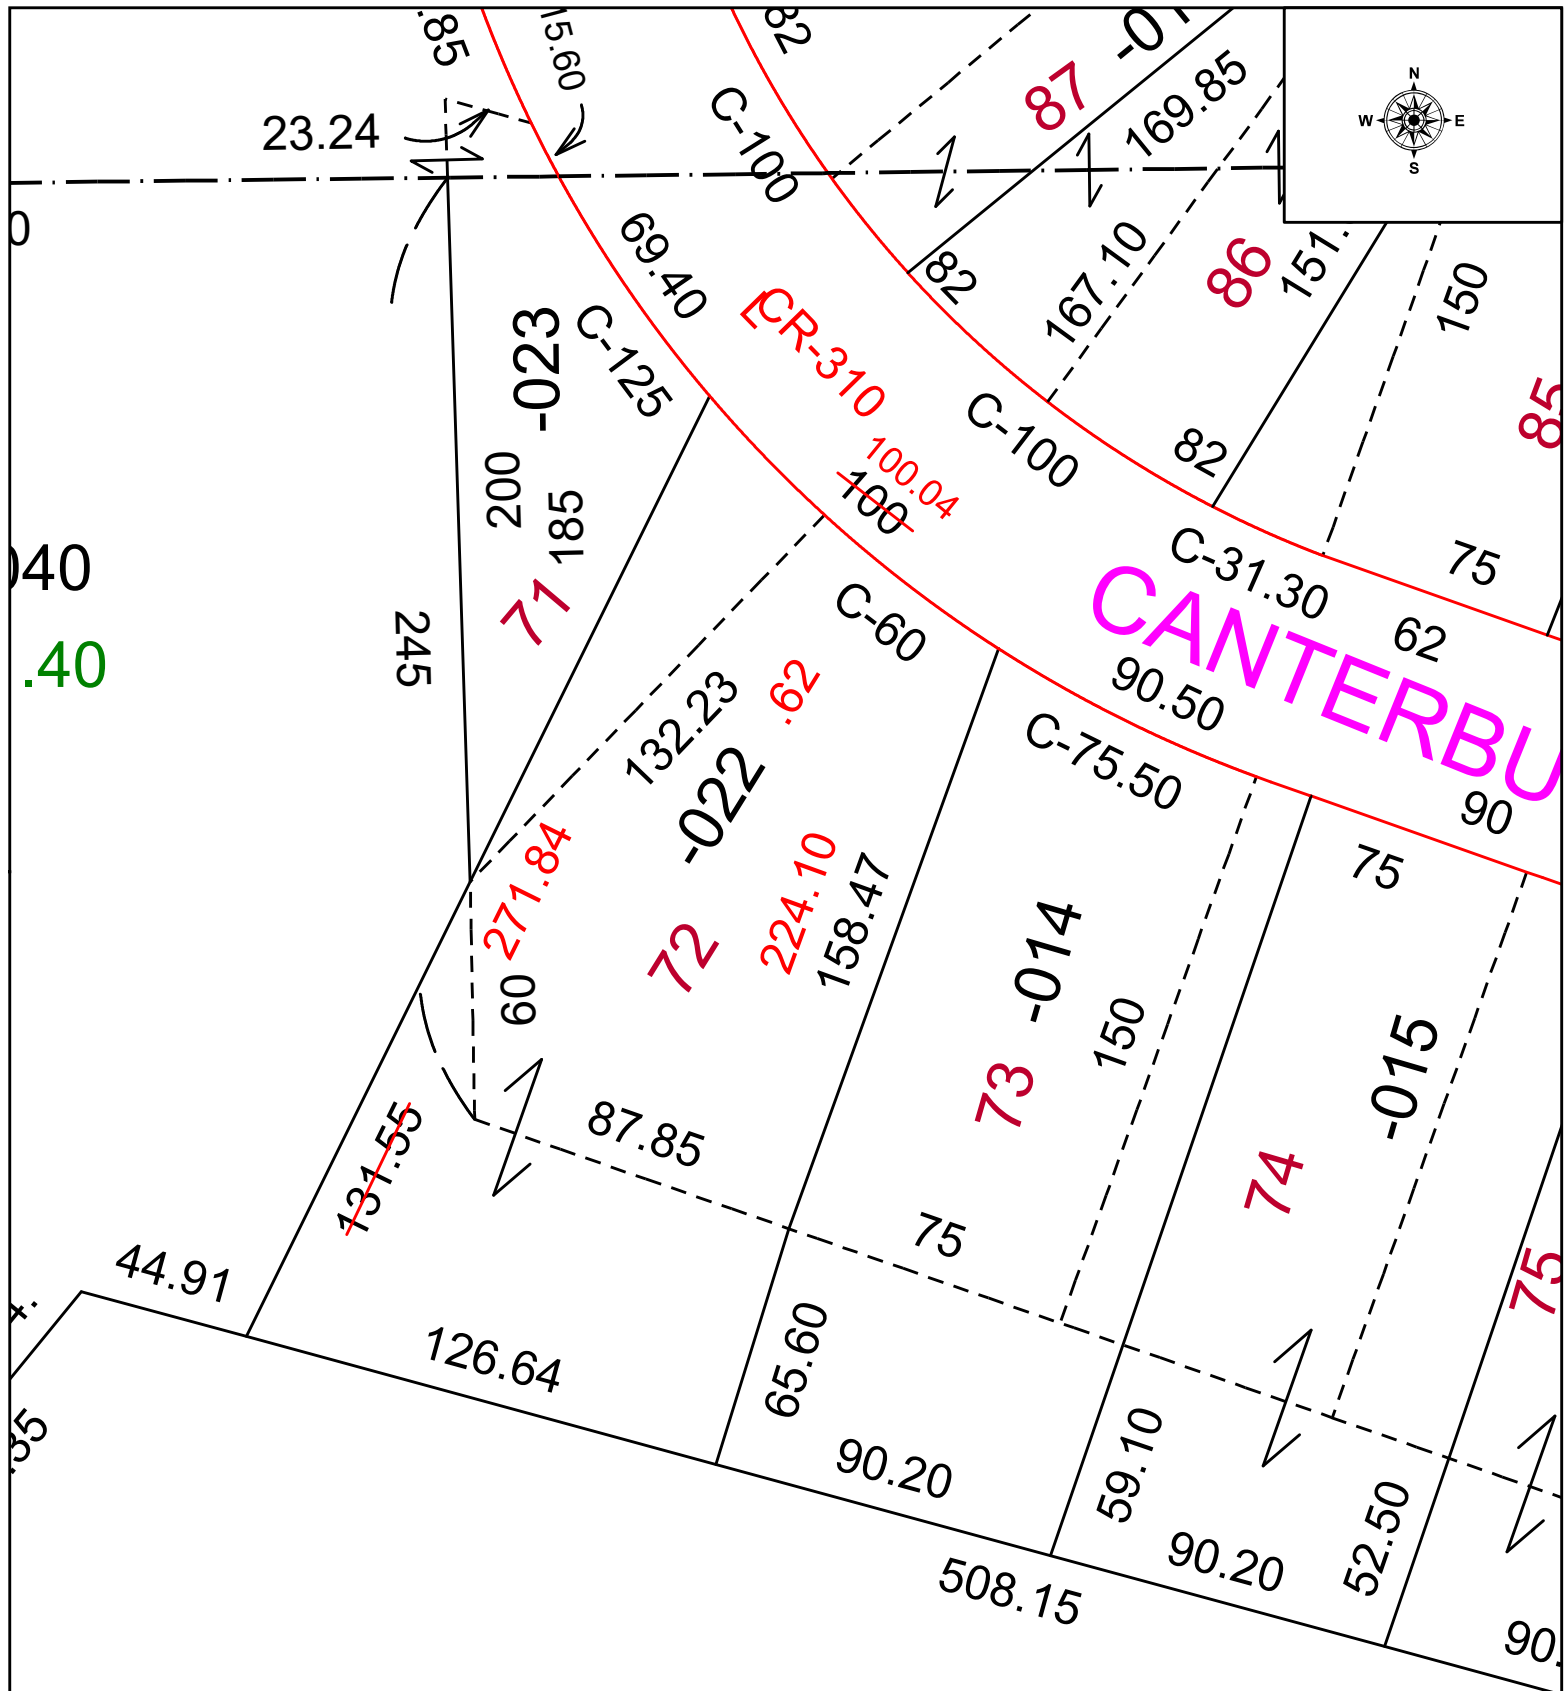

SPLITS/DEEDS PROCESSED
LORAIN COUNTY TAX MAP DEPARTMENT
226 MIDDLE AVE. ELYRIA, OH

SURVEYED BY: ROBERT RUFFING **SURVEY #** 51404
CLOSURE: 1: 411844
MAP PAGE(S): 06-25-176
APPROVED BY: WRZ **DATE:** 2/25/2025
SCALE: 1" = 25 **PRIOR INSTRUMENT:** #2022-0890717