
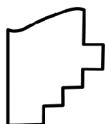


04-00-028-102-173 & -174

MAP CORRECTION

INTERSECTION OF AVON RD AND PINE DR

25-05470-C

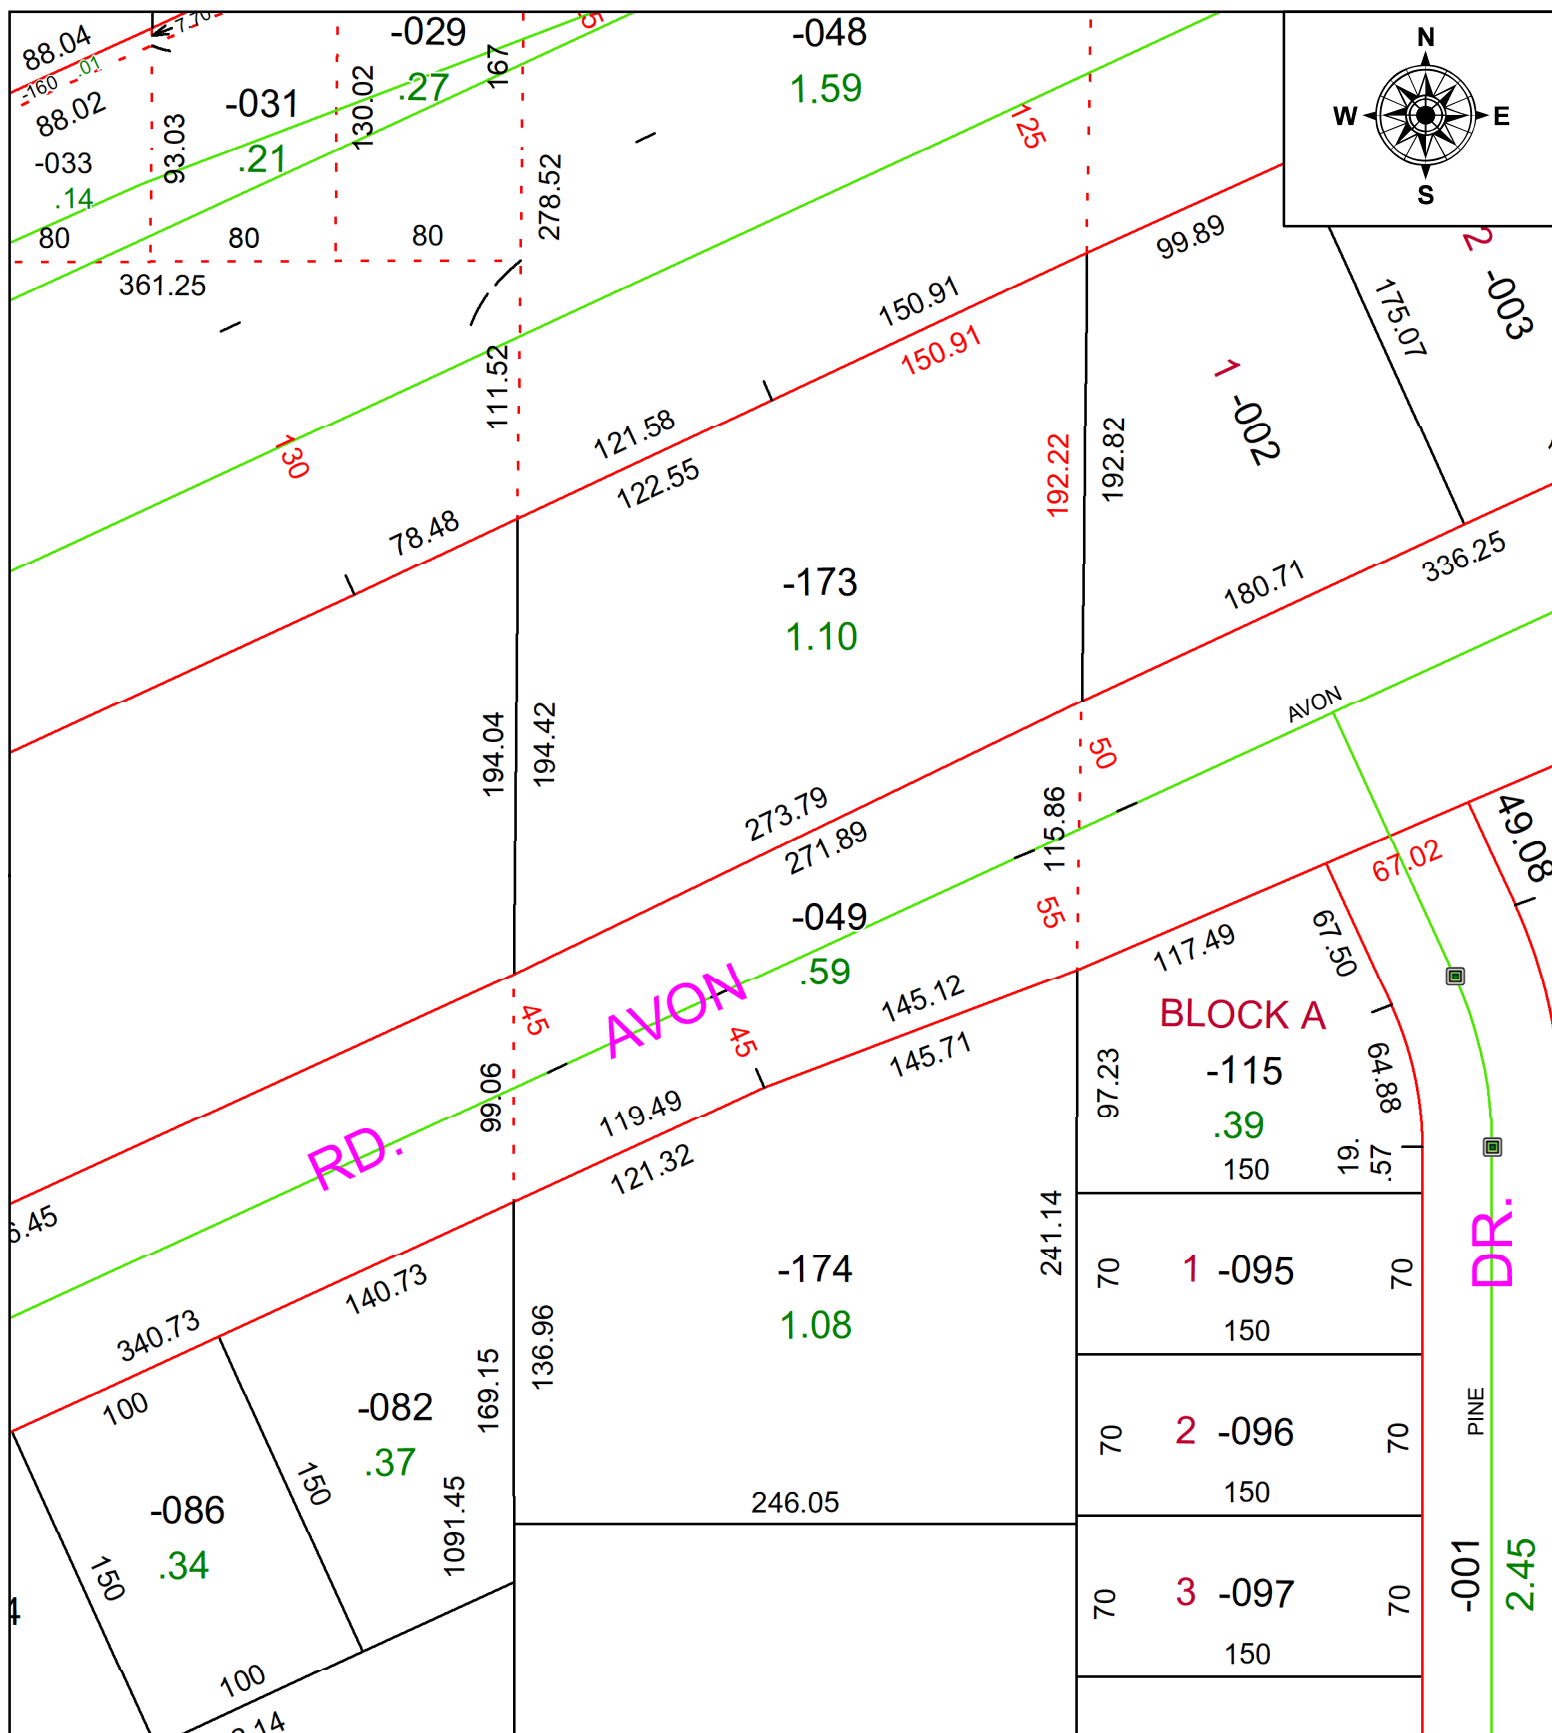

SPLITS/DEEDS PROCESSED

LORAIN COUNTY TAX MAP DEPARTMENT
226 MIDDLE AVE. ELYRIA, OH

SURVEYED BY: AMY M. KELLY

SURVEY #: 47013

CLOSURE: 1:711586

MAP PAGE(S): 04-00-028

APPROVED BY: BB **DATE:** 3/18/2025

SCALE: 1" = 1000' **PRIOR INSTRUMENT:** #20190729409

$$1'' = 1000'$$

PRIOR INSTRUMENT: #20190729409