
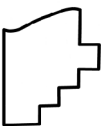
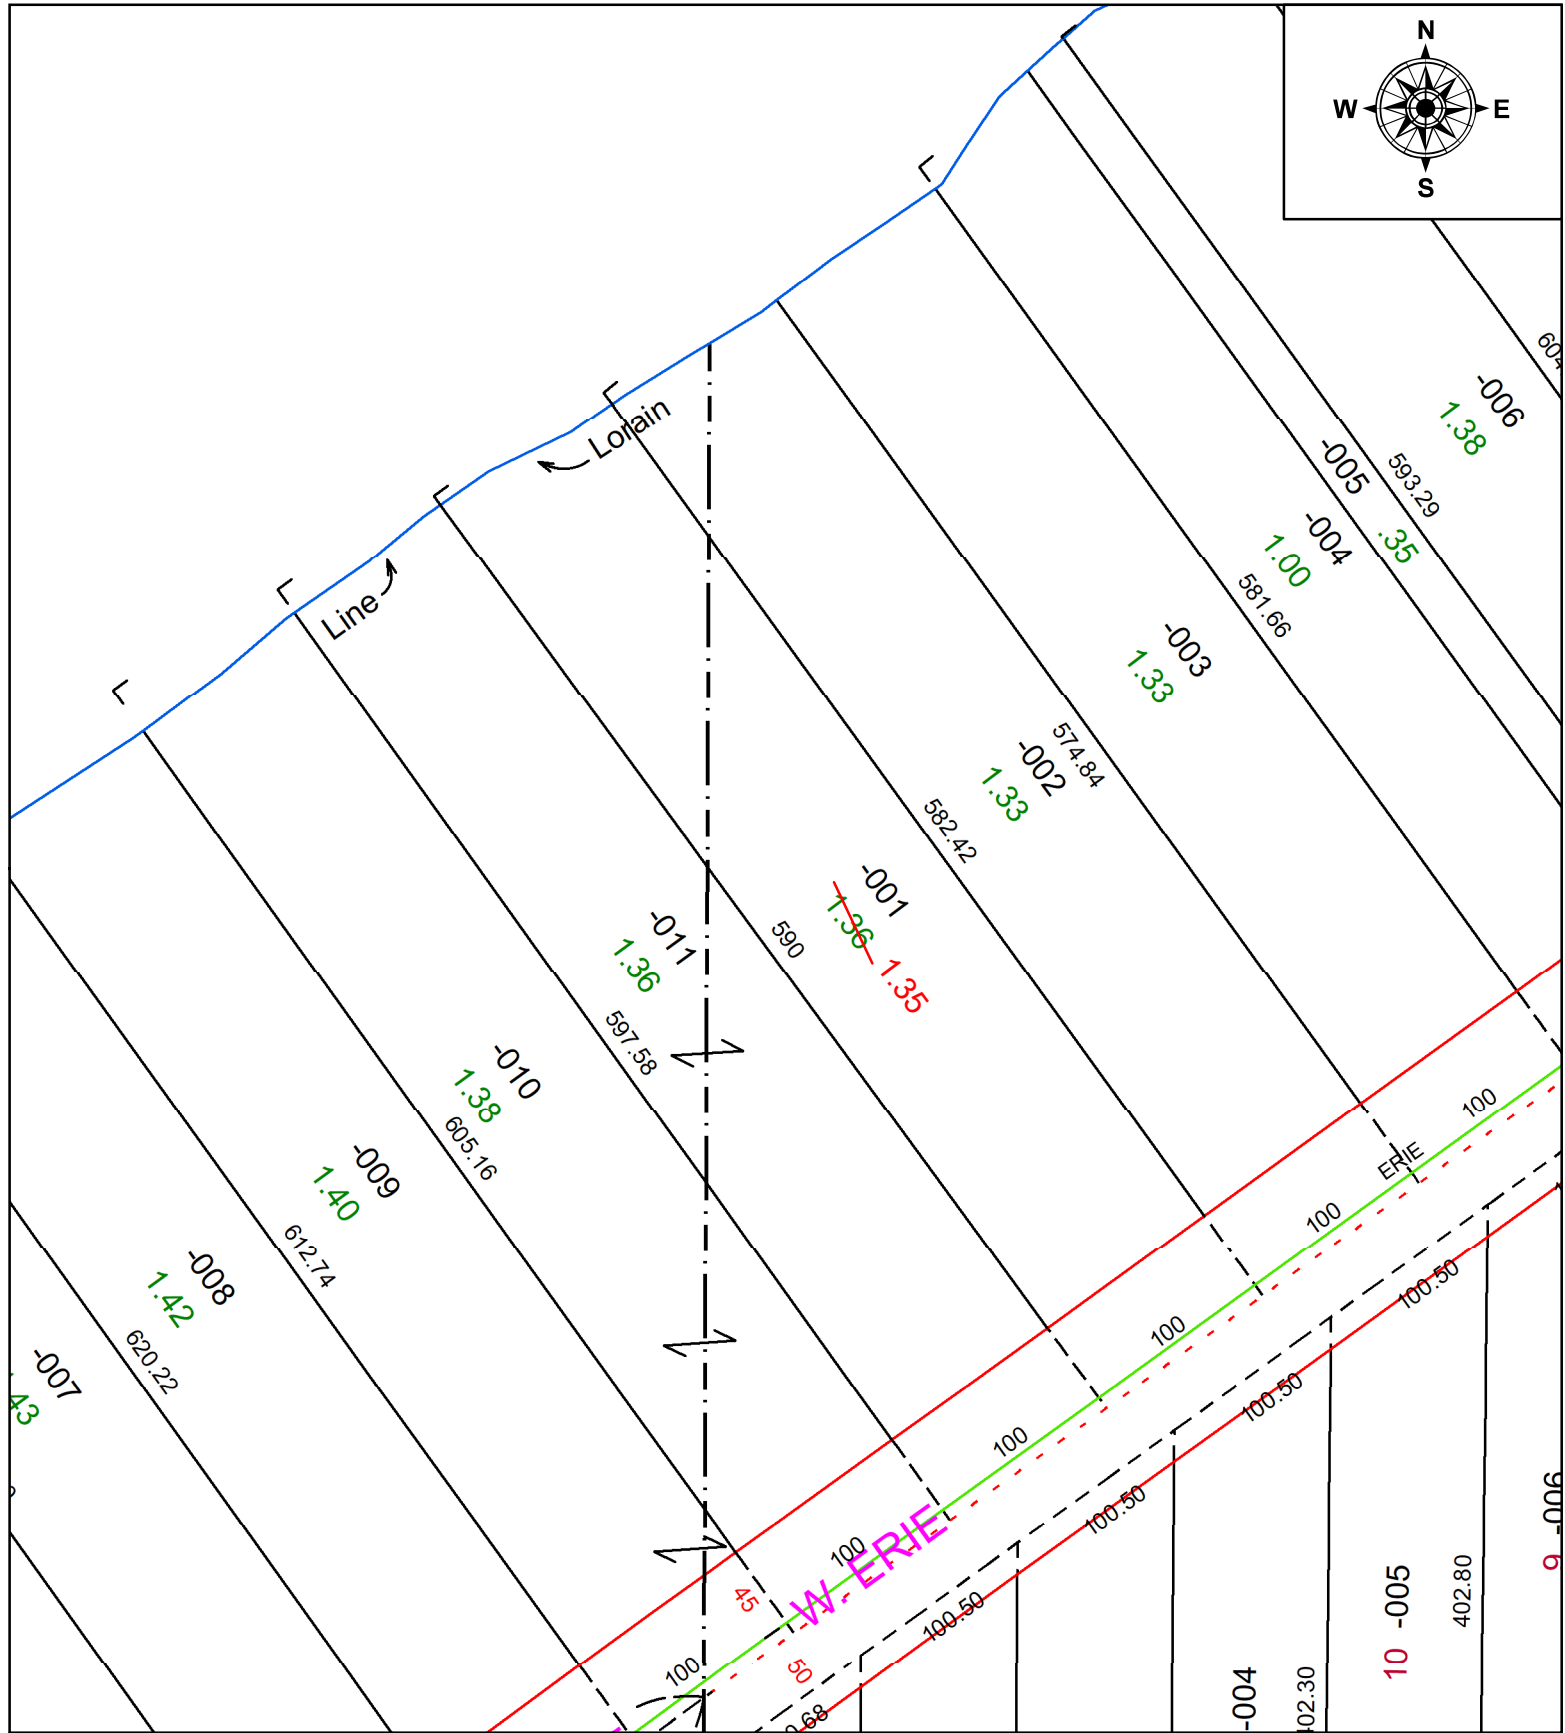


02-02-022-101-001

AC CORR PER PIOR 1996-0387412

C/L OF CLEVELAND-SANDUSKY RD AND SE CORNER OF PARCEL

25-05481-C

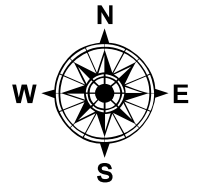

SPLITS/DEEDS PROCESSED

LORAIN COUNTY TAX MAP DEPARTMENT
226 MIDDLE AVE. ELYRIA, OH

N/A

SURVEY #: N/A

1: 345592

0500026

BB **DATE:** 4/9/2025

$$1'' = \overline{100}$$

PRIOR INSTRUMENT: #1996-0387412