
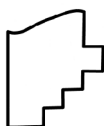
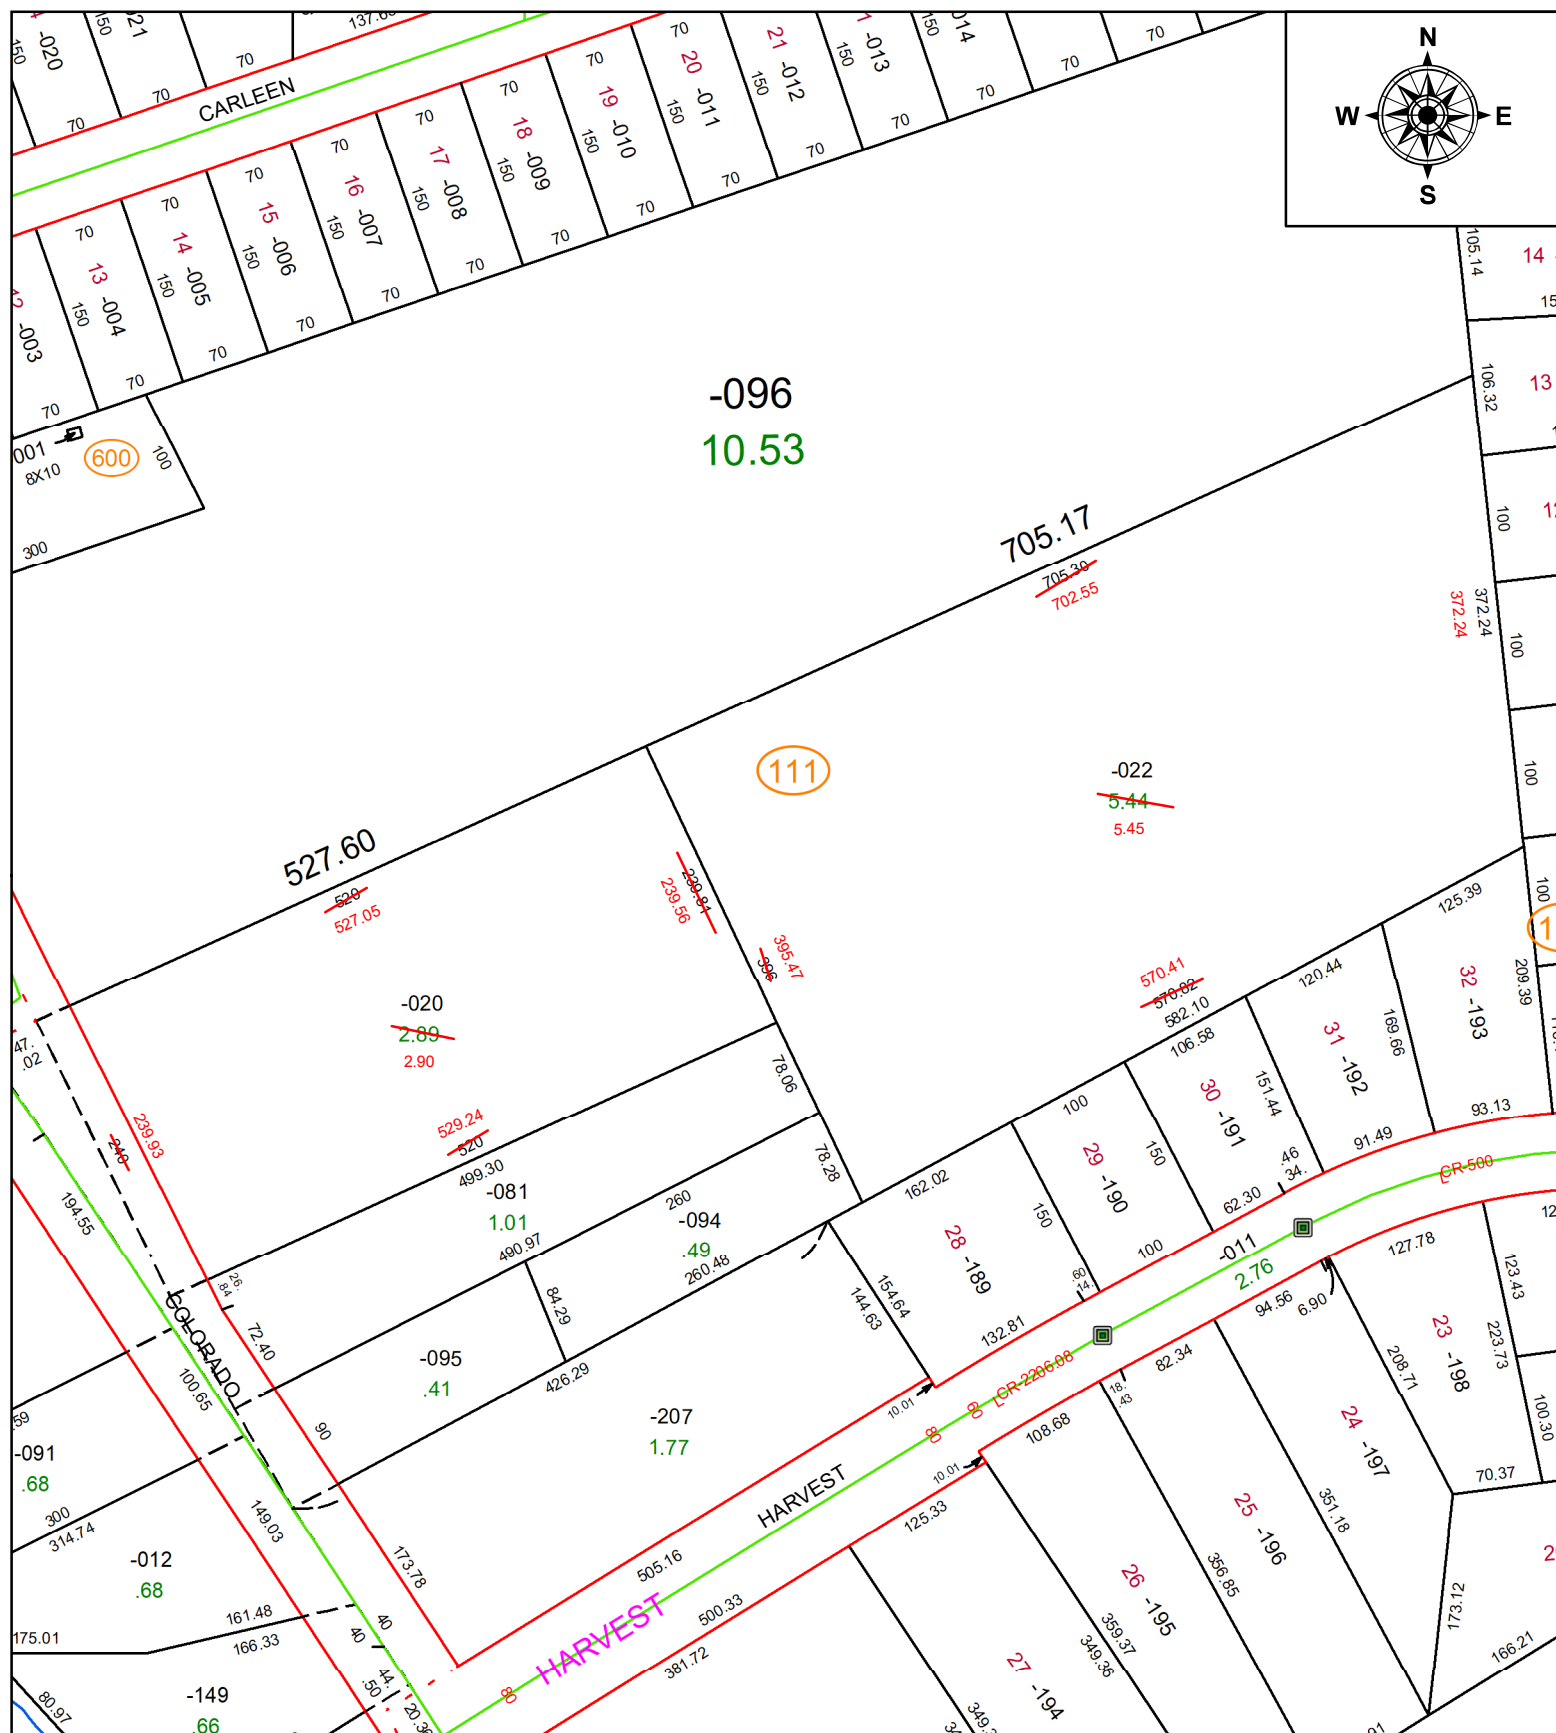


PARENT PARCEL: 04-00-010-111-020 & -022

CHILD PARCEL: AC CORR PER SURVEYOR AMY M. KELLY

STARTING POINT: C/L OF COLORADO AVE AND SOUTH LINE OF EATON SUBDIVISION

25-05490-A

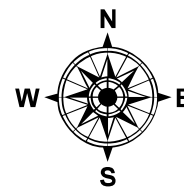

SPLITS/DEEDS PROCESSED

LORAIN COUNTY TAX MAP DEPARTMENT
226 MIDDLE AVE. ELYRIA, OH

SURVEYED BY: AMY M. KELLY

SURVEY #: 51430

CLOSURE: 1: 324539

MAP PAGE(S): 0400010

APPROVED BY: BB **DATE:** 4/21/2025

SCALE: 1" = 150' **PRIOR INSTRUMENT:** #20250044815