



PARENT PARCEL: 15-00-009-000-016
CHILD PARCEL: MAP CORRECTION
STARTING POINT: C/L OF STEWART RD AND NW CORNER PER INSTRUMENT 2013-0484610

25-05495-C

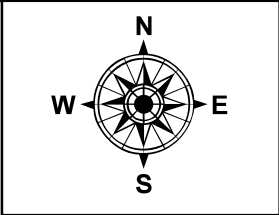

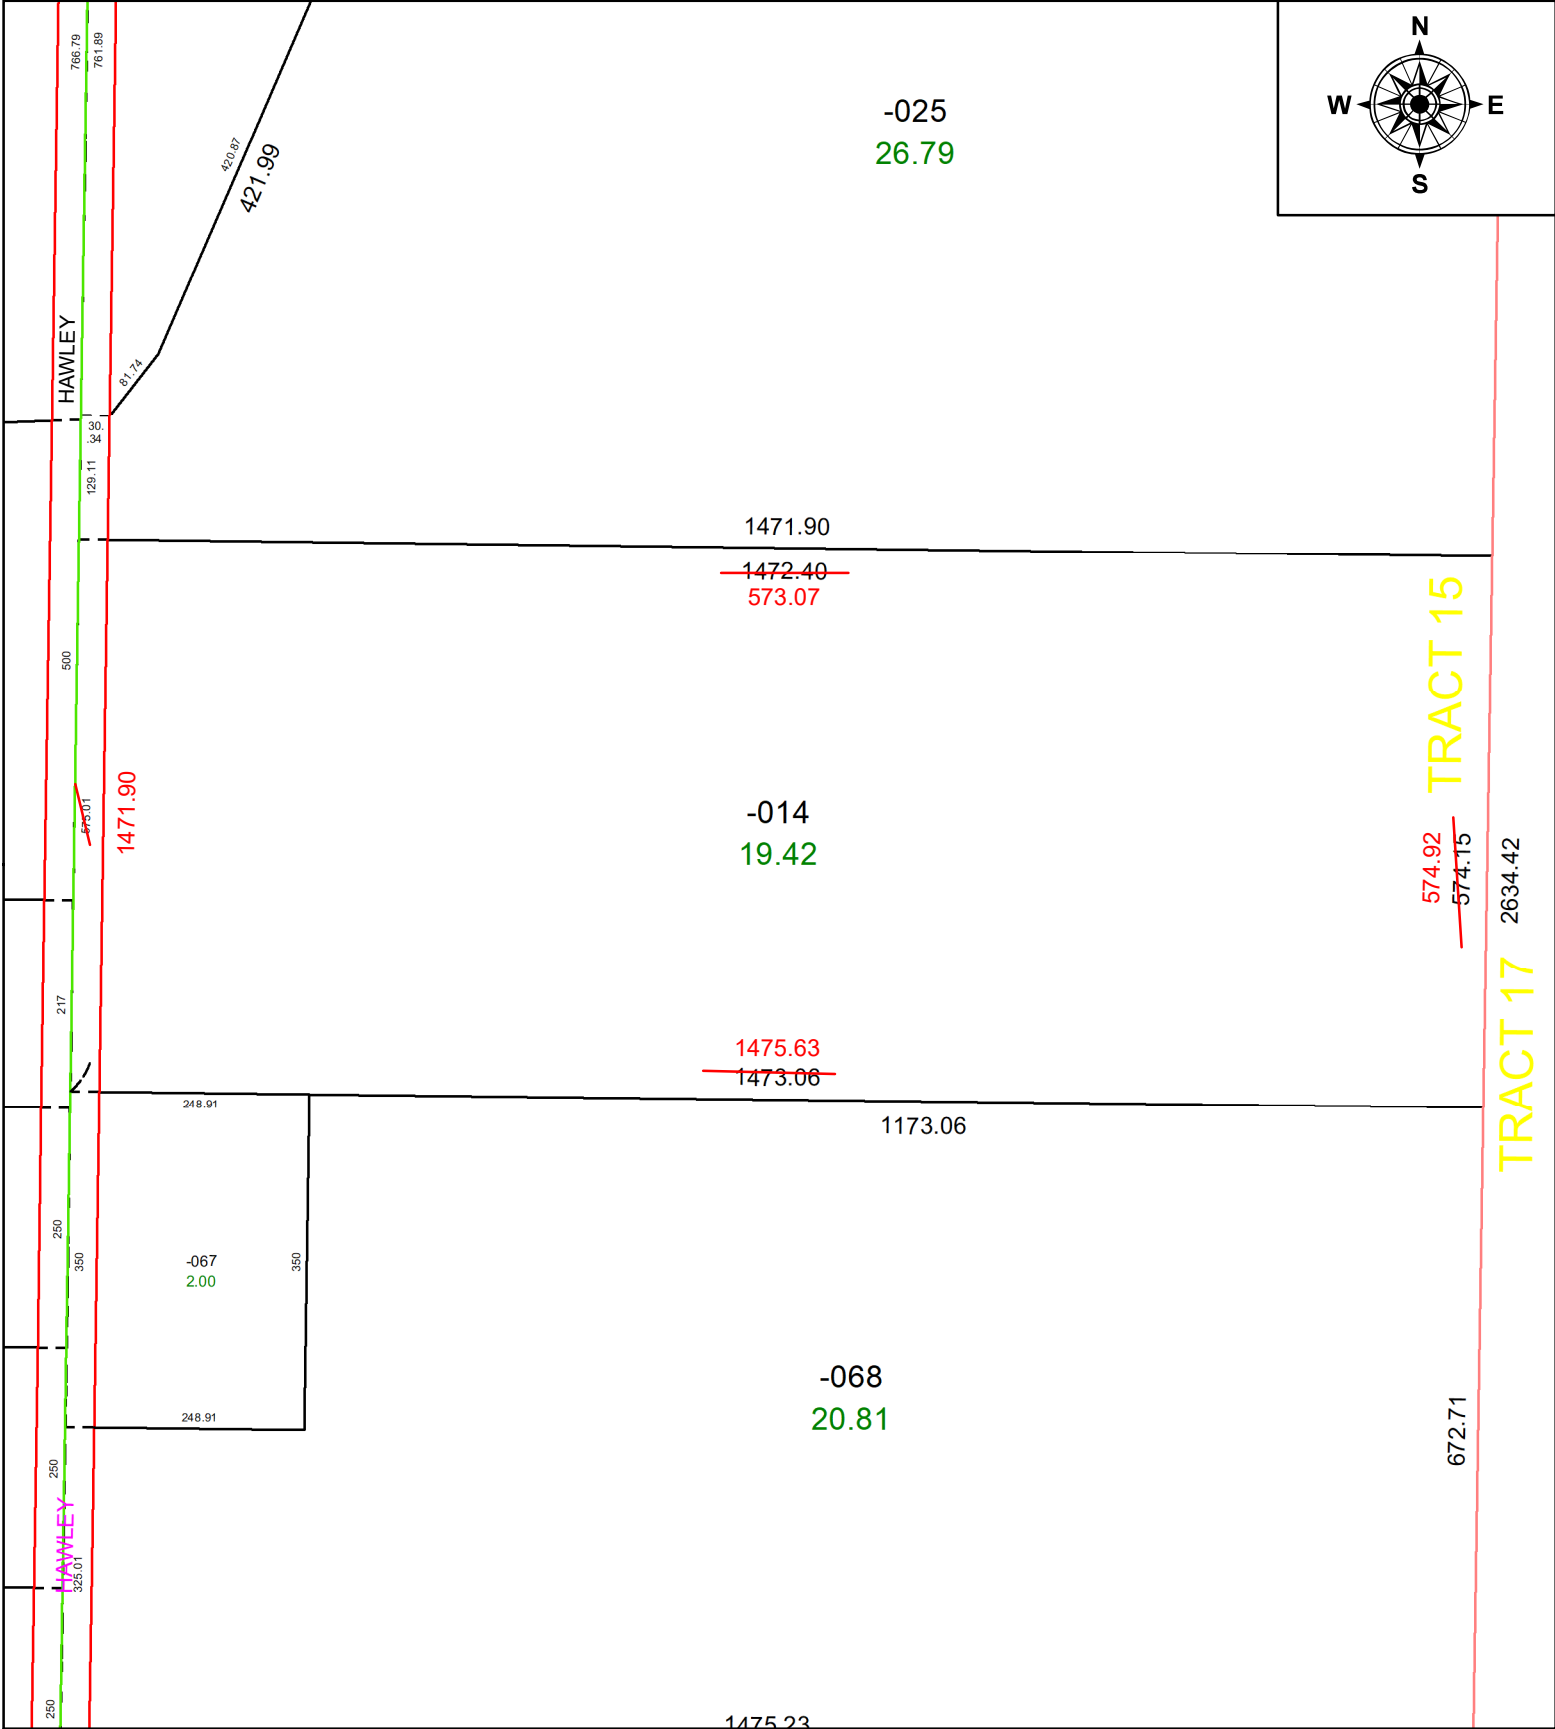

SPLITS/DEEDS PROCESSED
LORAIN COUNTY TAX MAP DEPARTMENT
226 MIDDLE AVE. ELYRIA, OH

SURVEYED BY:	TIMOTHY D. HOZALSKI	SURVEY #:	51436
CLOSURE:	1: 1153053		
MAP PAGE(S):	2115000		
APPROVED BY:	BB	DATE:	4/29/2025
SCALE:	1" = 200'	PRIOR INSTRUMENT:	#20250049168