
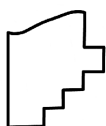
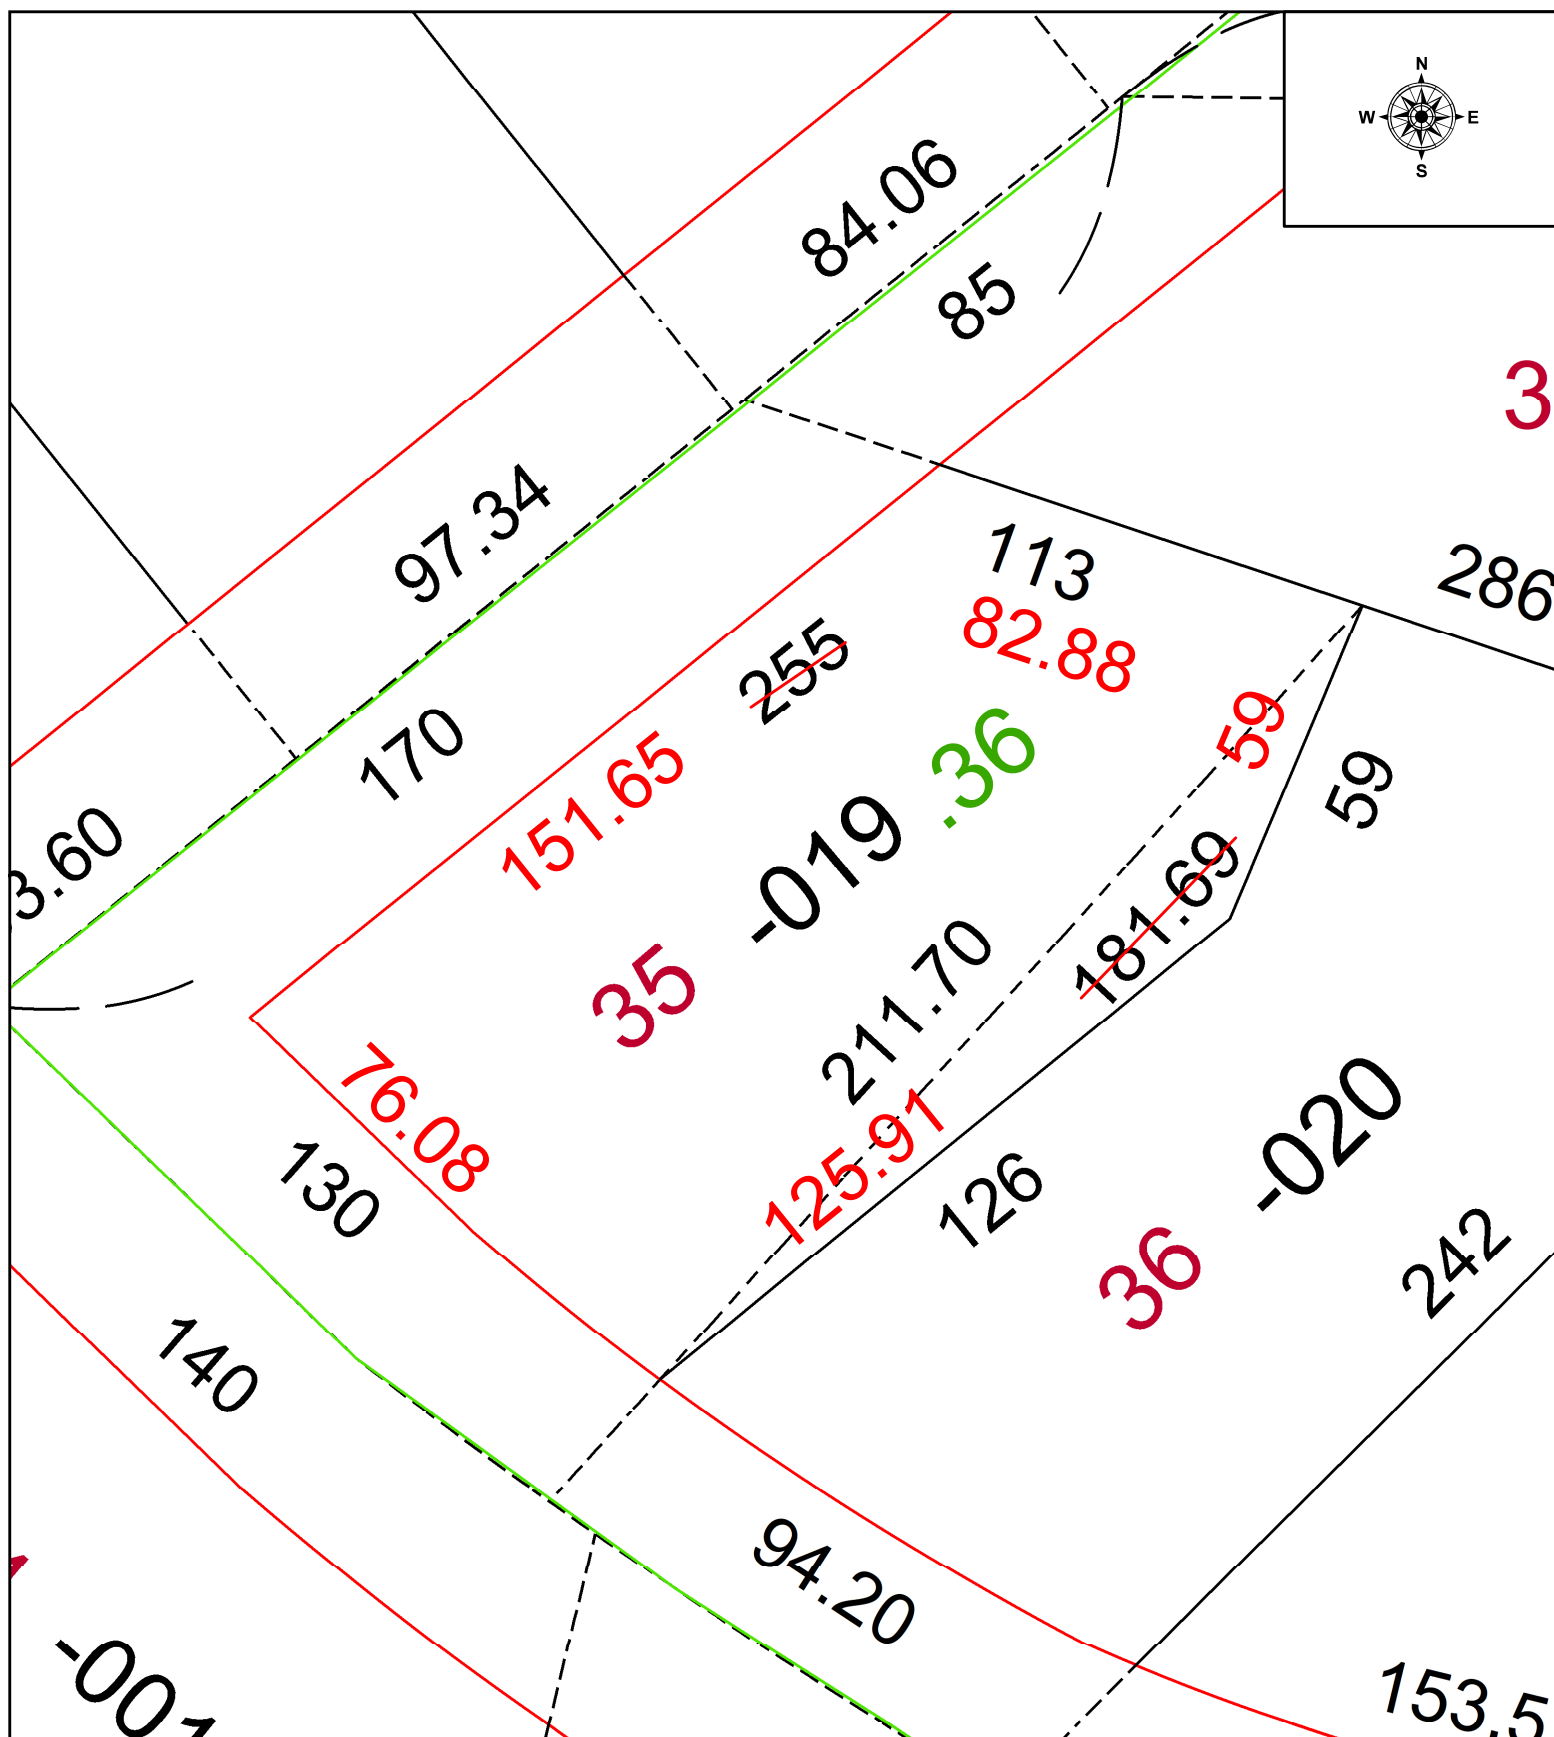


07-00-025-104-019

FR & DPTH TO AC CORR PER SURVEYOR RONALD HINTON

INTERSECTION OF SOUTHEASTERLY CORNER OF S/L 36 & NORTH LINE OF HEDGEROW PARK DR

25-05503-C

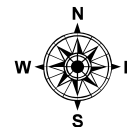

SPLITS/DEEDS PROCESSED

LORAIN COUNTY TAX MAP DEPARTMENT
226 MIDDLE AVE. ELYRIA, OH

RONALD HINTON

SURVEY # 51447

1: 91423

07-00-025

DATE: 5/12/2025

PRIOR INSTRUMENT: #2019-0702641