
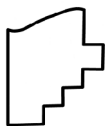


STARTING POINT: SE CORNER OF GETRUDE NEUSEUS ADDITION

25-05507-C

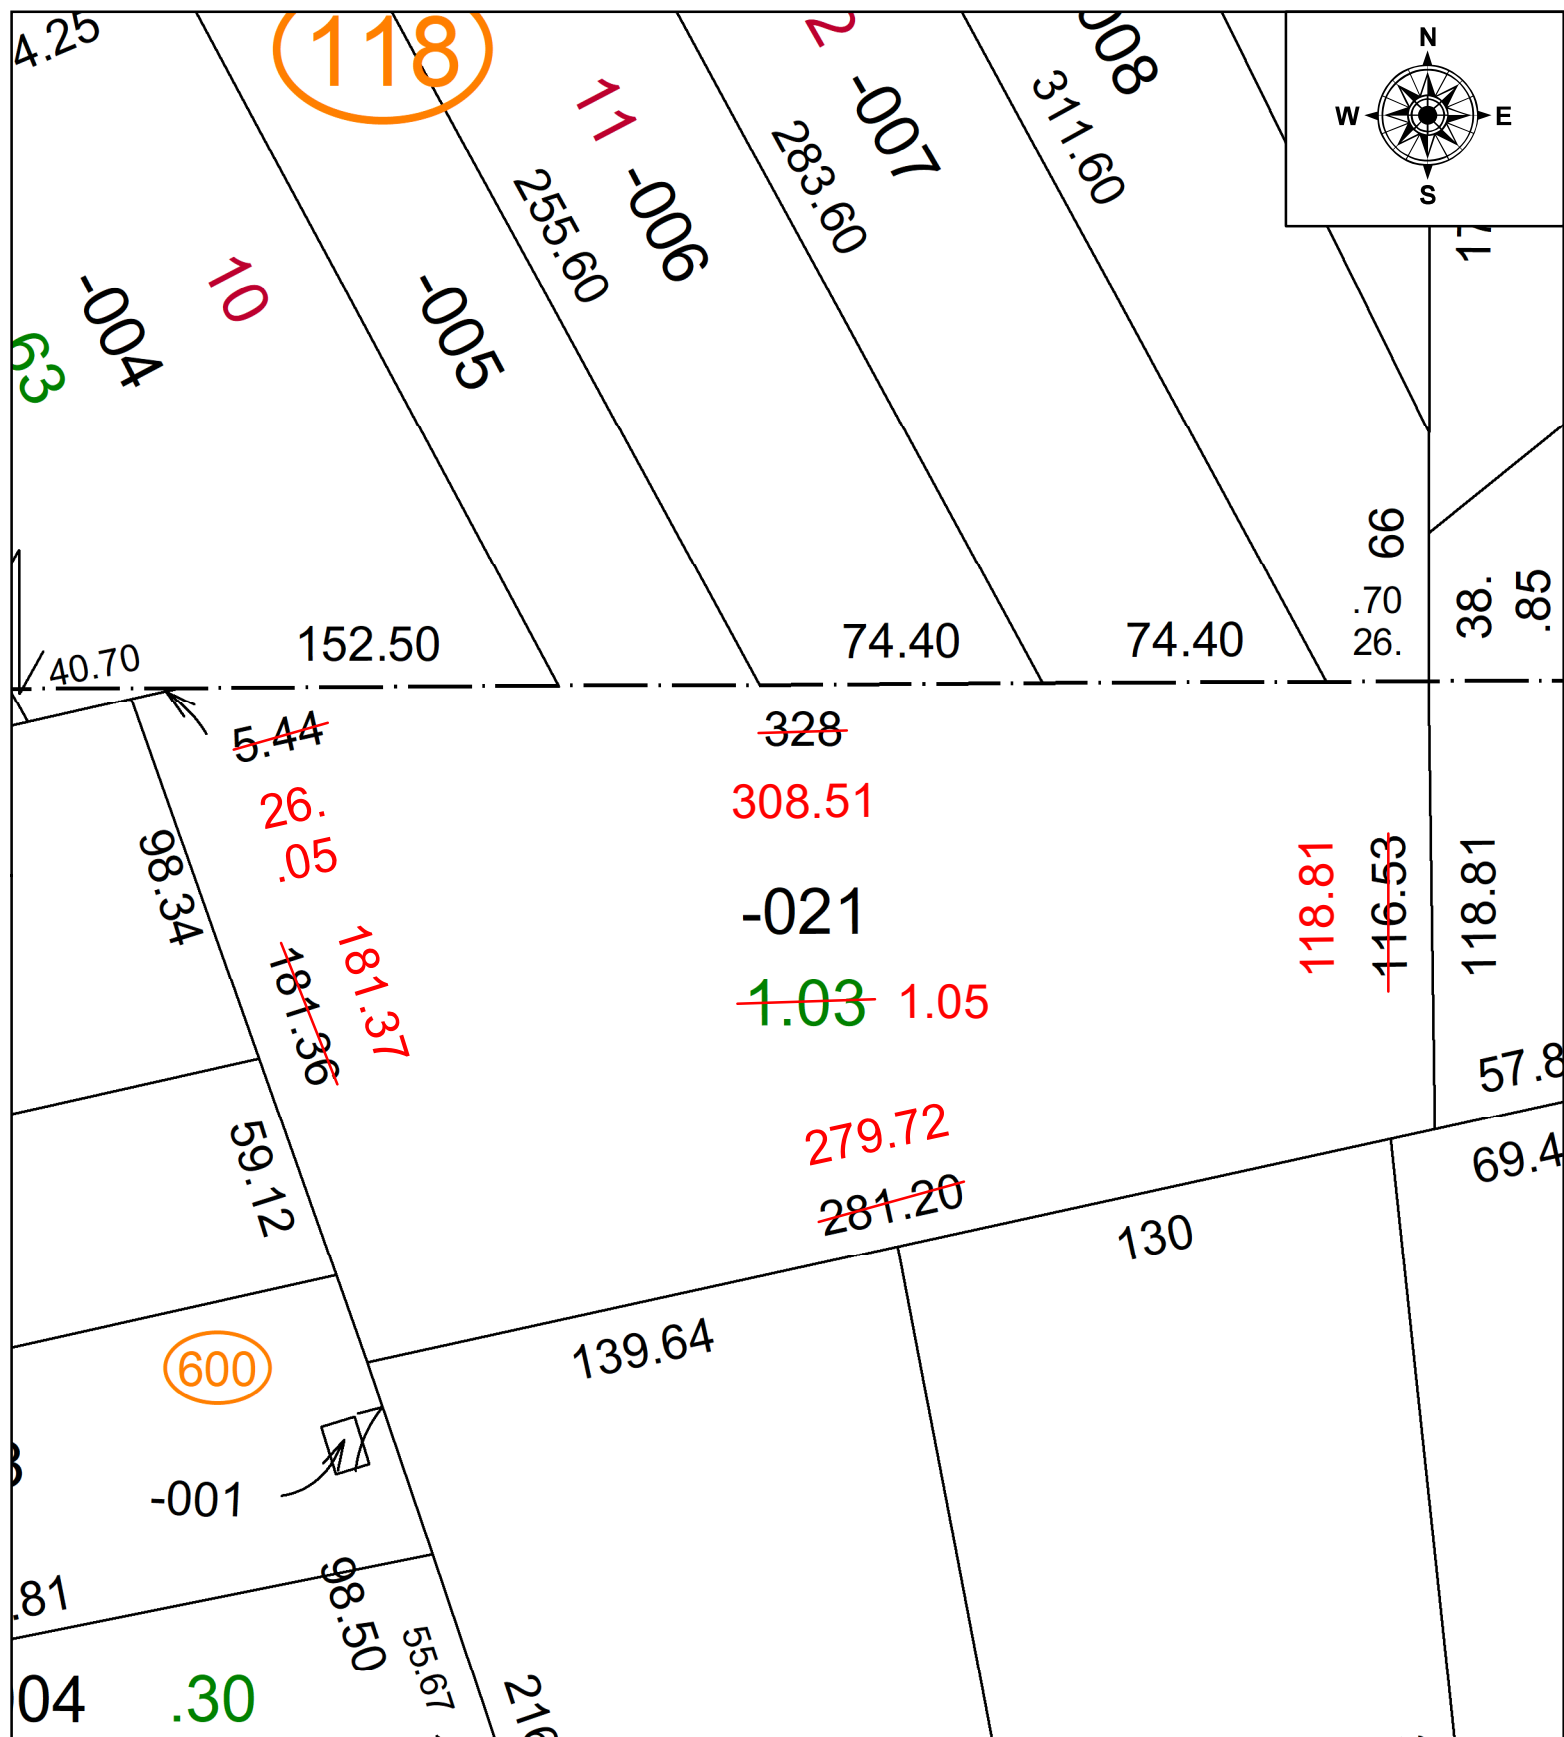

SPLITS/DEEDS PROCESSED

LORAIN COUNTY TAX MAP DEPARTMENT
226 MIDDLE AVE. ELYRIA, OH

SURVEYED BY: AMY M. KELLY

SURV # 51450

CLOSURE: 1: 279365

MAP PAGE(S): 04-00-011

APPROVED BY: AC **DATE:** May 19, 2025

SCALE: 1 in = 50 ft

PRIOR INSTRUMENT: 2008- 0248789