
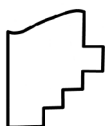
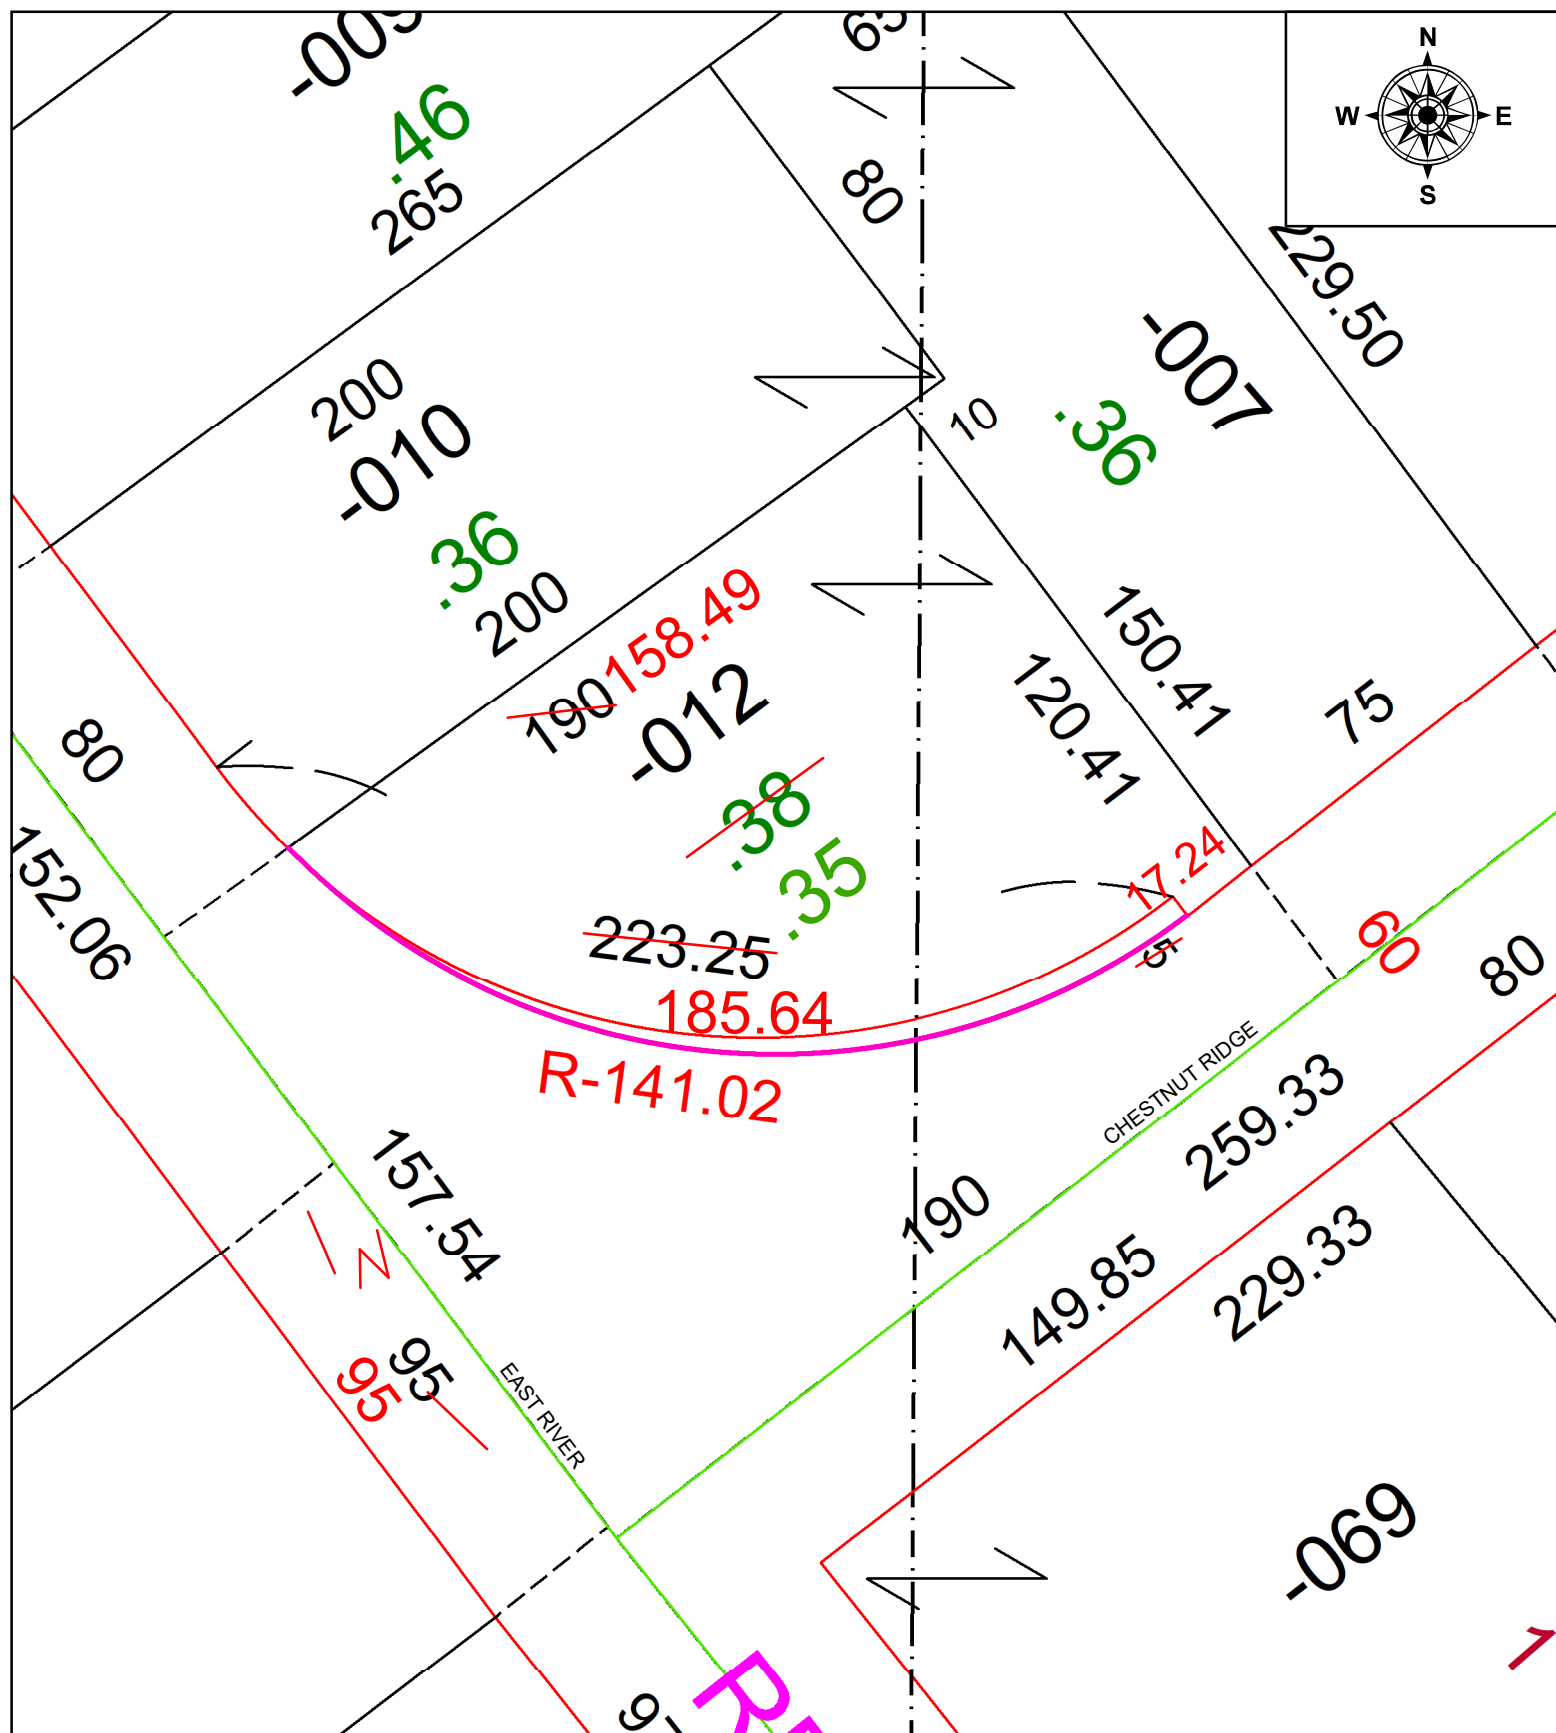


10-00-004-143-012

AC CORR PER SURVEYOR WILFREDO BARBOSA

C/L IN CHESTNUT RIDGE AND EAST RIVER RD

25-05572-C

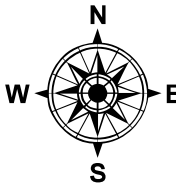

SPLITS/DEEDS PROCESSED

LORAIN COUNTY TAX MAP DEPARTMENT
226 MIDDLE AVE. ELYRIA, OH

SURVEYED BY: WILFREDO BARBOSA

SURVEY #: 51511

CLOSURE: 1: 235415

MAP PAGE(S): 05-00-025

APPROVED BY: BB **DATE:** 8/28/2025

SCALE: 1" = 40'

PRIOR INSTRUMENT:

#20250046247