

PARENT PARCEL: 05-00-046-000-041 & -023 & -034 & -040 & -042 & -032 AND 05-00-047-000-023



CHILD PARCEL:

AC CORR PER SURVEYOR CHASE C. SOMMERS

25-05588-C

STARTING POINT:

INTERSECTION OF OL 34 AND 47

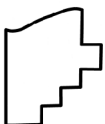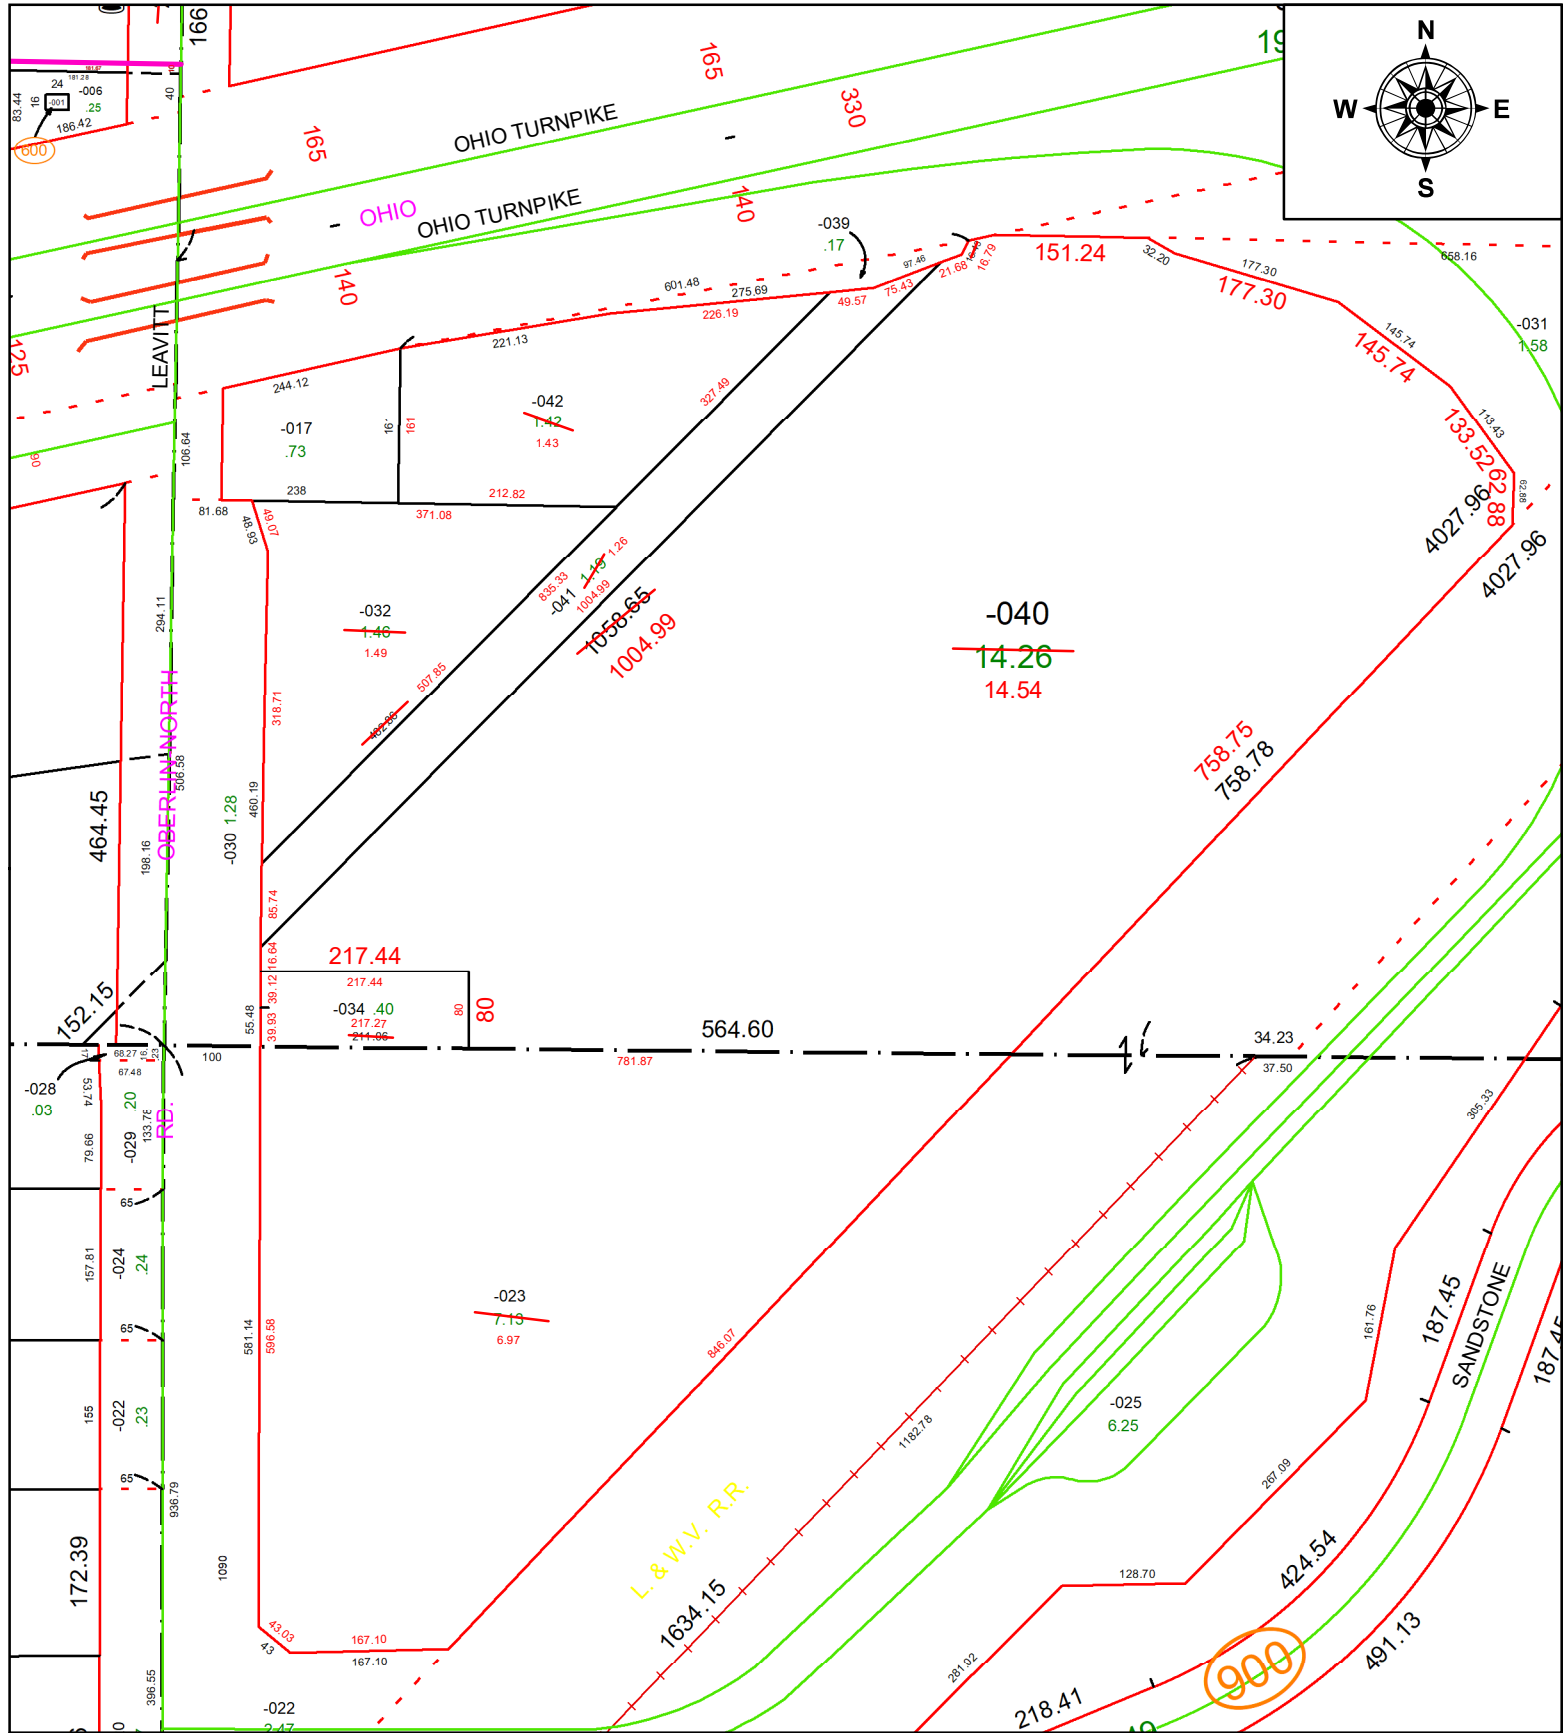

SPLITS/DEEDS PROCESSED

LORAIN COUNTY TAX MAP DEPARTMENT
226 MIDDLE AVE. ELYRIA, OH

SURVEYED BY: CHASE C. SOMMERS

SURVEY #: 51511

CLOSURE: 1: 589807

MAP PAGE(S): 05-00-046

APPROVED BY: BB DATE: 9/26/2025

SCALE: 1" = 200' PRIOR INSTRUMENT: #19970445526