
PARENT PARCEL: 06-26-019-101-031

CHILD PARCEL: FRONT & DEPTH TO AC CORR PER SURV BY ROBERT M. RUFFING

STARTING POINT: NE CORNER OF S/L 9 AND NW CORNER OF S/L 8 IN N.B. GATES SUB

N

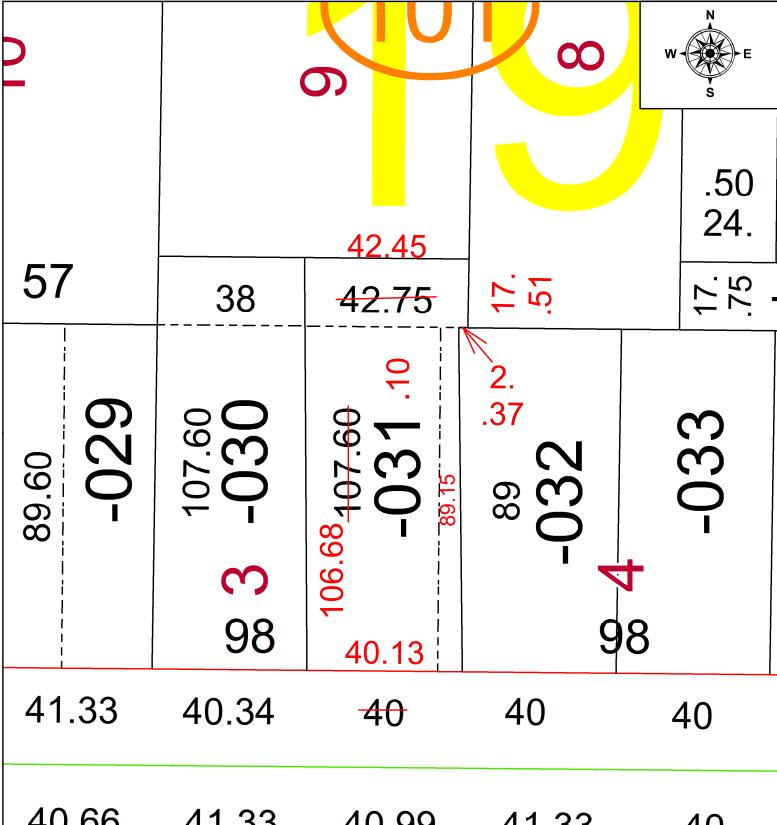

40.66 41.33 40.99 41.33 40

SPLITS LORAIN COU

SPLITS/DEEDS PROCESSED

LORAIN COUNTY TAX MAP DEPARTMENT 226 MIDDLE AVE. ELYRIA, OH

SURVEYED BY:	ROBERT	M. RUFFIN	ıg su	SURV # 51555	
CLOSURE:	1: 51937				
MAP PAGE(S):	06-26				
APPOVED BY:	AC	DATE:	October 01, 2025		
SCALE: 1 in =	25 ft	PRIOR I	NSTRUMENT:	2024- 0000305	