
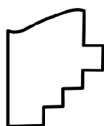


04-00-017-103-031

AC CORR PER SURVEYOR SEAN BOLAND

STARTING POINT: MON. BOX @ INTERSECTION OF C/LS OF WALKER RD & AVON-BELDEN RD

25-05597-C

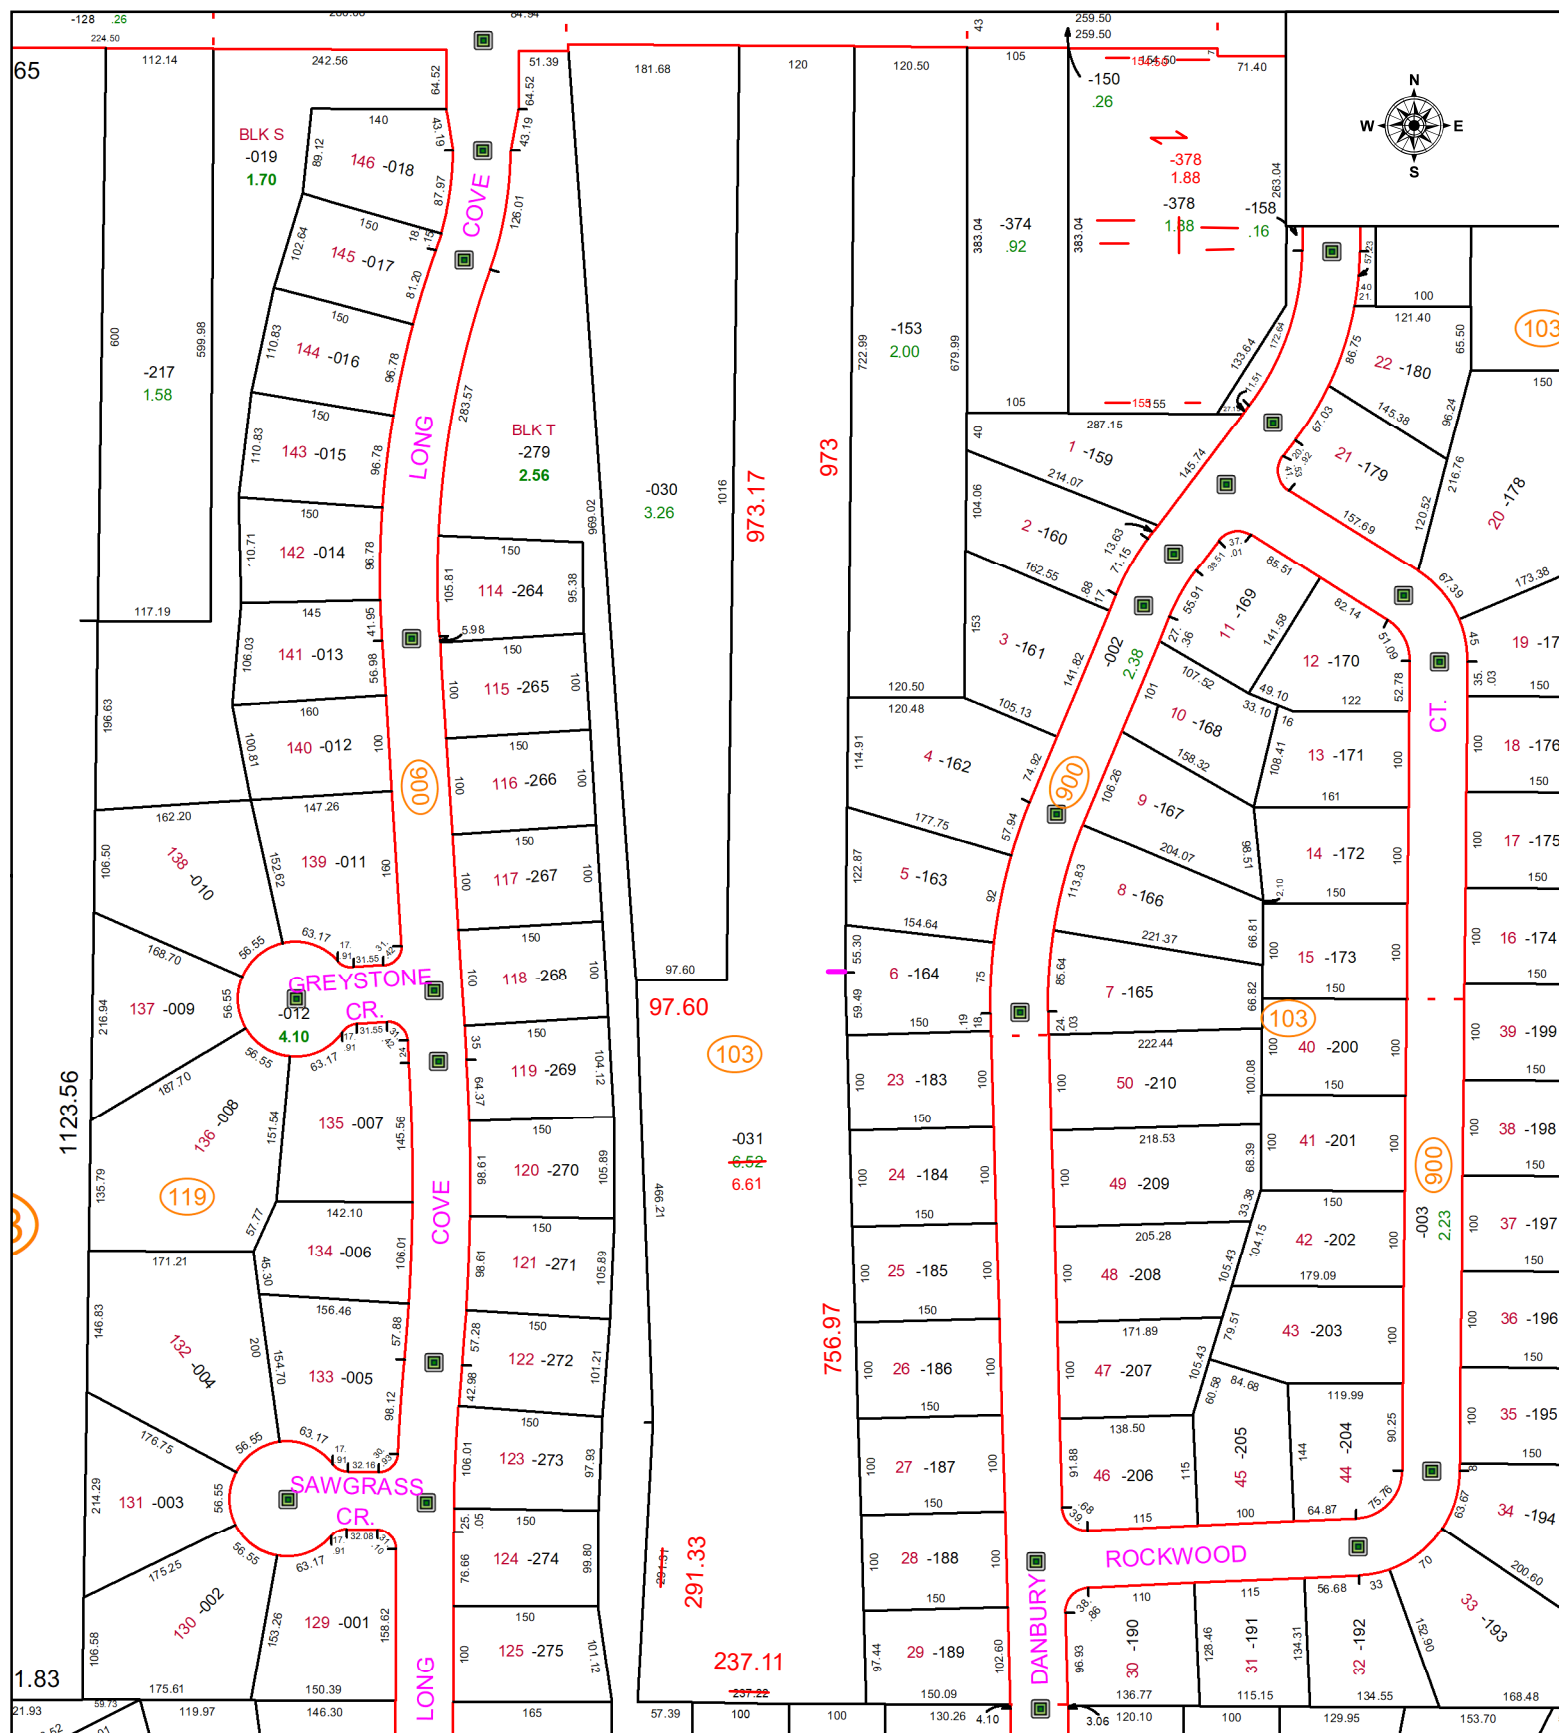

SPLITS/DEEDS PROCESSED

LORAIN COUNTY TAX MAP DEPARTMENT
226 MIDDLE AVE. ELYRIA, OH

SURVEYED BY: SEAN BOLAND

SURVEY # 51566

CLOSURE: 1: 103701

MAP PAGE(S): 04-00-017

APPROVED BY: WRZ **DATE:** 10/9/2025

SCALE: 1" = 200' **PRIOR INSTRUMENT:** #2025-0048134