
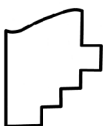


09-00-098-000-046

AC CORR PER SURVEYOR TIMOTHY HOZALSKI

MON. BOX @ INTERSECTION OF C/LS OF OBERLIN RD & PARSONS RD

25-05598-C

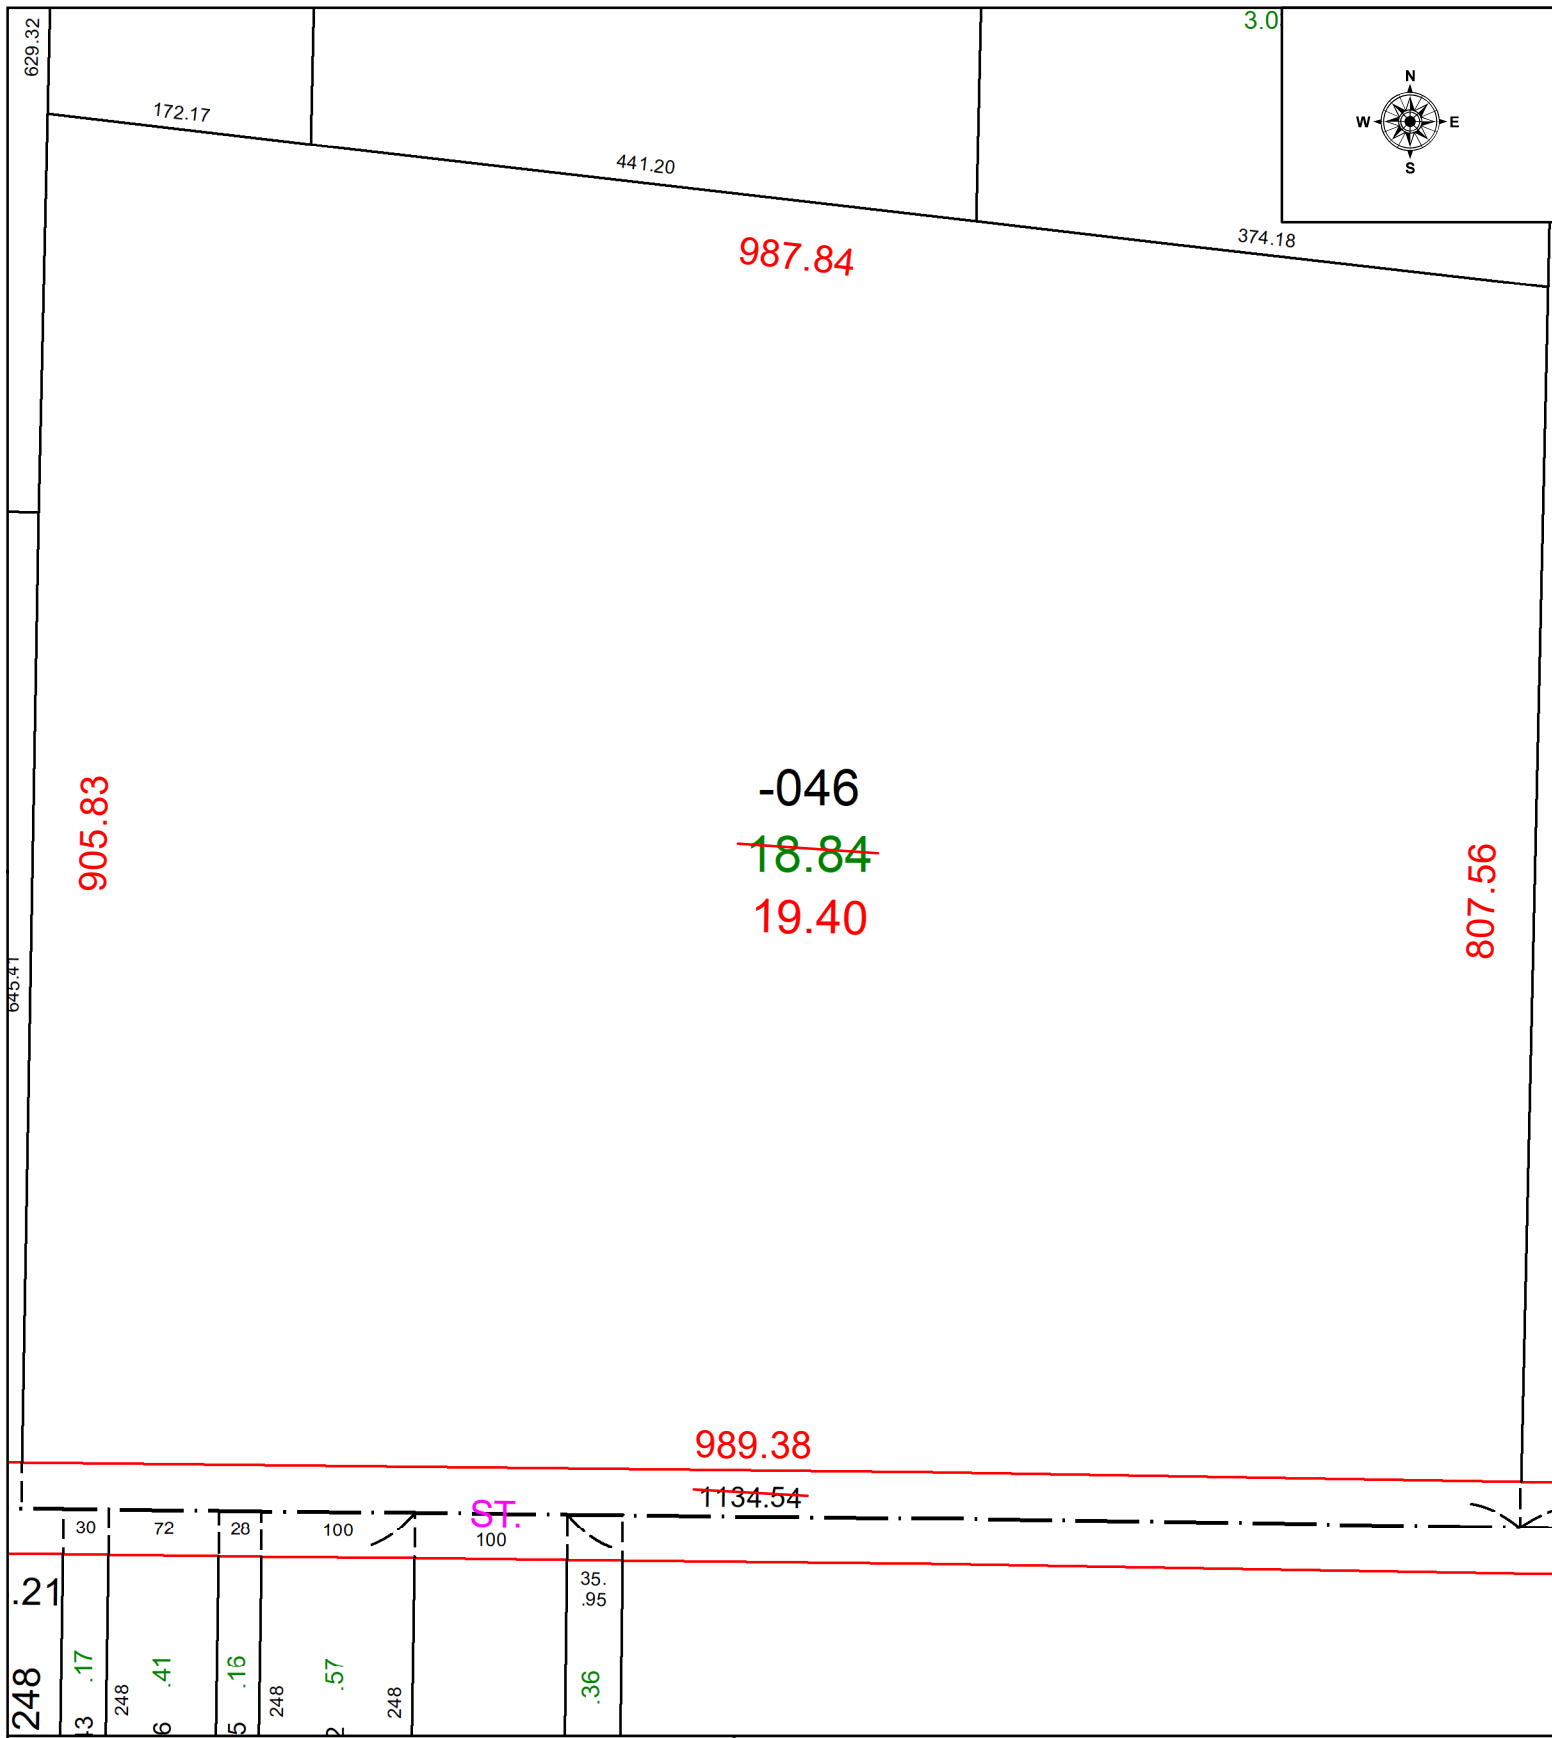

SPLITS/DEEDS PROCESSED

LORAIN COUNTY TAX MAP DEPARTMENT
226 MIDDLE AVE. ELYRIA, OH

SURVEYED BY: TIMOTHY HOZALSKI

SURVEY # 51565

CLOSURE: 1: 1099205

MAP PAGE(S): 09-00-098

APPROVED BY: WRZ **DATE:** 10/9/2025

SCALE: 1" = 125' **PRIOR INSTRUMENT:** #2025-0064666