

PARENT PARCEL:

PARENT PARCEL:




CHILD PARCEL: .

CHILD PARCEL: .

STARTING POINT:

STARTING POINT:

25-05608-C

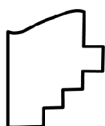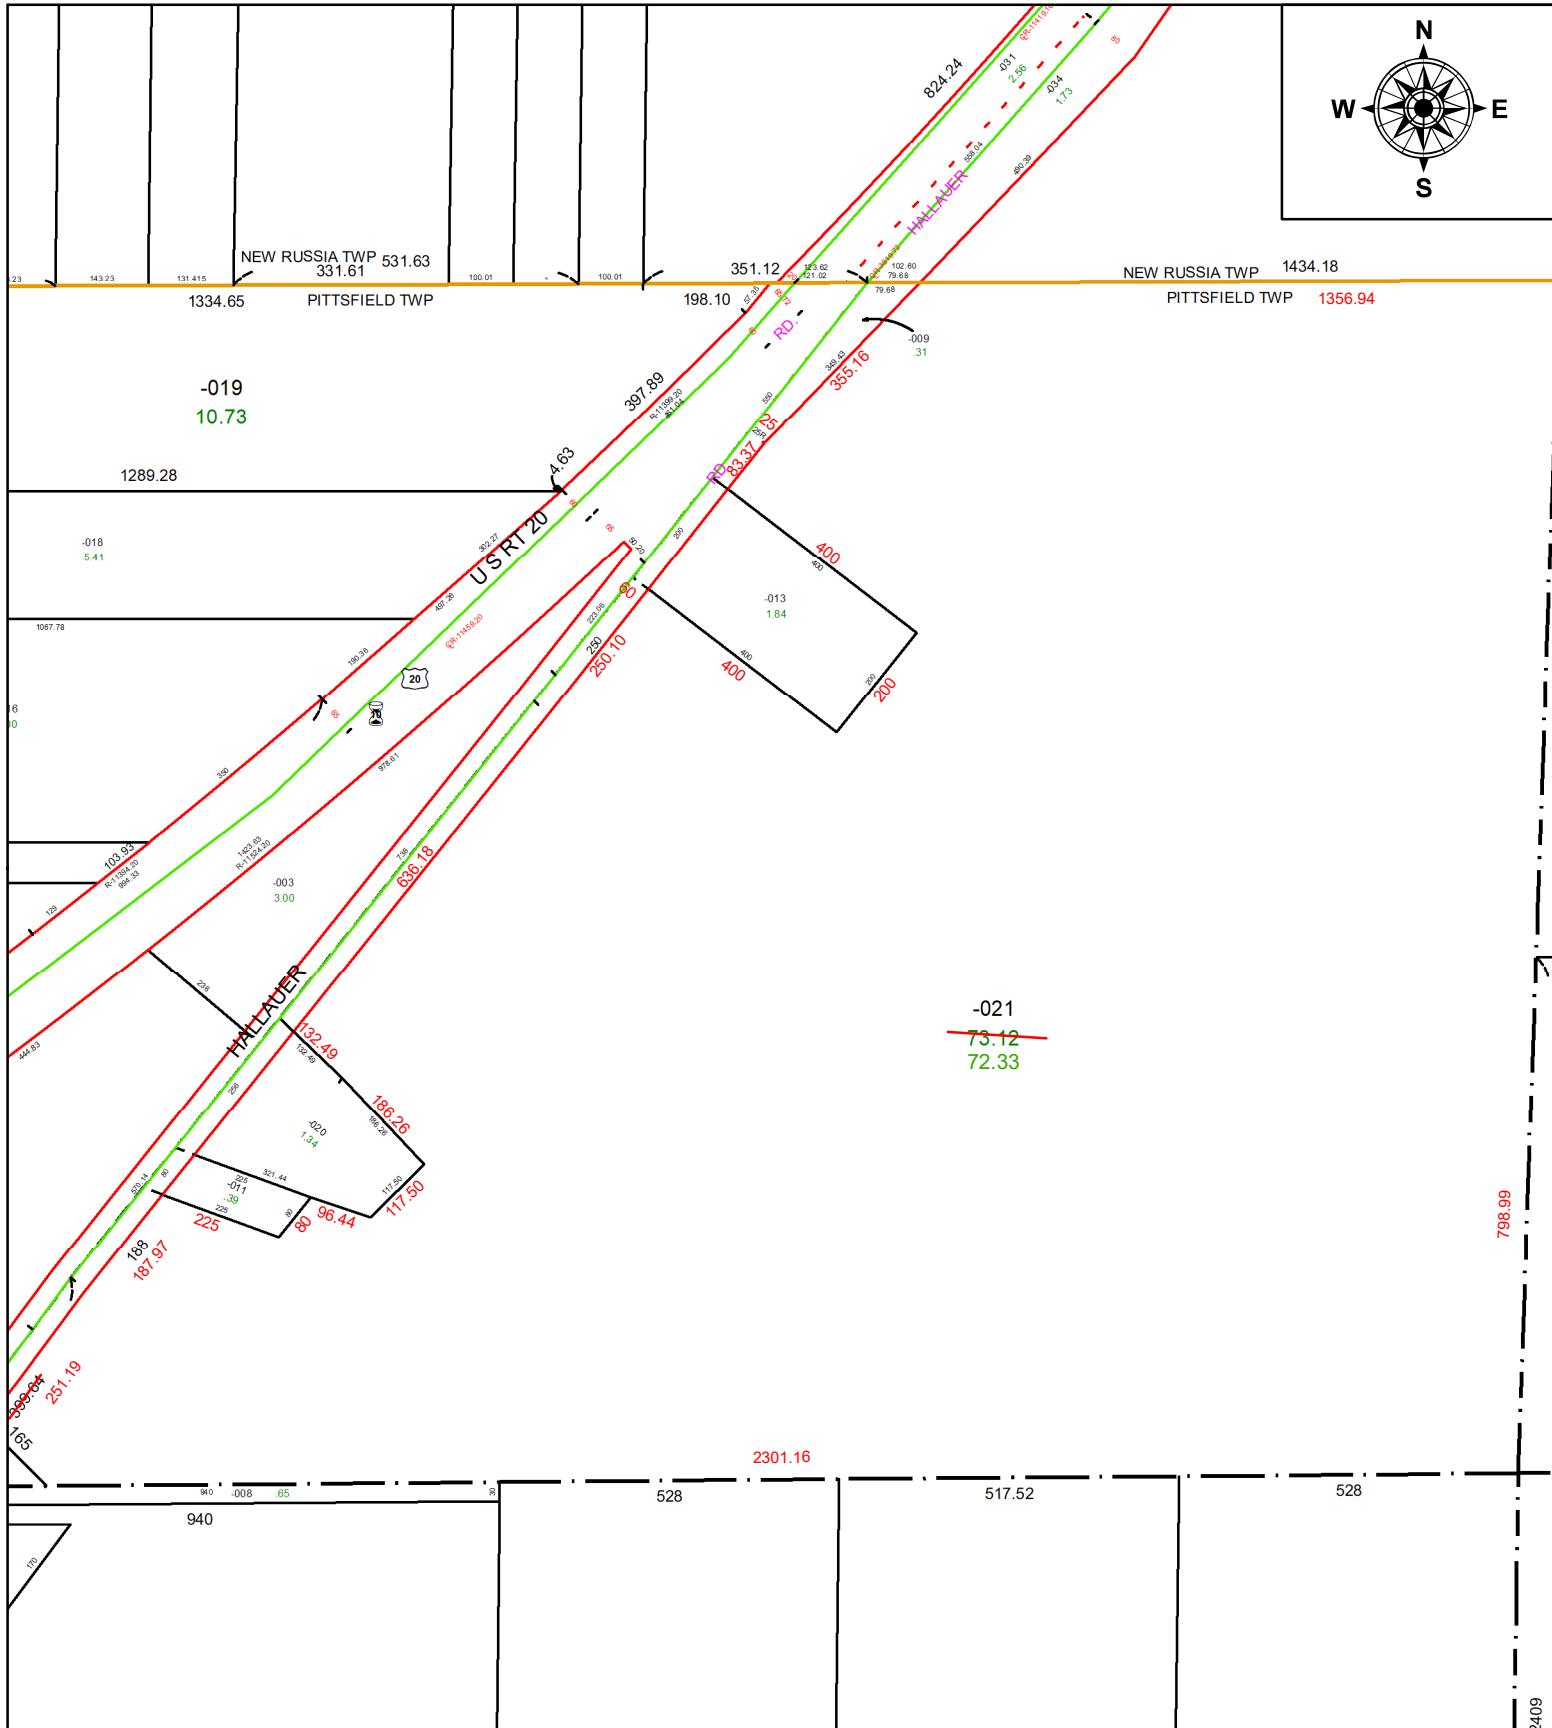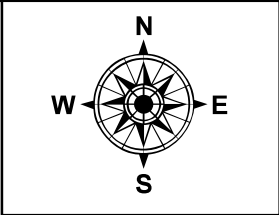

SPLITS/DEEDS PROCESSED

LORAIN COUNTY TAX MAP DEPARTMENT
226 MIDDLE AVE. ELYRIA, OH

SURVEYED BY: JOSHUA S. RIEDY

SURVEY #: 51578

CLOSURE: 1:102527

MAP PAGE(S): 14-00-003

APPROVED BY: BB **DATE:** 10/27/2025

SCALE: 1" = 300' **PRIOR INSTRUMENT:** #20150565114