
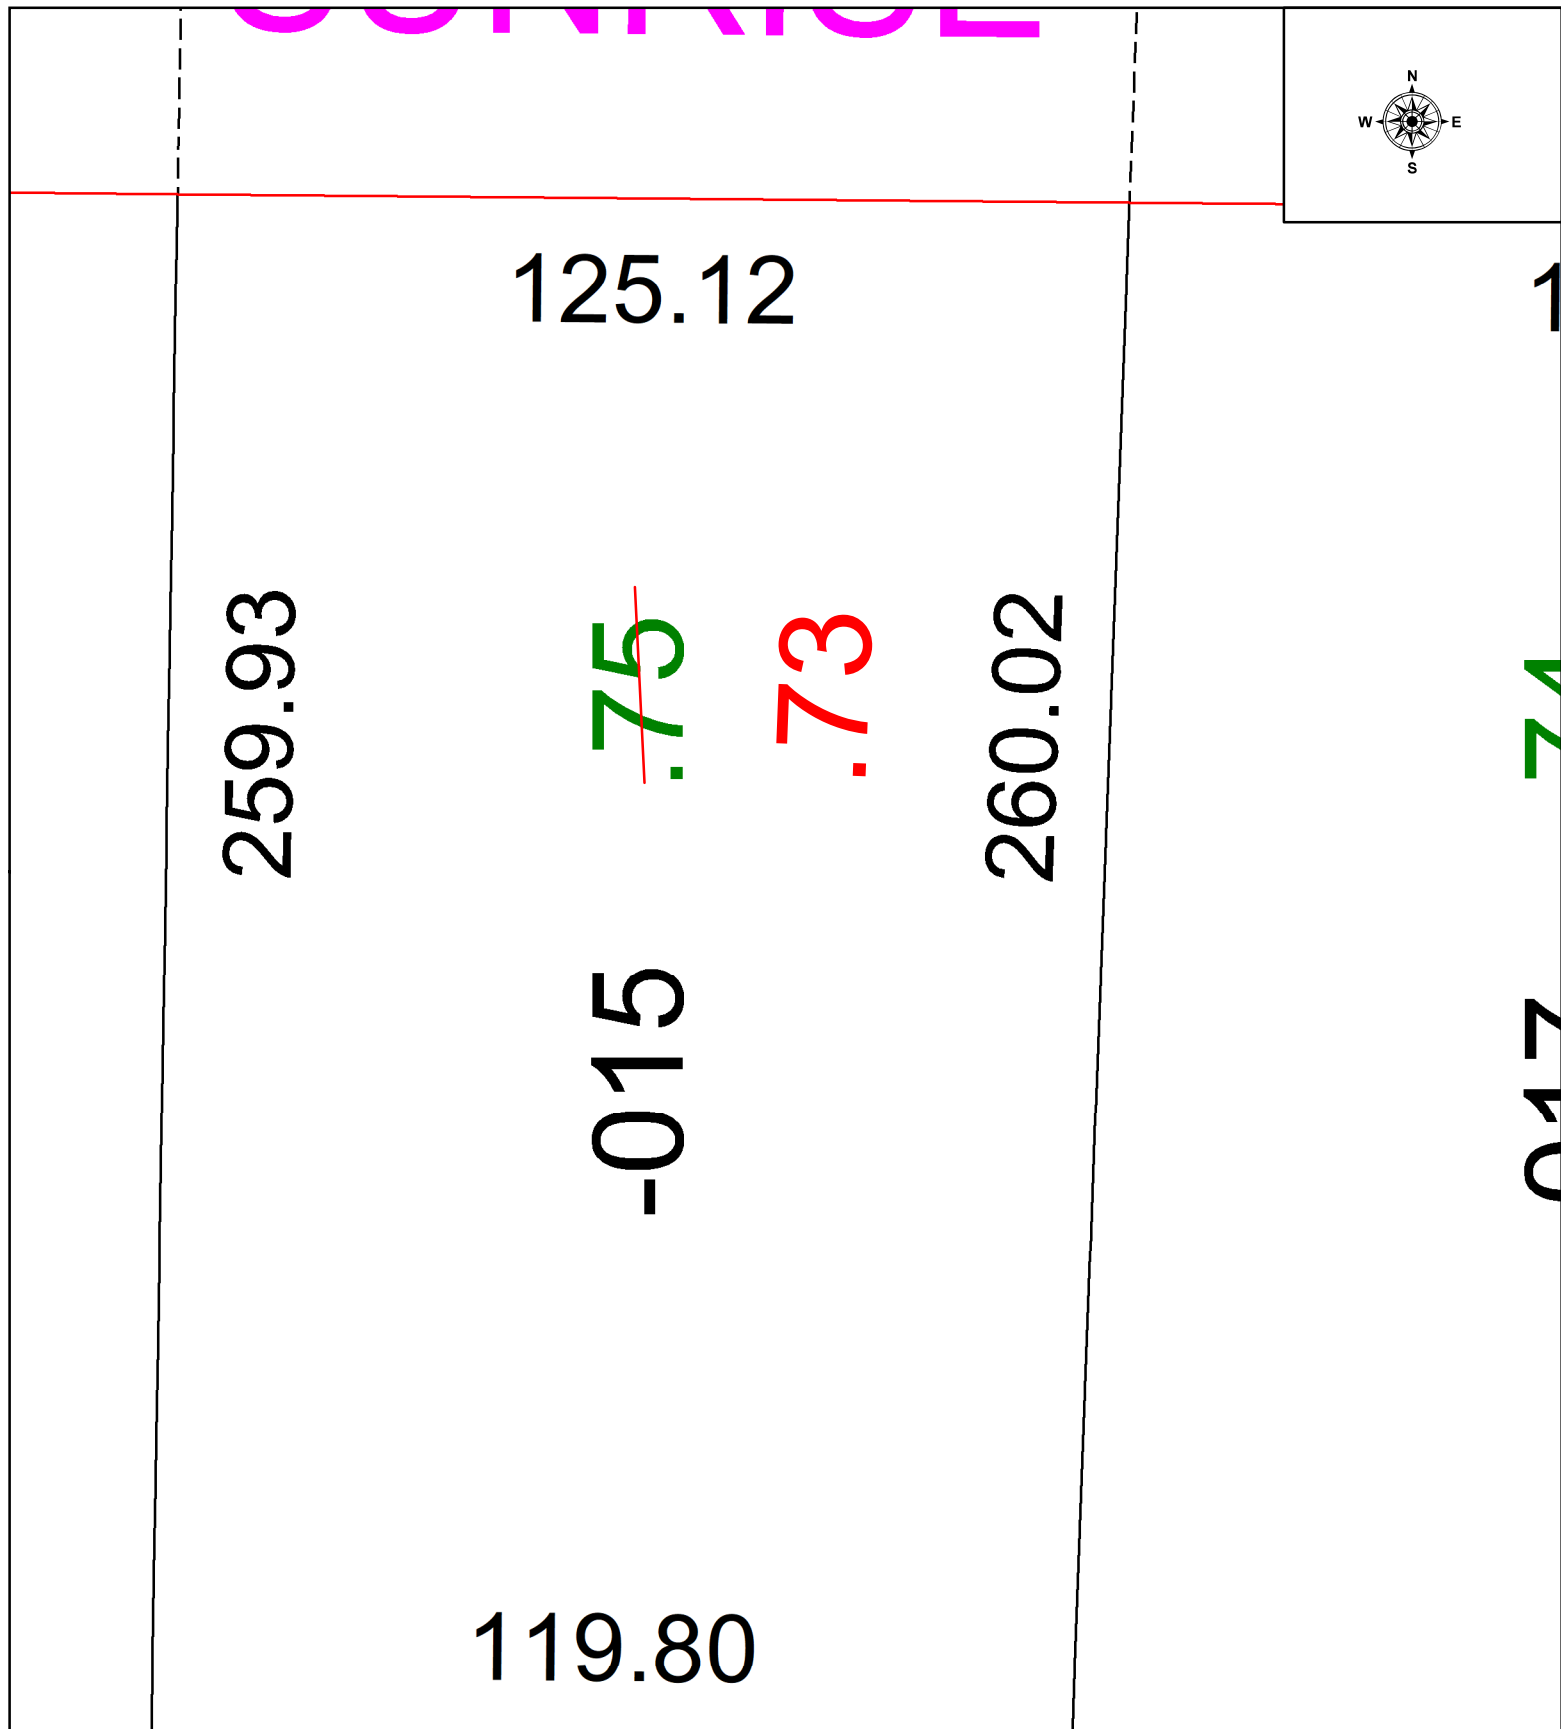


PARENT PARCEL:	05-00-039-104-015	25-05610-A
CHILD PARCEL:	AC CORR PER PRIOR DV 1409/975	
STARTING POINT:		

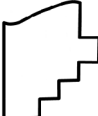

	<u>SPLITS/DEEDS PROCESSED</u>	SURVEYED BY: _____ N/A	SURVEY # N/A
	LORAIN COUNTY TAX MAP DEPARTMENT	CLOSURE: _____ 1: N/A	
	226 MIDDLE AVE. ELYRIA, OH	MAP PAGE(S): _____ 05-00-039	
		APPROVED BY: _____ WRZ	DATE: _____ 10/29/2025
		SCALE: _____ 1" = 25	PRIOR INSTRUMENT: _____ DV 1409/975