



PARENT PARCEL: 12-00-047-101-005

CHILD PARCEL: AC CORR PER SURVEYOR RONALD HINTON

STARTING POINT:

25-05611-C

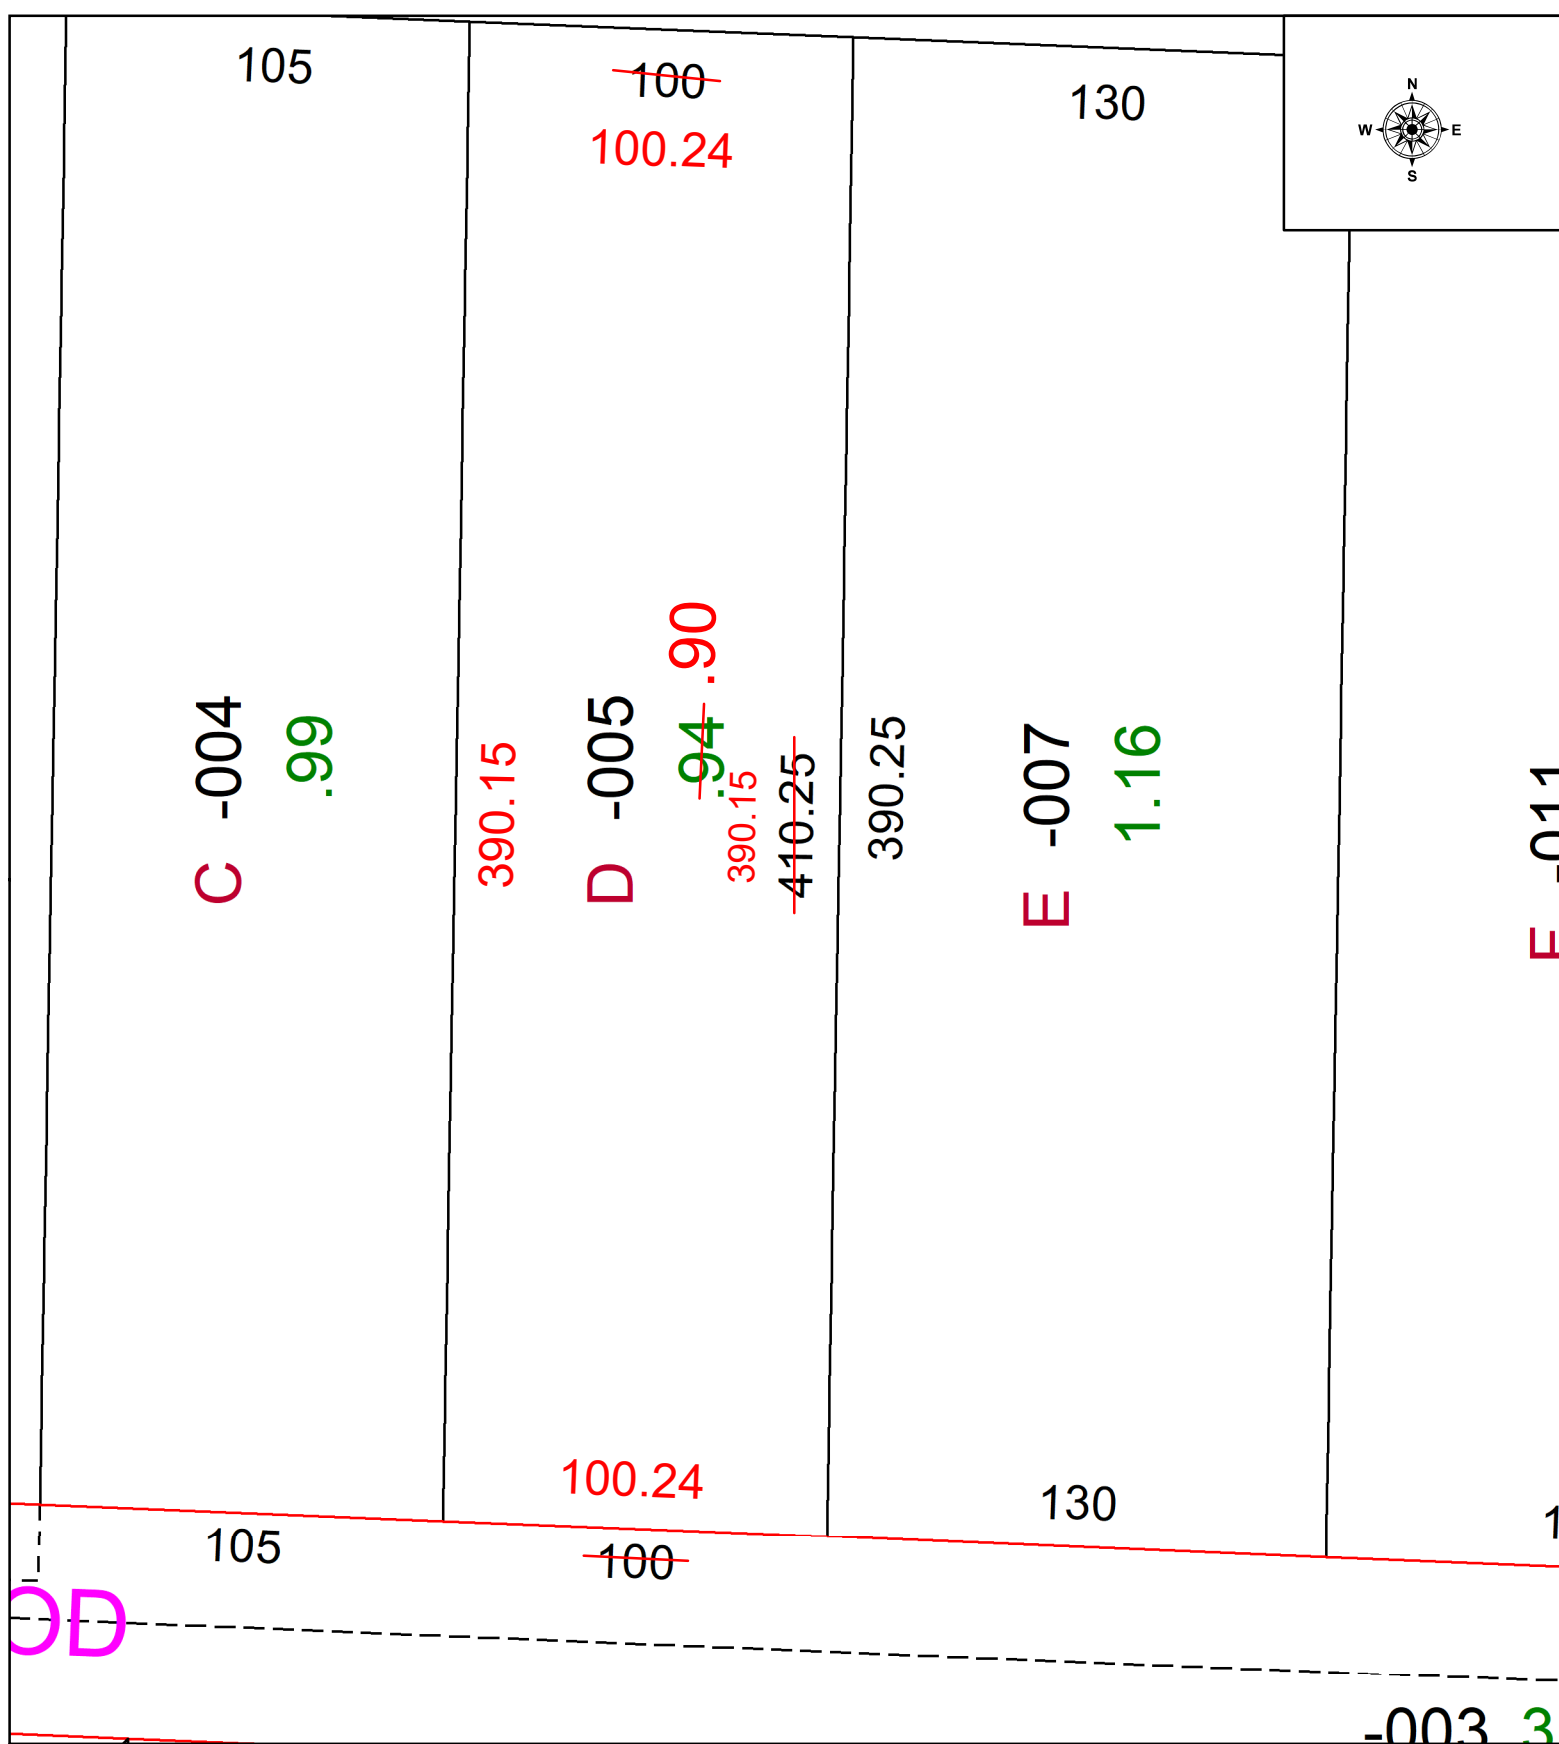

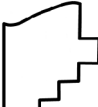

SPLITS/DEEDS PROCESSED
LORAIN COUNTY TAX MAP DEPARTMENT
226 MIDDLE AVE. ELYRIA, OH

SURVEYED BY: RONALD HINTON

CLOSURE: 1: INF

MAP PAGE(S): 12-00-047

APPROVED BY: WRZ

DATE: 10/30/2025

SCALE: 1" = 50

SURVEY # 51582

PRIOR INSTRUMENT: #2023-0921538