

PARENT PARCEL: \_\_\_\_\_

ADD TO DUP. - PER MISC. DEED 11 PG. 347-349




CHILD PARCEL: \_\_\_\_\_

03-00-033-900-005

25-05612-C

STARTING POINT: \_\_\_\_\_

DEDICATION & EXTENTION OF WALKER RD.

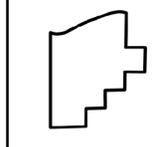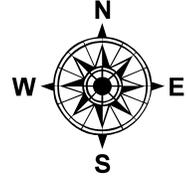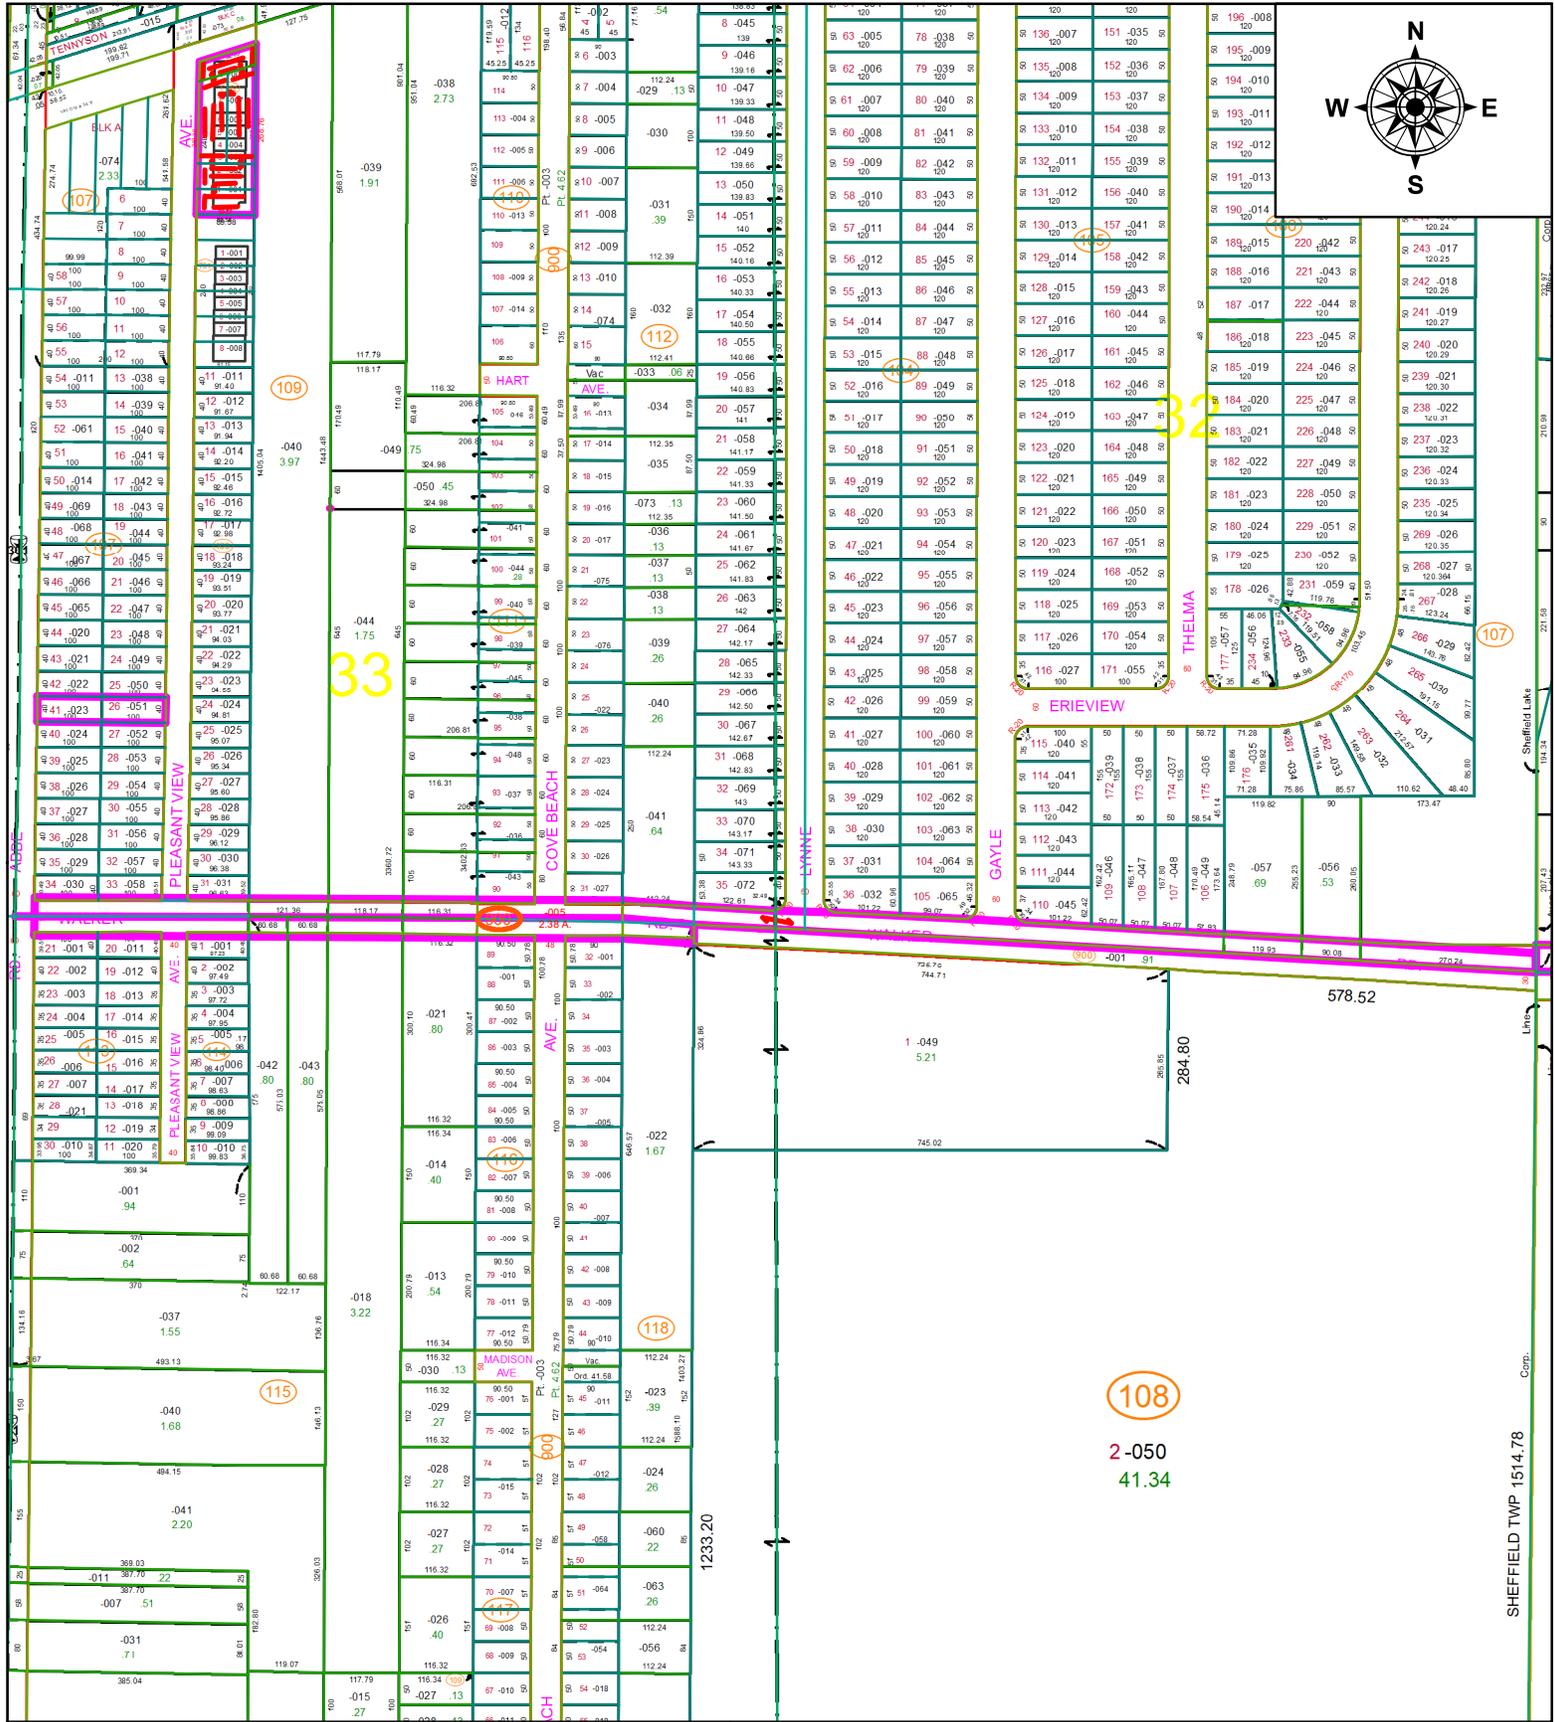

**SPLITS/DEEDS PROCESSED**  
 LORAIN COUNTY TAX MAP DEPARTMENT  
 226 MIDDLE AVE. ELYRIA, OH

SURVEYED BY: \_\_\_\_\_ NA  
 CLOSURE: \_\_\_\_\_ NA  
 MAP PAGE(S): \_\_\_\_\_ 3-00-033  
 APPROVED BY: \_\_\_\_\_ TJS DATE: \_\_\_\_\_ 10/29/2025  
 SCALE: \_\_\_\_\_ 1" = 300' PRIOR INSTRUMENT: \_\_\_\_\_ MISC DEED 11/347