
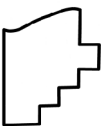
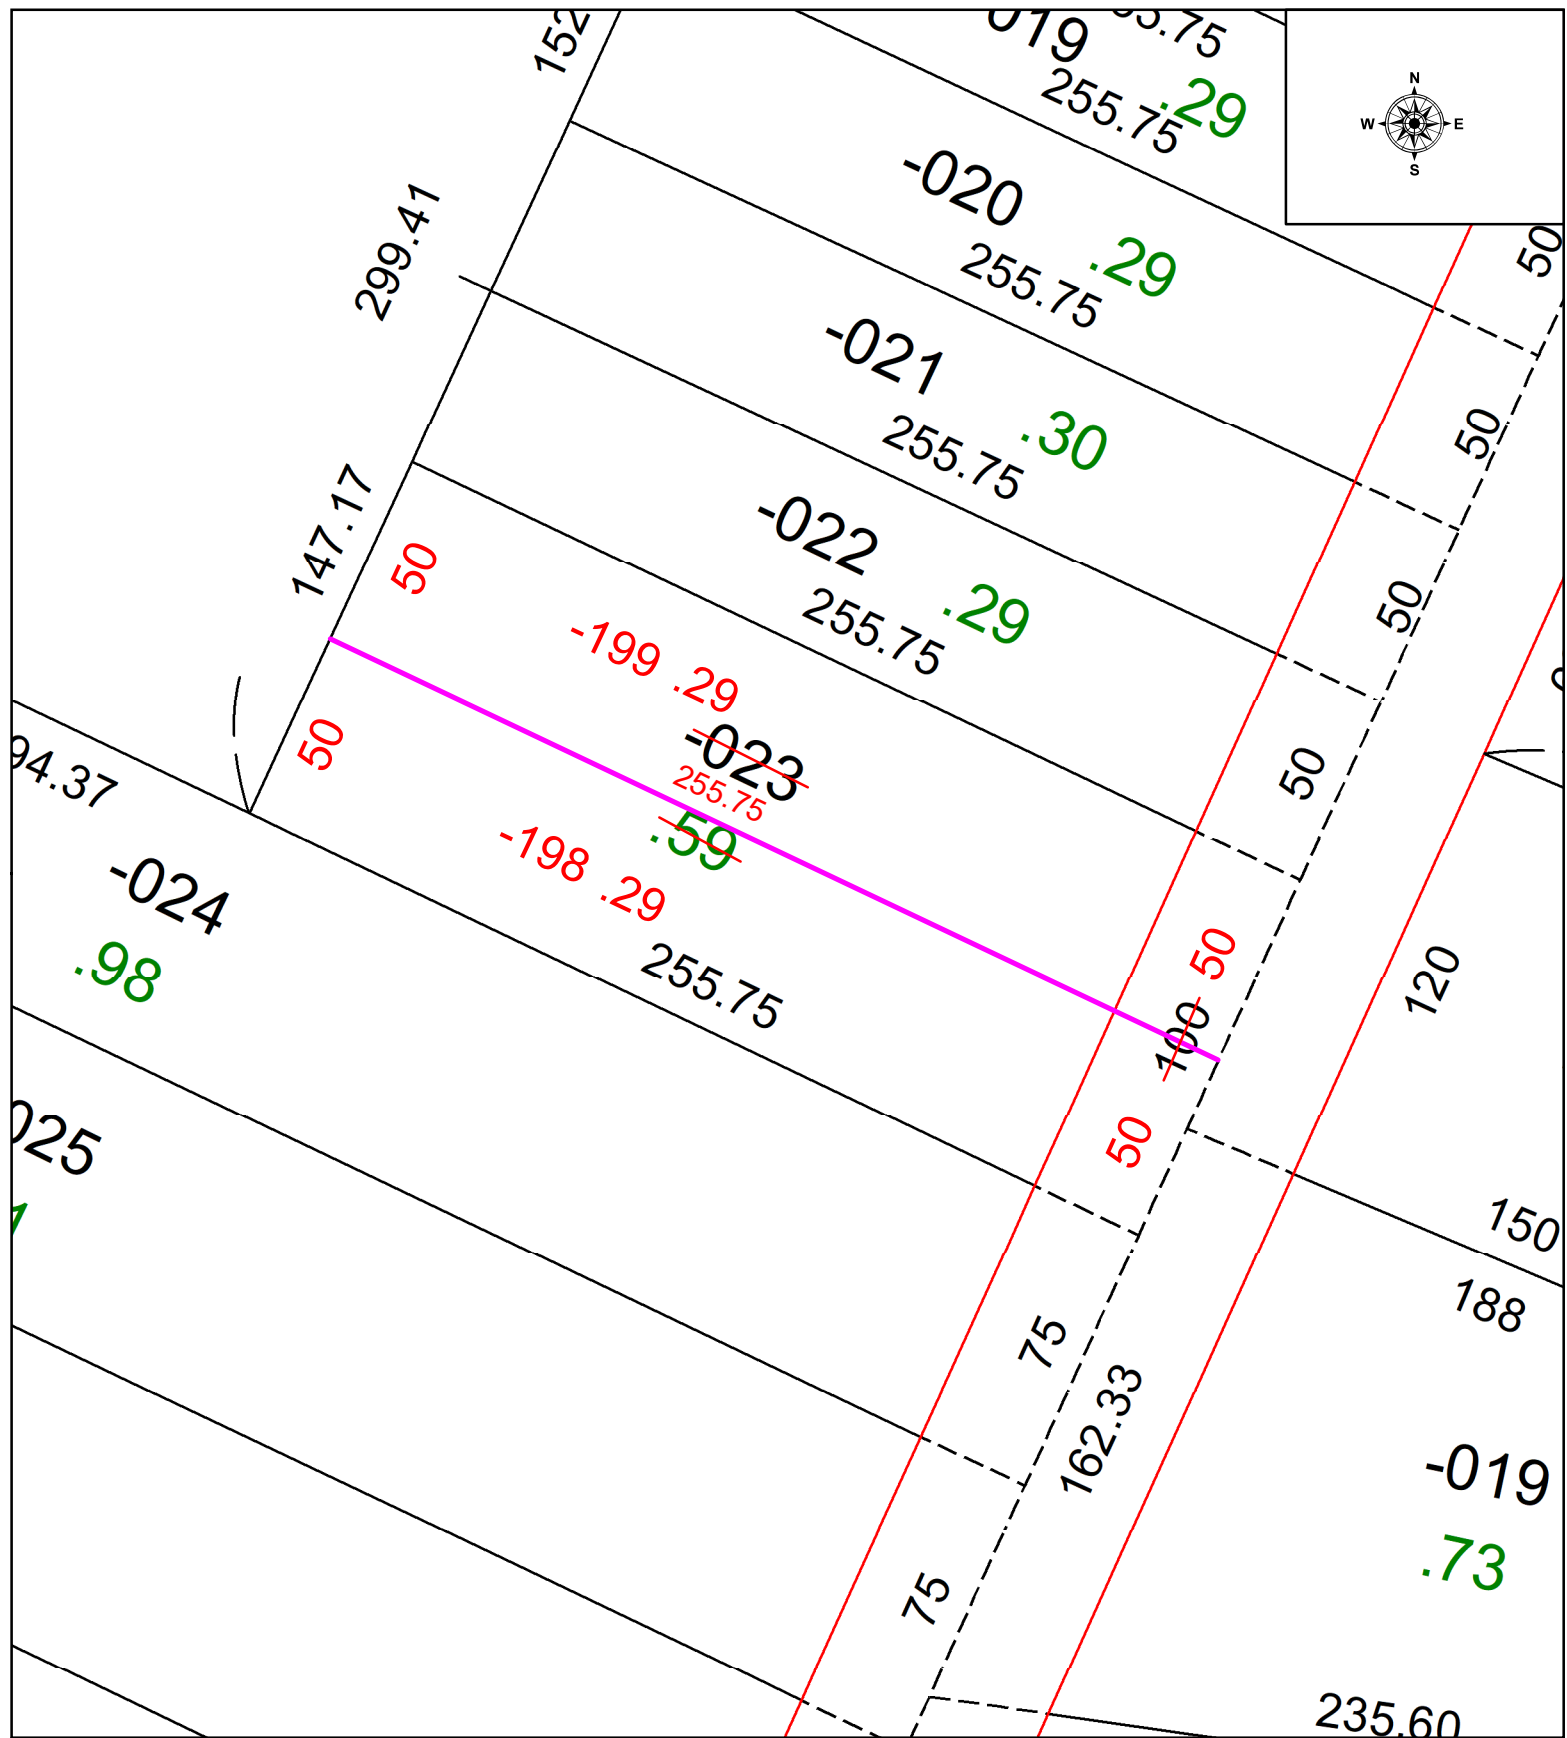


25-05632-U

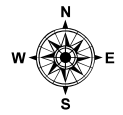

LORAIN COUNTY TAX MAP DEPARTMENT
226 MIDDLE AVE. ELYRIA, OH

SURVEYED BY: _____ N/A **SURVEY #** N/A
CLOSURE: _____ 1: INF
MAP PAGE(S): _____ 05-00-016
APPROVED BY: _____ WRZ **DATE:** 12/2/2025
SCALE: 1" = 50' **PRIOR INSTRUMENT:** #2022-0901406