

PARENT PARCEL: _____

06-25-071-104-002




CHILD PARCEL: _____

FR & DPTH TO AC CORR PER SURVEYOR RICHARD KOLE

25-05640-C

STARTING POINT: _____

NORTHWEST CORNER OF S/L 18 IN HILL REALTY CO.'S SUB. NO. 01 PV 6/55

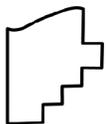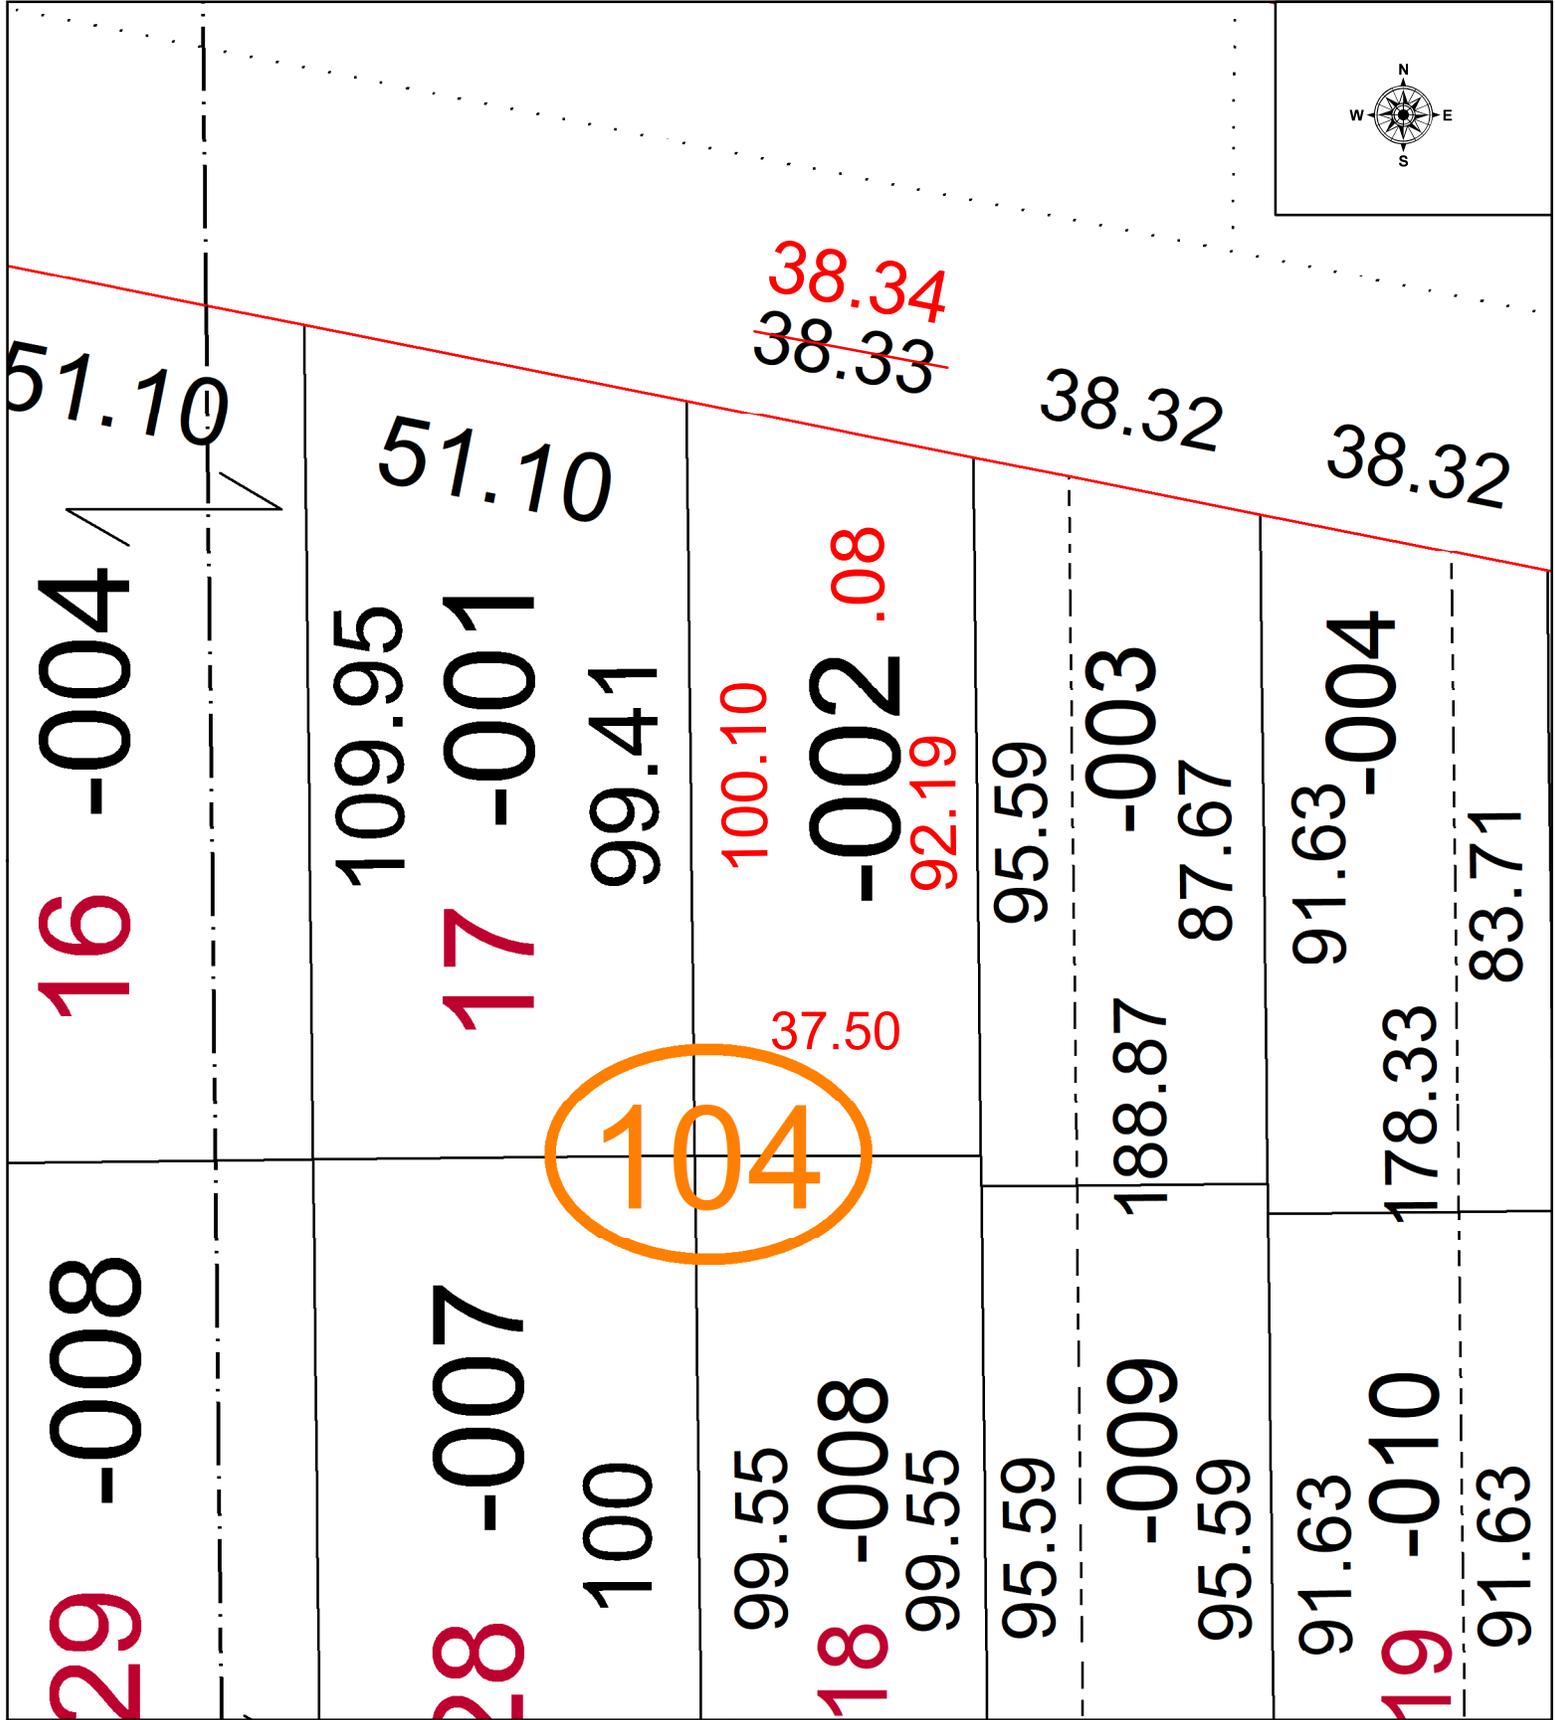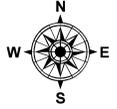

SPLITS/DEEDS PROCESSED
 LORAIN COUNTY TAX MAP DEPARTMENT
 226 MIDDLE AVE. ELYRIA, OH

SURVEYED BY: RICHARD KOLE SURVEY # 51624
 CLOSURE: 1: 67696
 MAP PAGE(S): 06-25-071
 APPROVED BY: WRZ DATE: 12/19/2025
 SCALE: 1" = 25 PRIOR INSTRUMENT: #2018-0683860