
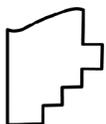


PARENT PARCEL: 02-01-003-170-019

CHILD PARCEL: AC. CORR. PER INSTR. # 2023-0939652

STARTING POINT: N/A

25-05642-A

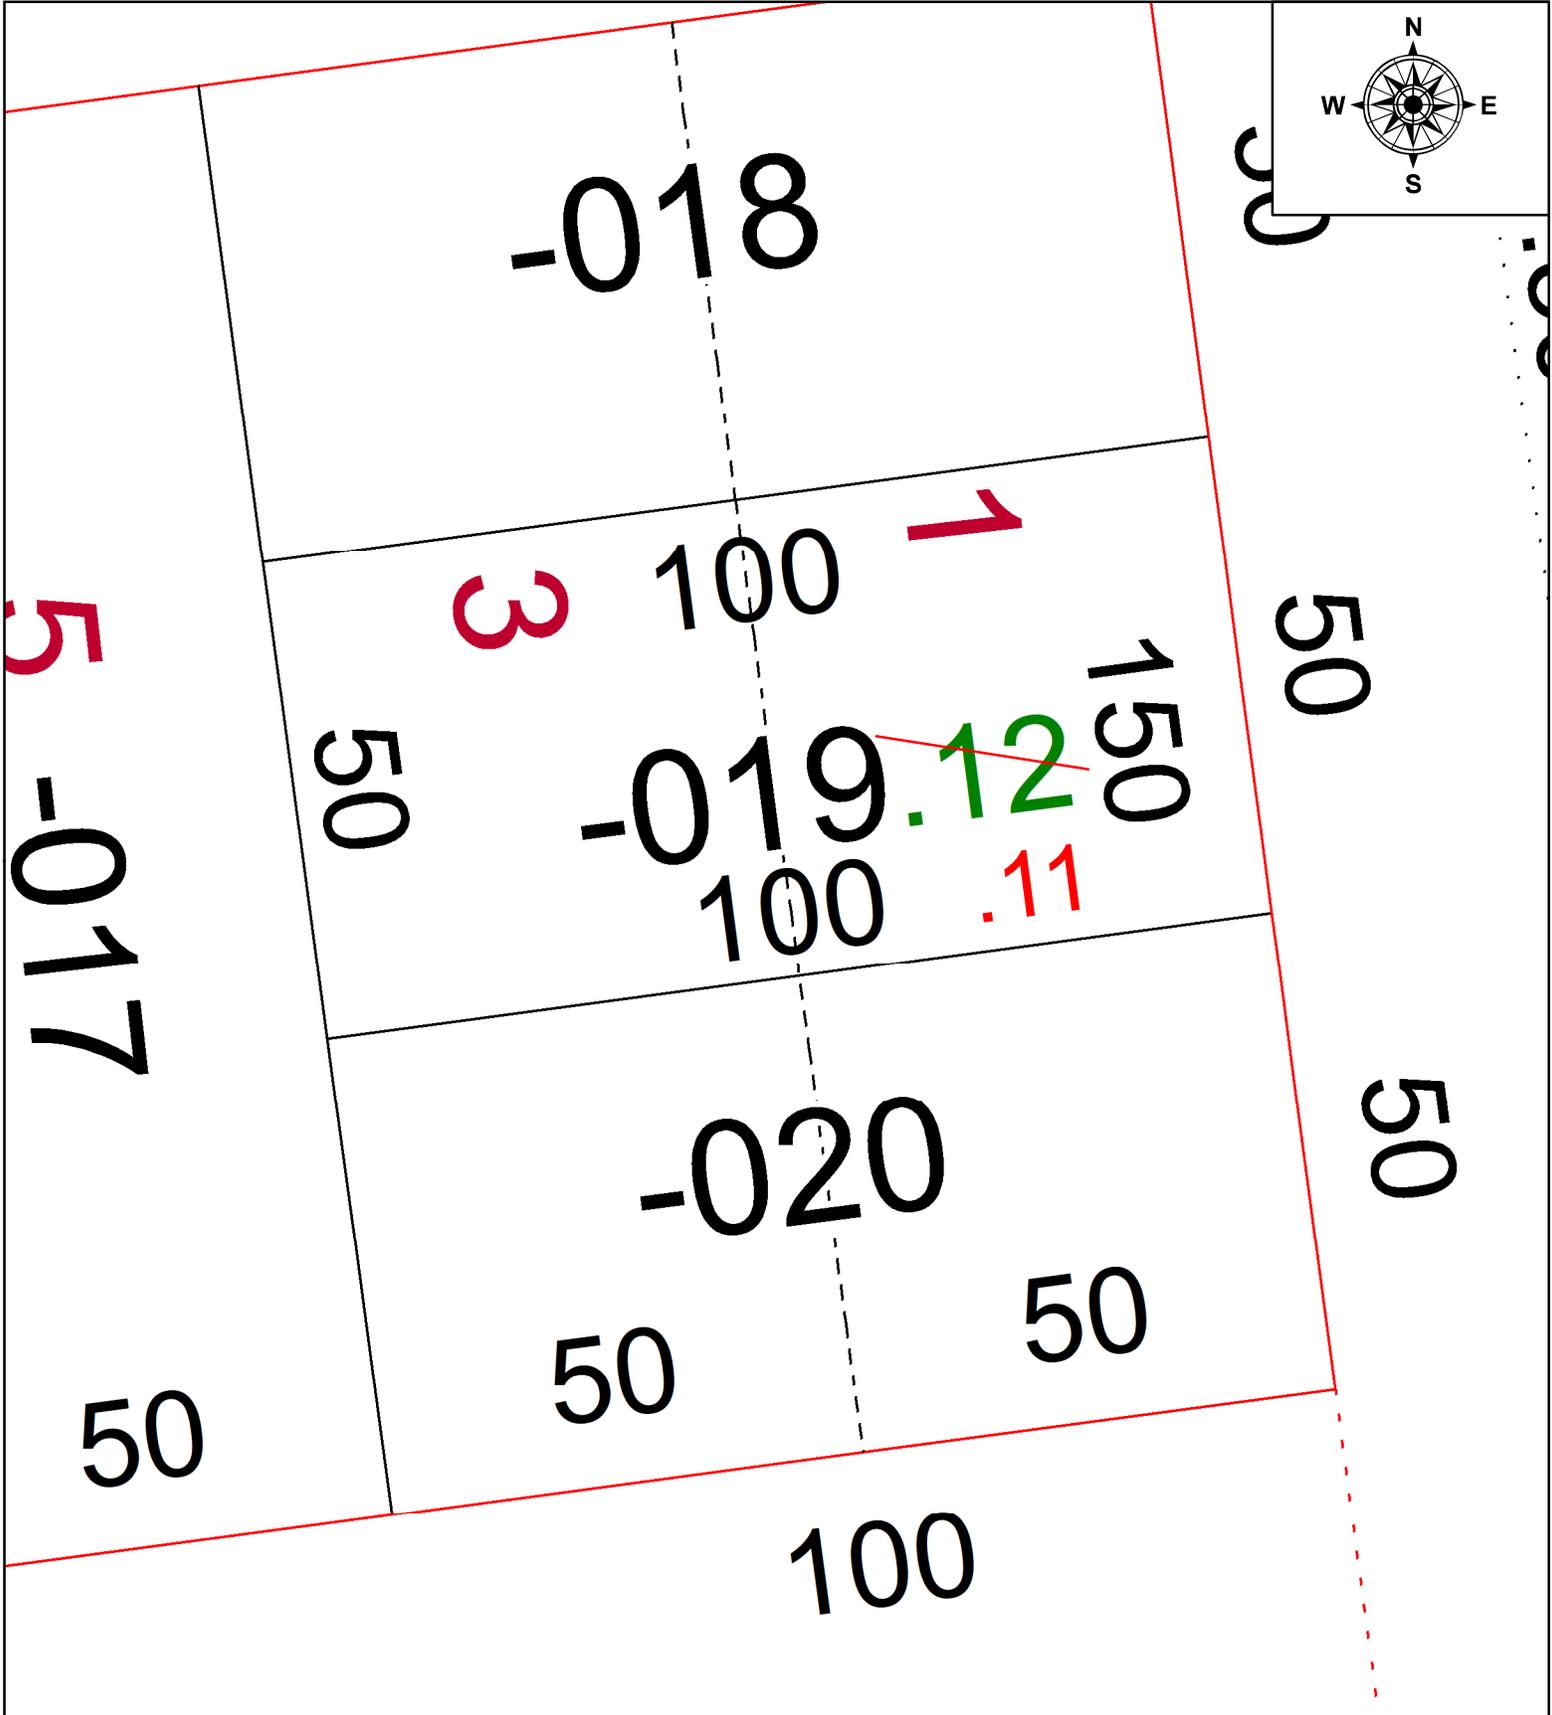

SPLITS/DEEDS PROCESSED
 LORAIN COUNTY TAX MAP DEPARTMENT
 226 MIDDLE AVE. ELYRIA, OH

SURVEYED BY: N/A SURVEY #: N/A
 CLOSURE: N/A
 MAP PAGE(S): 02-01-003
 APPROVED BY: DMA DATE: 12/22/2025
 SCALE: 1" = 600' PRIOR INSTRUMENT: 2023-0939652