
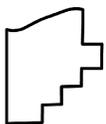
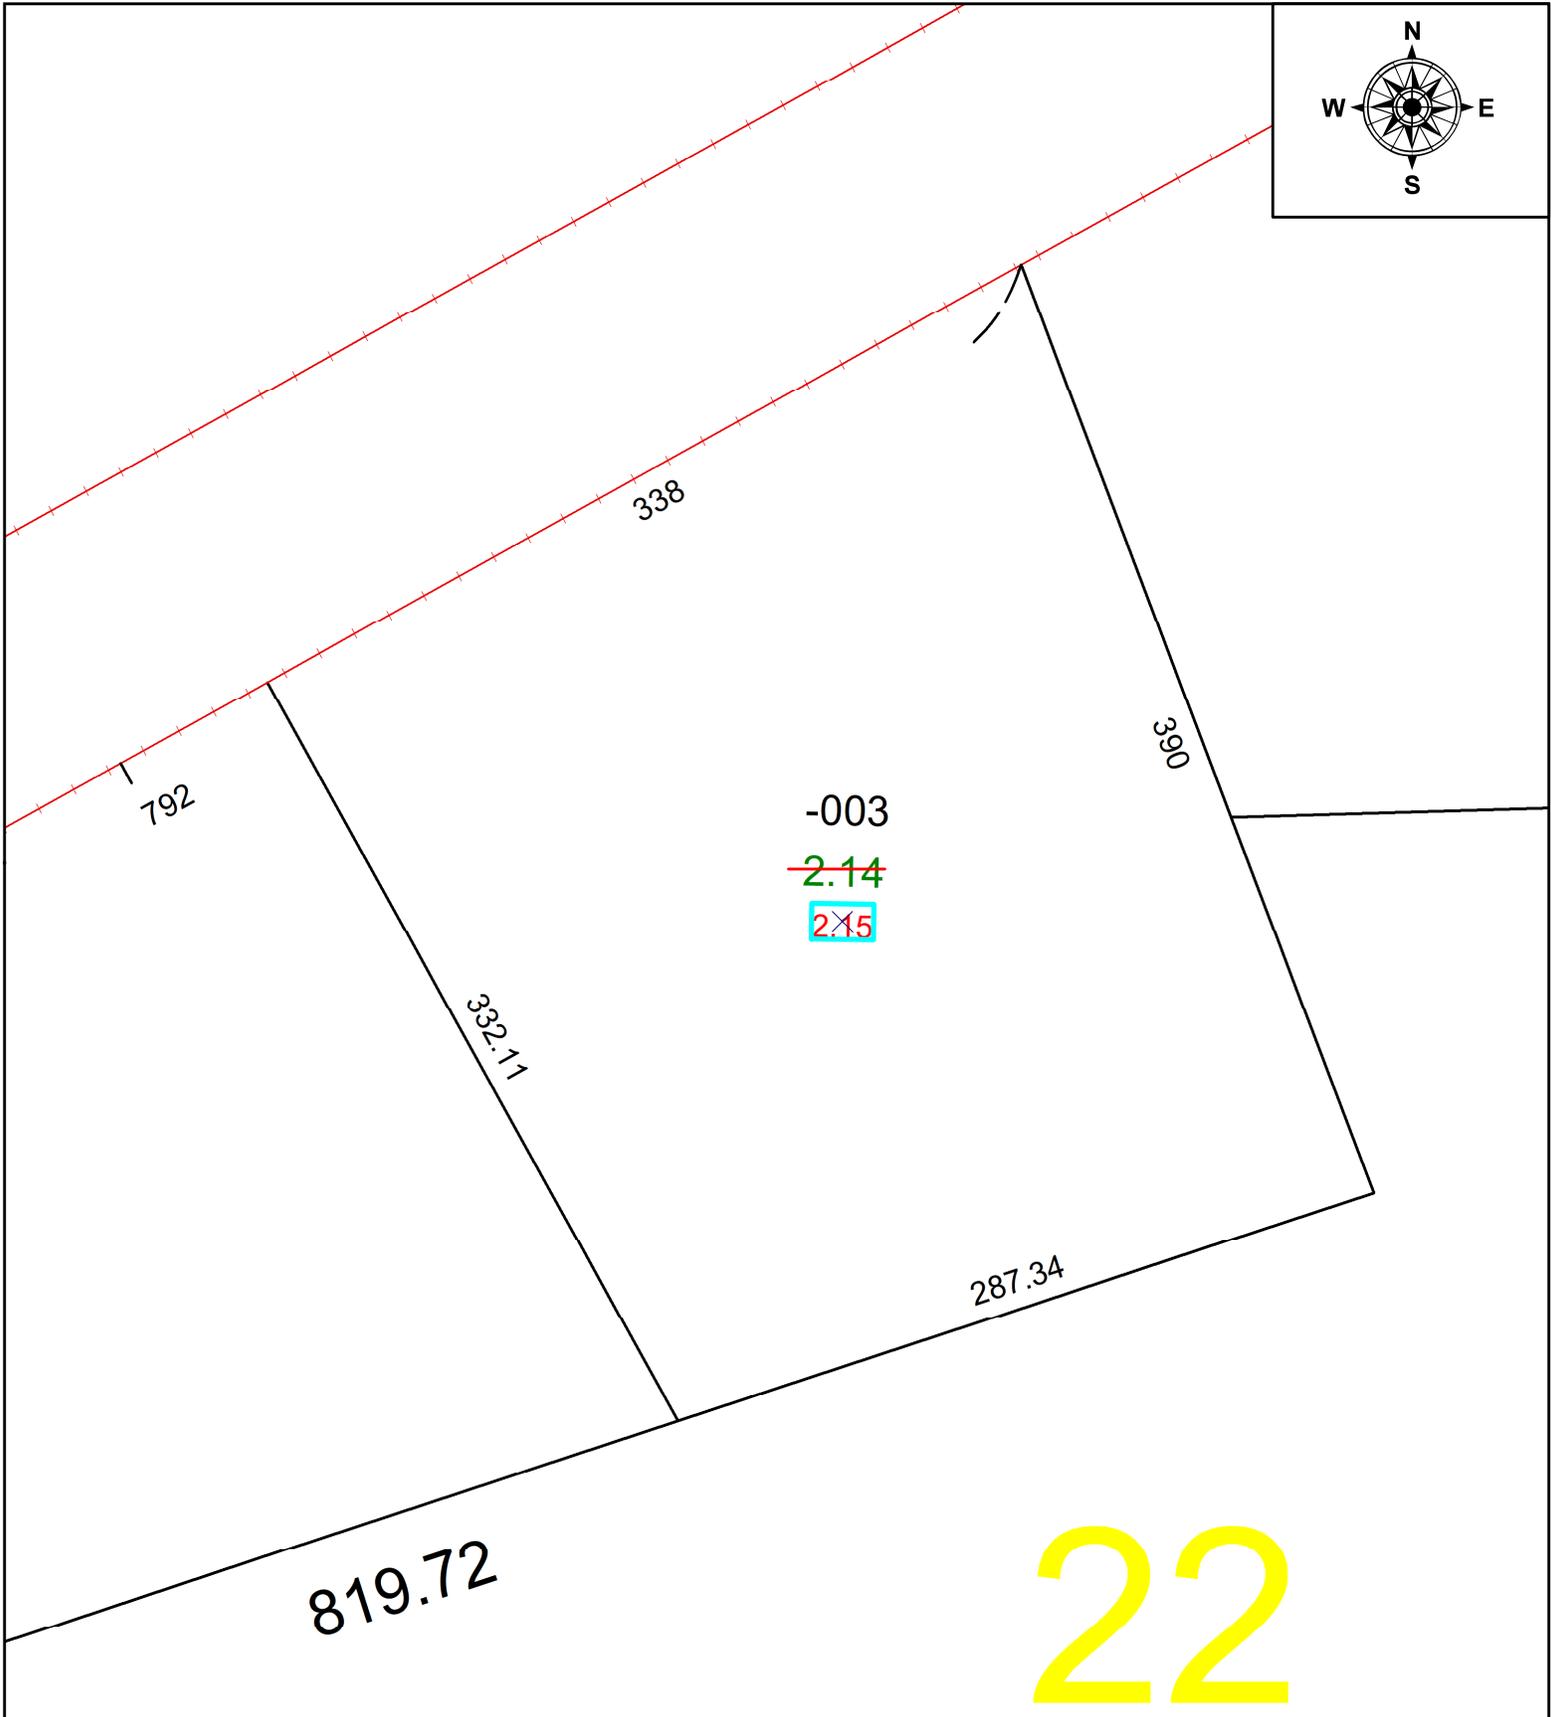


PARENT PARCEL: 20-05-022-102-003

CHILD PARCEL: **AC CORR PER PRIOR INSTRUMENT NO. 2000-0718357**

STARTING POINT:

25-05105

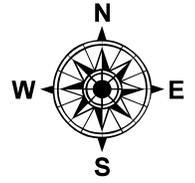

**SPLITS/DEEDS PROCESSED**  
 LORAIN COUNTY TAX MAP DEPARTMENT  
 226 MIDDLE AVE. ELYRIA, OH

SURVEYED BY: \_\_\_\_\_ N/A SURV # N/A

CLOSURE: \_\_\_\_\_ 1: N/A

MAP PAGE(S): \_\_\_\_\_ 20-05-022

APPROVED BY: \_\_\_\_\_ AC DATE: December 23, 2025

SCALE: \_\_\_\_\_ 1 in = 75 ft PRIOR INSTRUMENT: \_\_\_\_\_ 2000-0718357