
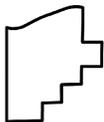
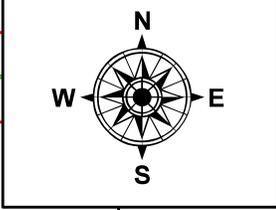


PARENT PARCEL: 05-00-085-000-001

CHILD PARCEL: **AC CORR PER SURV BY SCOTT J. CASEY**

STARTING POINT: NW CORNER OF O/L 85

26-05647-C

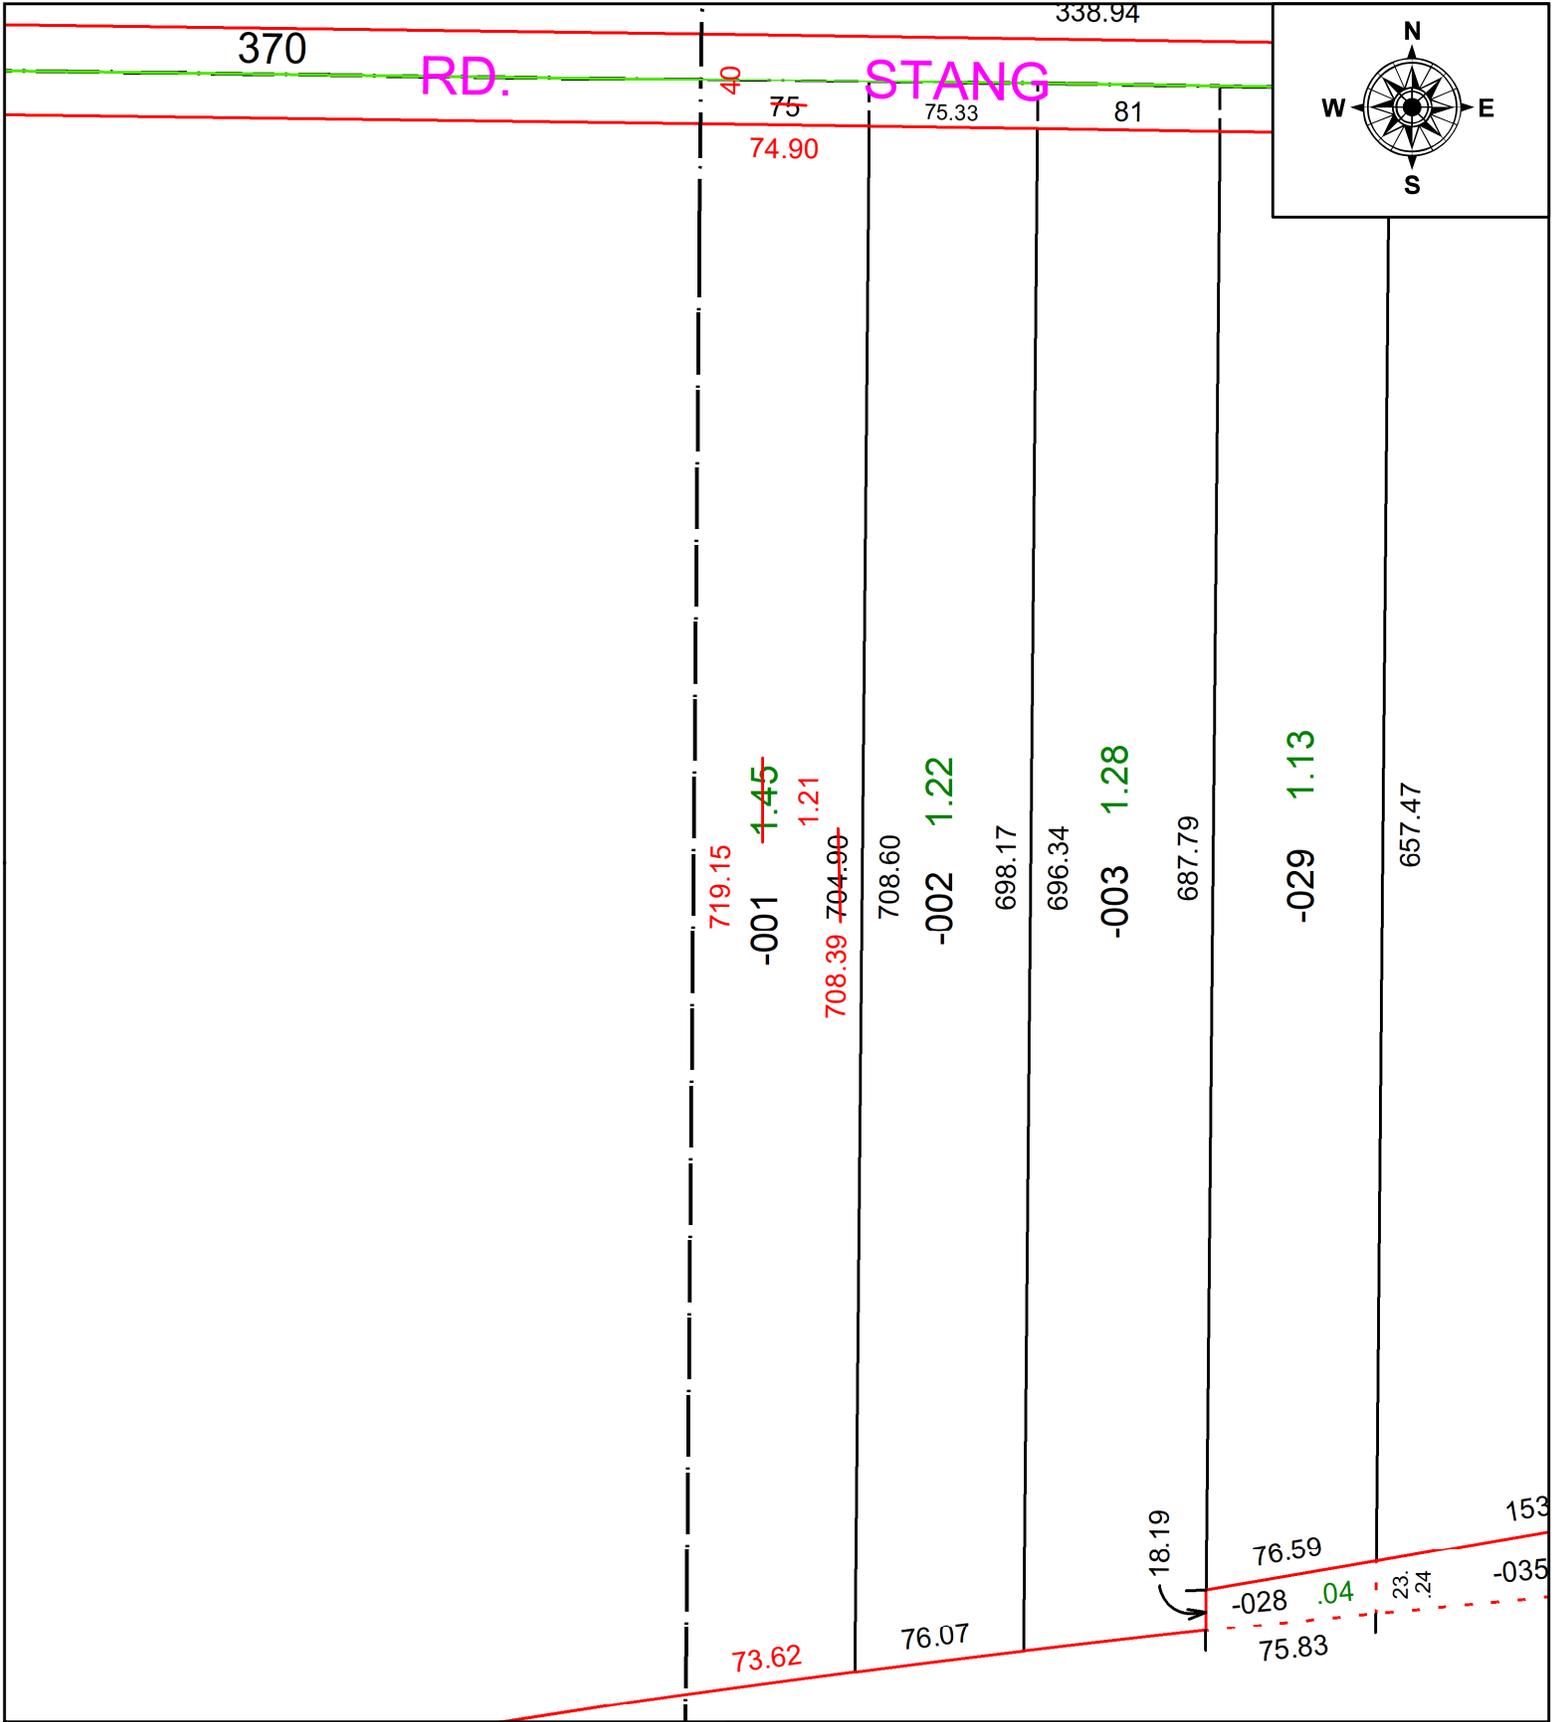

SPLITS/DEEDS PROCESSED
 LORAIN COUNTY TAX MAP DEPARTMENT
 226 MIDDLE AVE. ELYRIA, OH

SURVEYED BY: SCOTT J. CASEY SURV # 51633

CLOSURE: 1: 141530

MAP PAGE(S): 05-00-085

APPROVED BY: AC DATE: January 06, 2026

SCALE: 1 in = 85 ft PRIOR INSTRUMENT: 2025- 0076881