
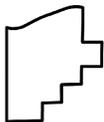
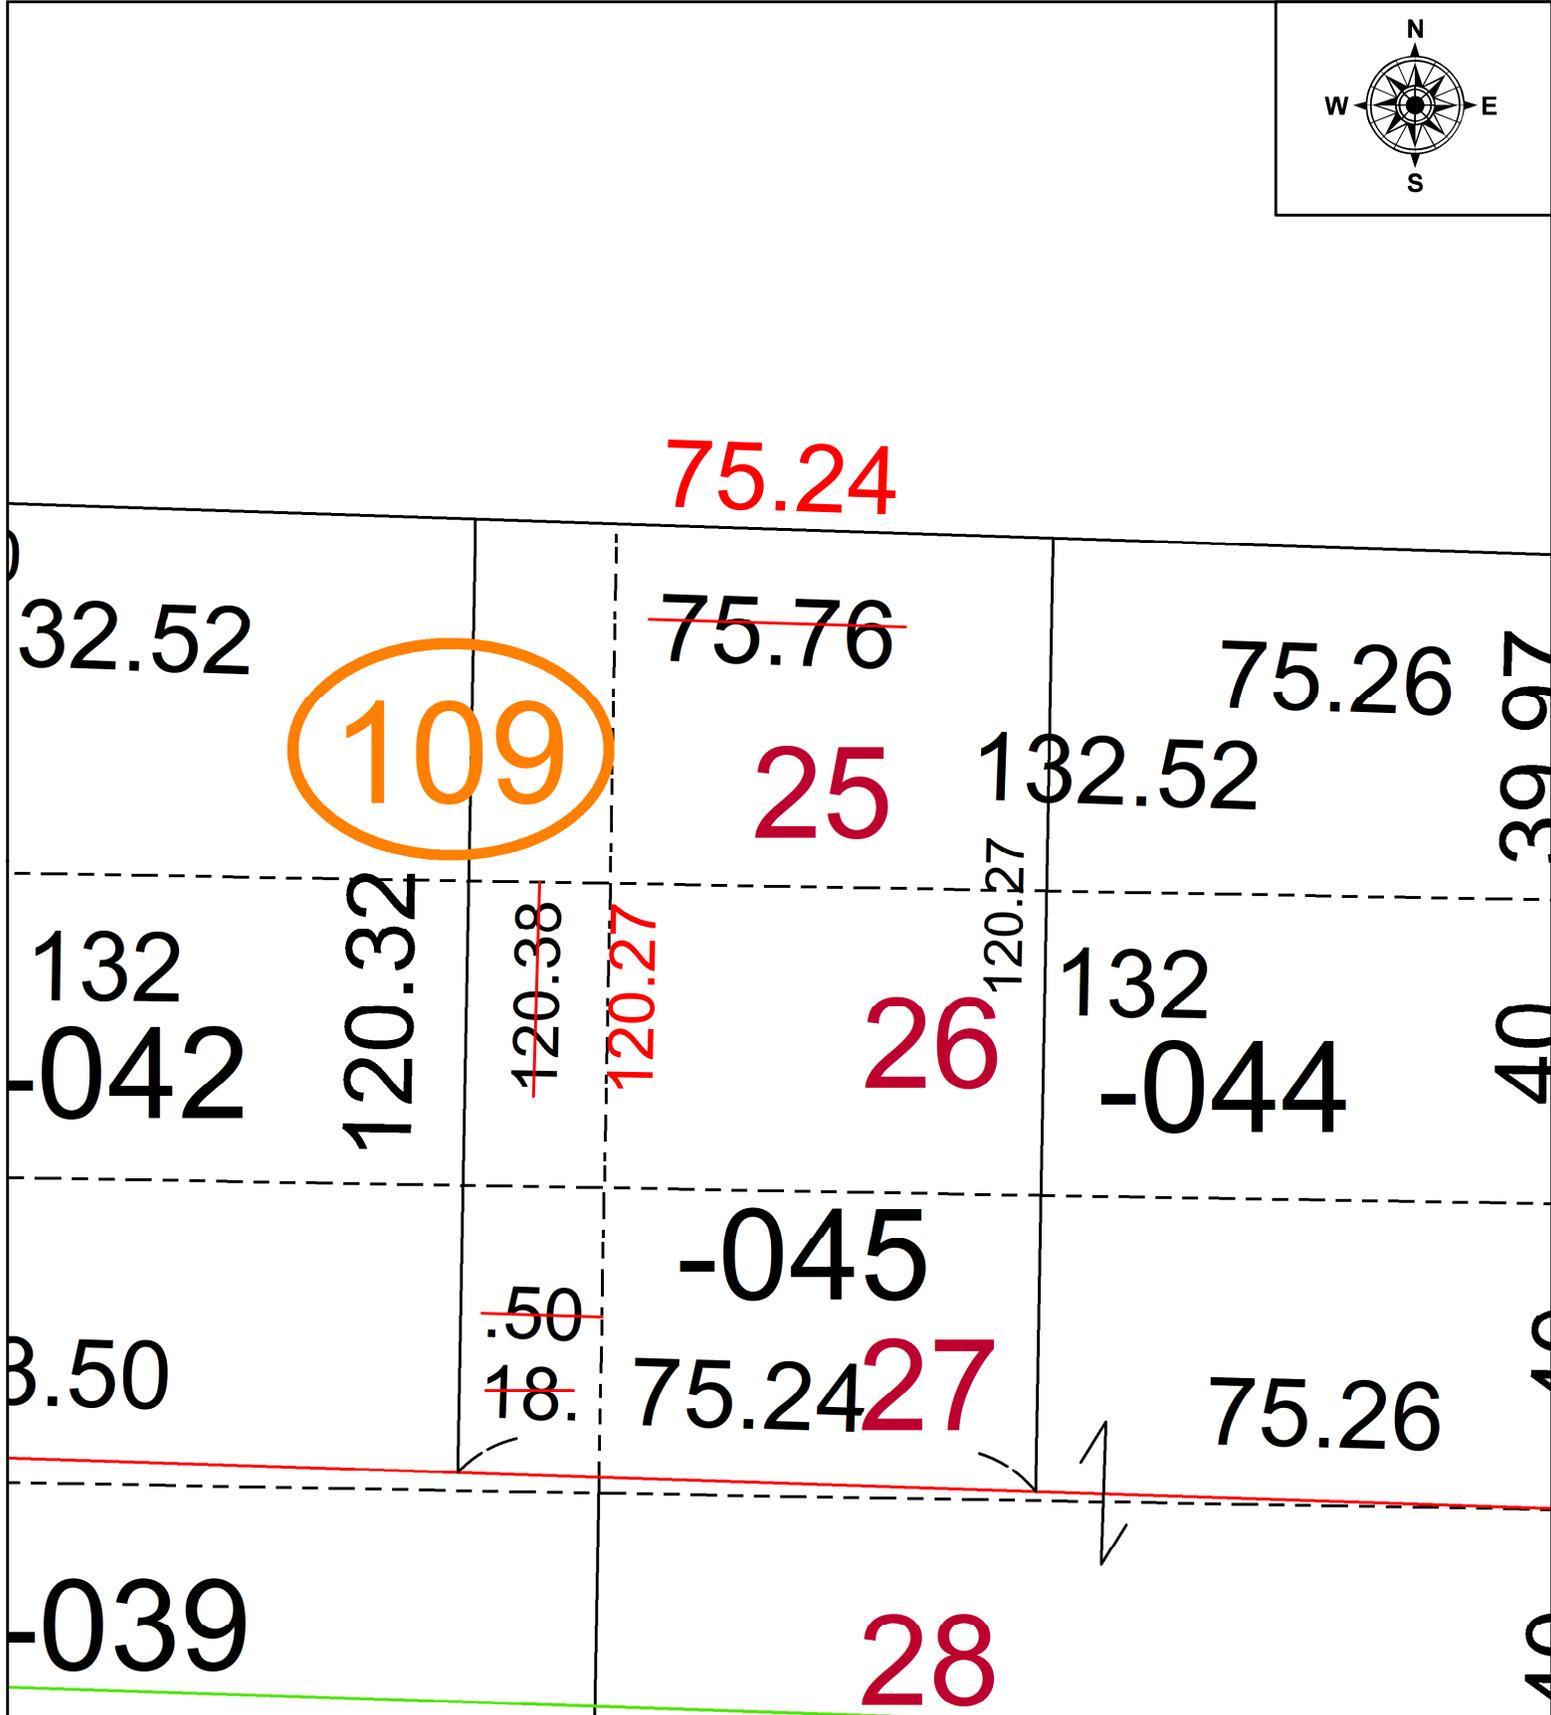


PARENT PARCEL: 03-00-055-109-045

CHILD PARCEL: **MAP CORRECTION ONLY**

STARTING POINT: W LINE OF NEW HAMPSHIRE AVE AND N LINE OF CREHORE ST

26-05648-C

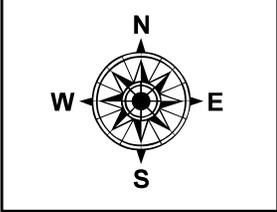

**SPLITS/DEEDS PROCESSED**  
 LORAIN COUNTY TAX MAP DEPARTMENT  
 226 MIDDLE AVE. ELYRIA, OH

SURVEYED BY: WILFREDO BARBOSA SURV # 51635  
 CLOSURE: 1: INF  
 MAP PAGE(S): 03-00-055  
 APPROVED BY: AC DATE: January 07, 2026  
 SCALE: 1 in = 25 ft PRIOR INSTRUMENT: 2025- 0042168