
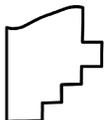
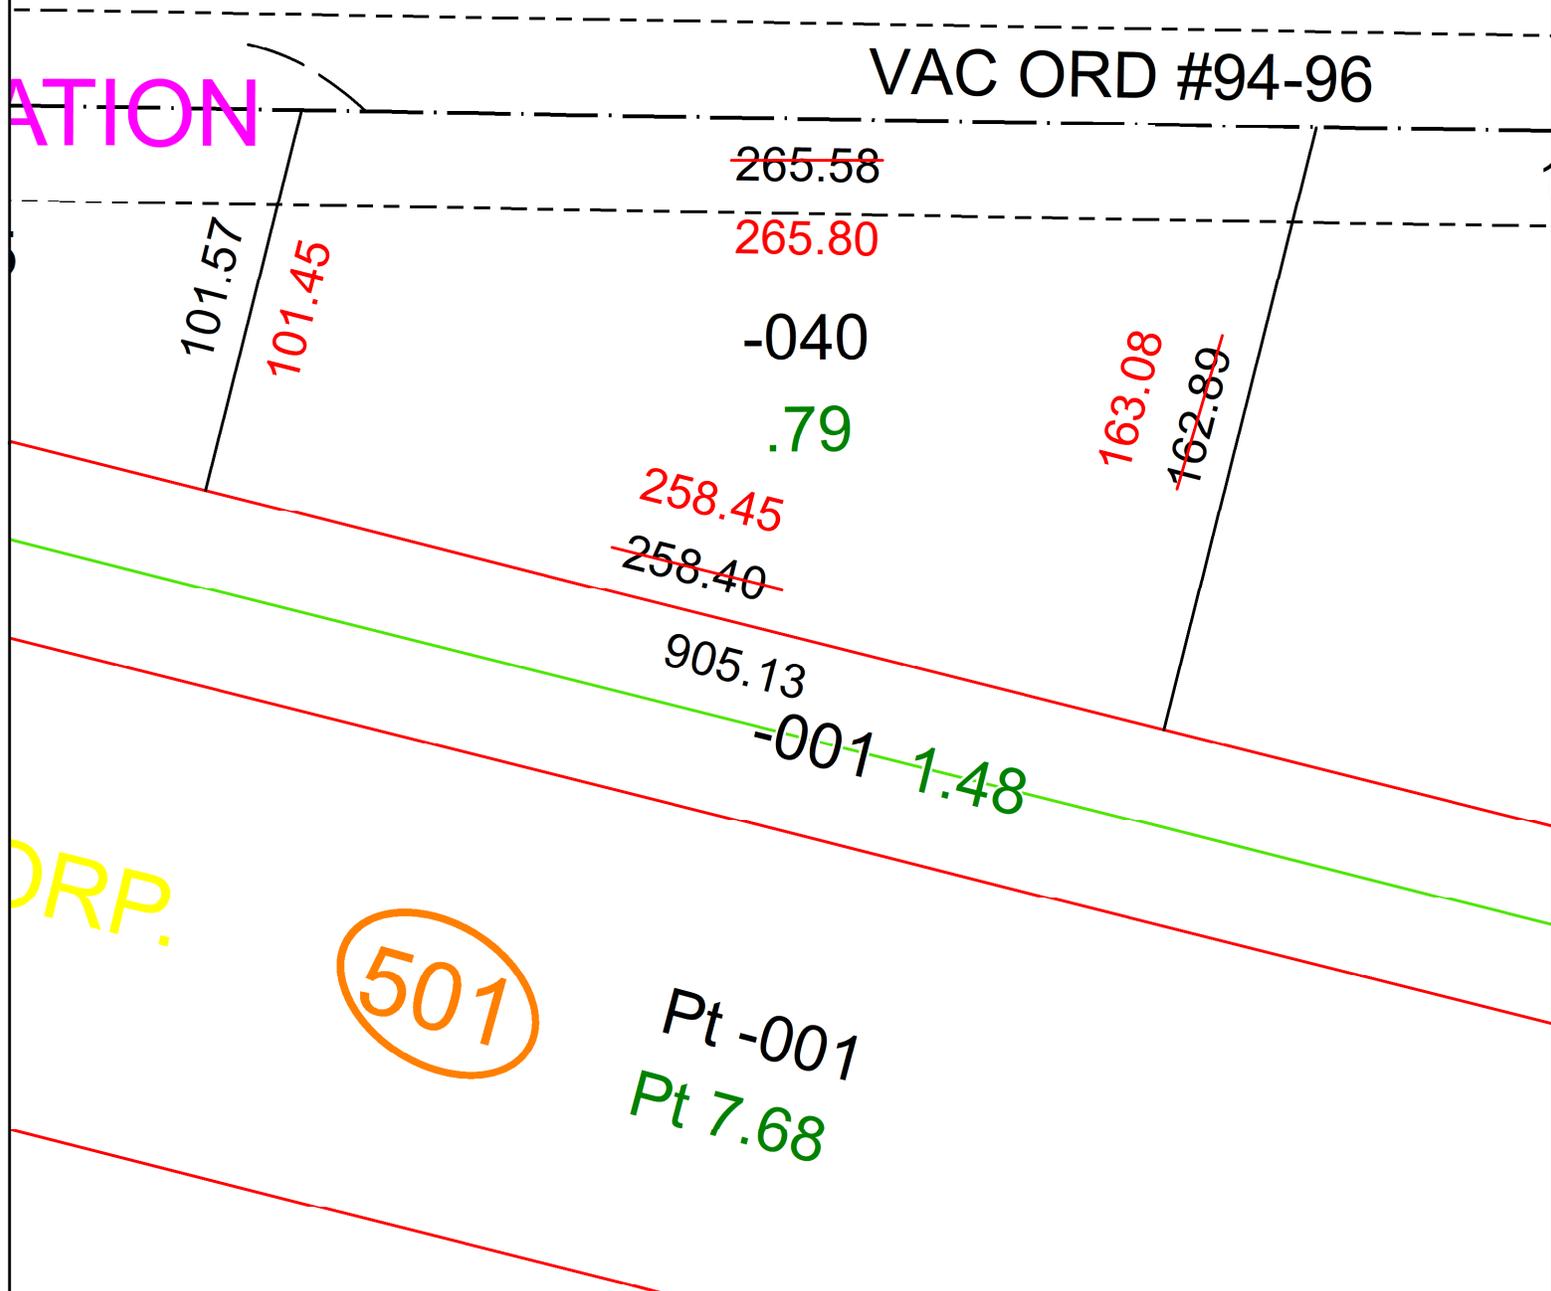


PARENT PARCEL: 01-00-021-000-040

CHILD PARCEL: **MAP CORRECTION ONLY**

STARTING POINT: C/L OF CLAUS RD AND BROWNHelm STATION RD

26-05654-C

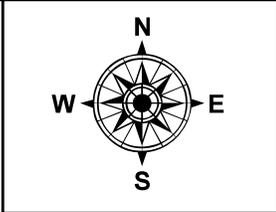

SPLITS/DEEDS PROCESSED
 LORAIN COUNTY TAX MAP DEPARTMENT
 226 MIDDLE AVE. ELYRIA, OH

SURVEYED BY: ROBERT M. RUFFING SURV # 51650
 CLOSURE: 1: 220145
 MAP PAGE(S): 01-00-021
 APPROVED BY: AC DATE: February 05, 2026
 SCALE: 1 in = 50 ft PRIOR INSTRUMENT: 2025- 0060350