
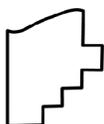


PARENT PARCEL: 04-00-009-000-008 & -009

26-05658-C

CHILD PARCEL: AC CORR PER SURVEYOR MICHAEL SPELLACY

STARTING POINT: INTERSECTION OF C/LS AVON COMMERCE PKWY & MOORE RD

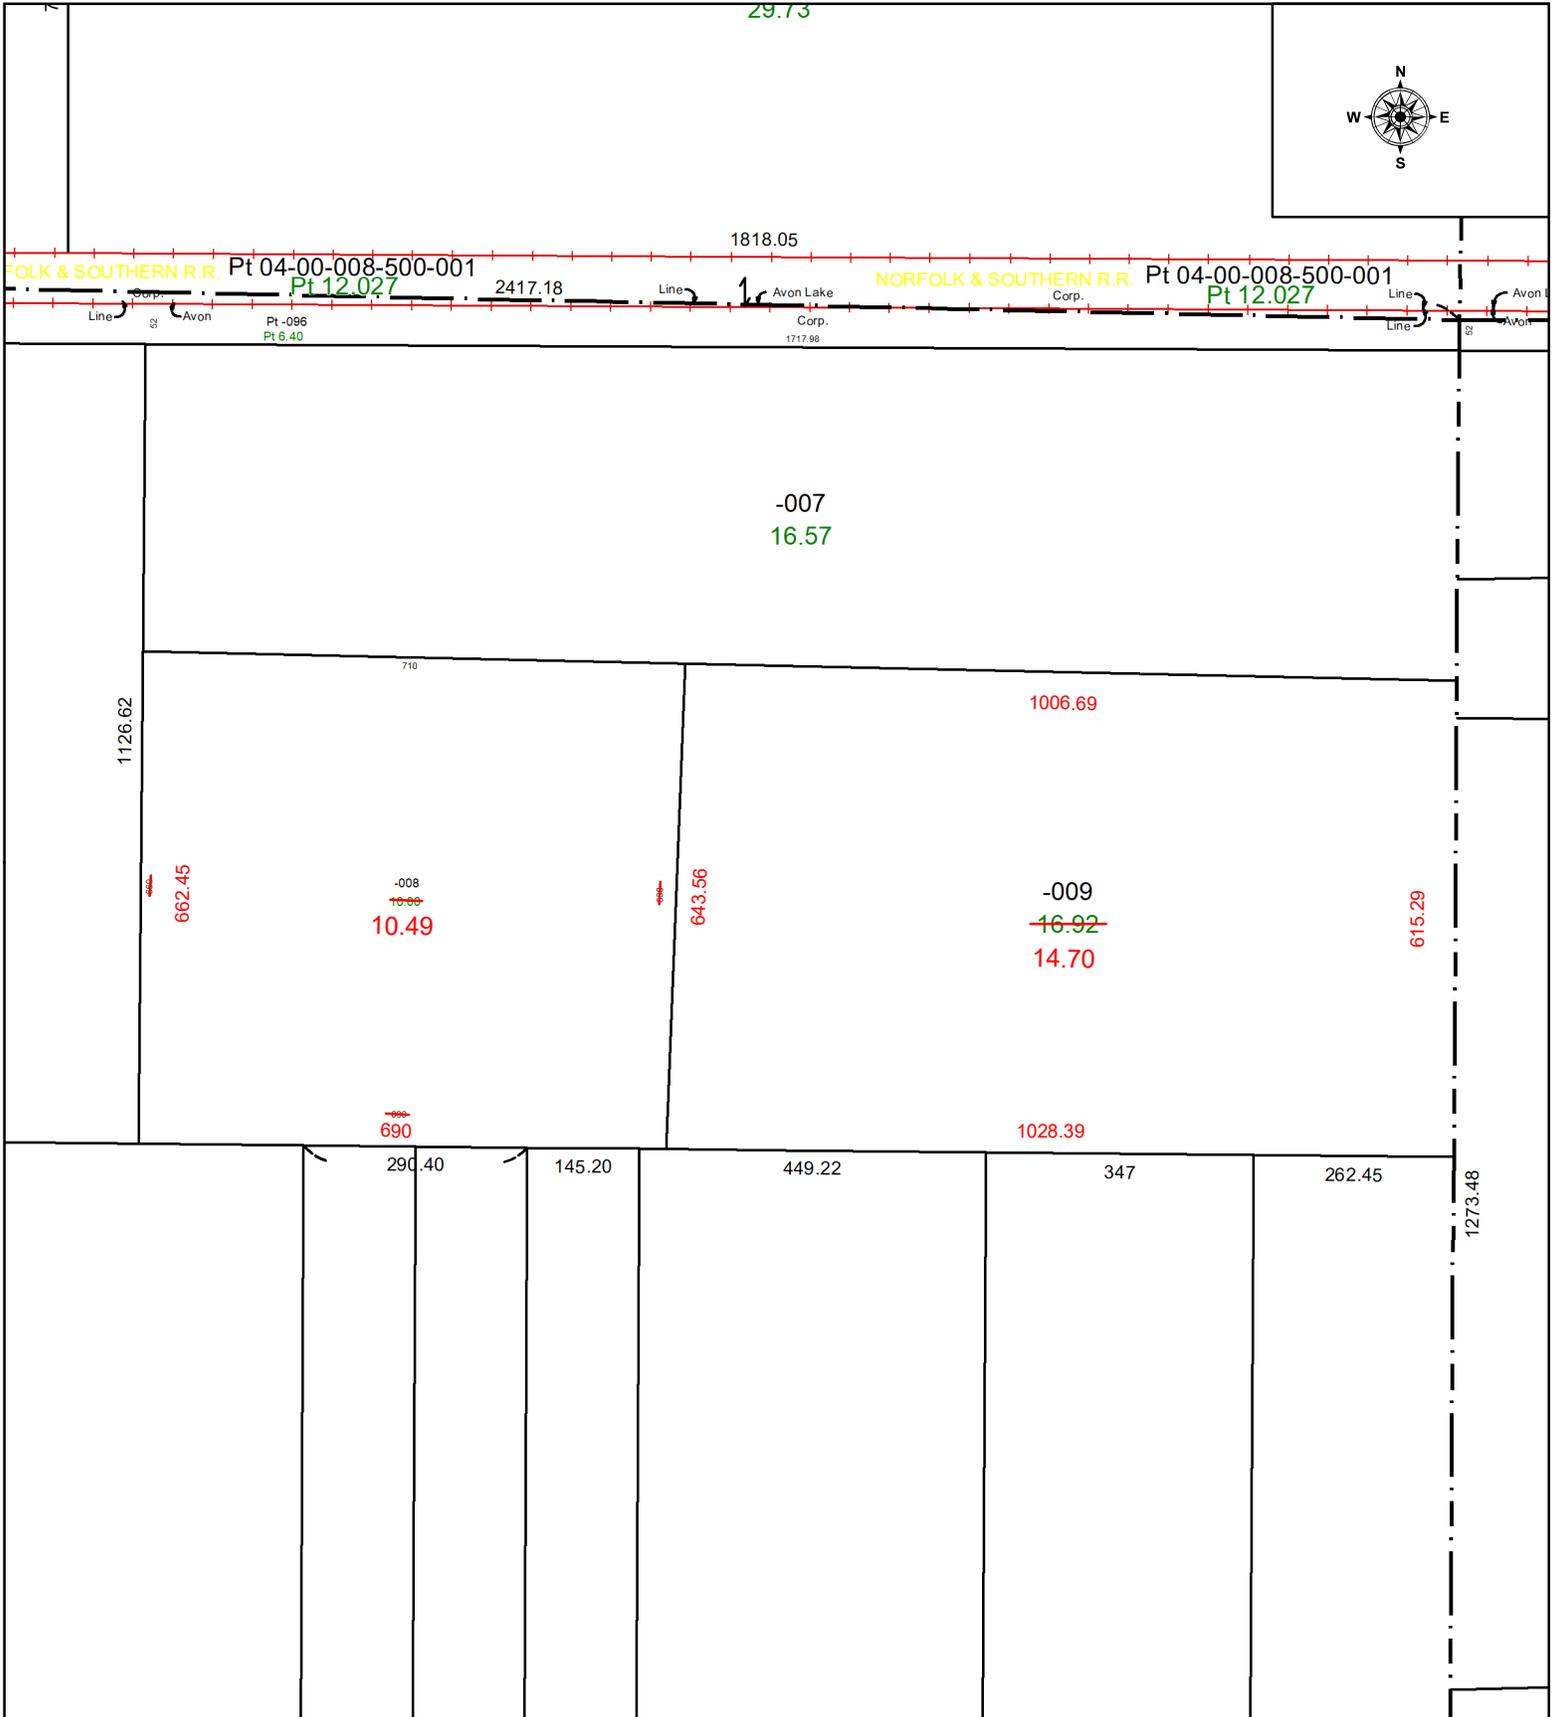

SPLITS/DEEDS PROCESSED
 LORAIN COUNTY TAX MAP DEPARTMENT
 226 MIDDLE AVE. ELYRIA, OH

SURVEYED BY: MICHAEL SPELLACY SURVEY # 51646
 CLOSURE: 1: 1724118
 MAP PAGE(S): 04-00-009
 APPROVED BY: WRZ DATE: 1/27/2026
 SCALE: 1" = 250' PRIOR INSTRUMENT: #1996-0382825