

PARENT PARCEL:

06-24-028-109-011 & -023



26-05661-C

CHILD PARCEL:

06-24-028-109-036 UNCOMBINATION PER PIOR #20250066397

STARTING POINT:

N/A

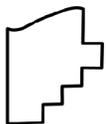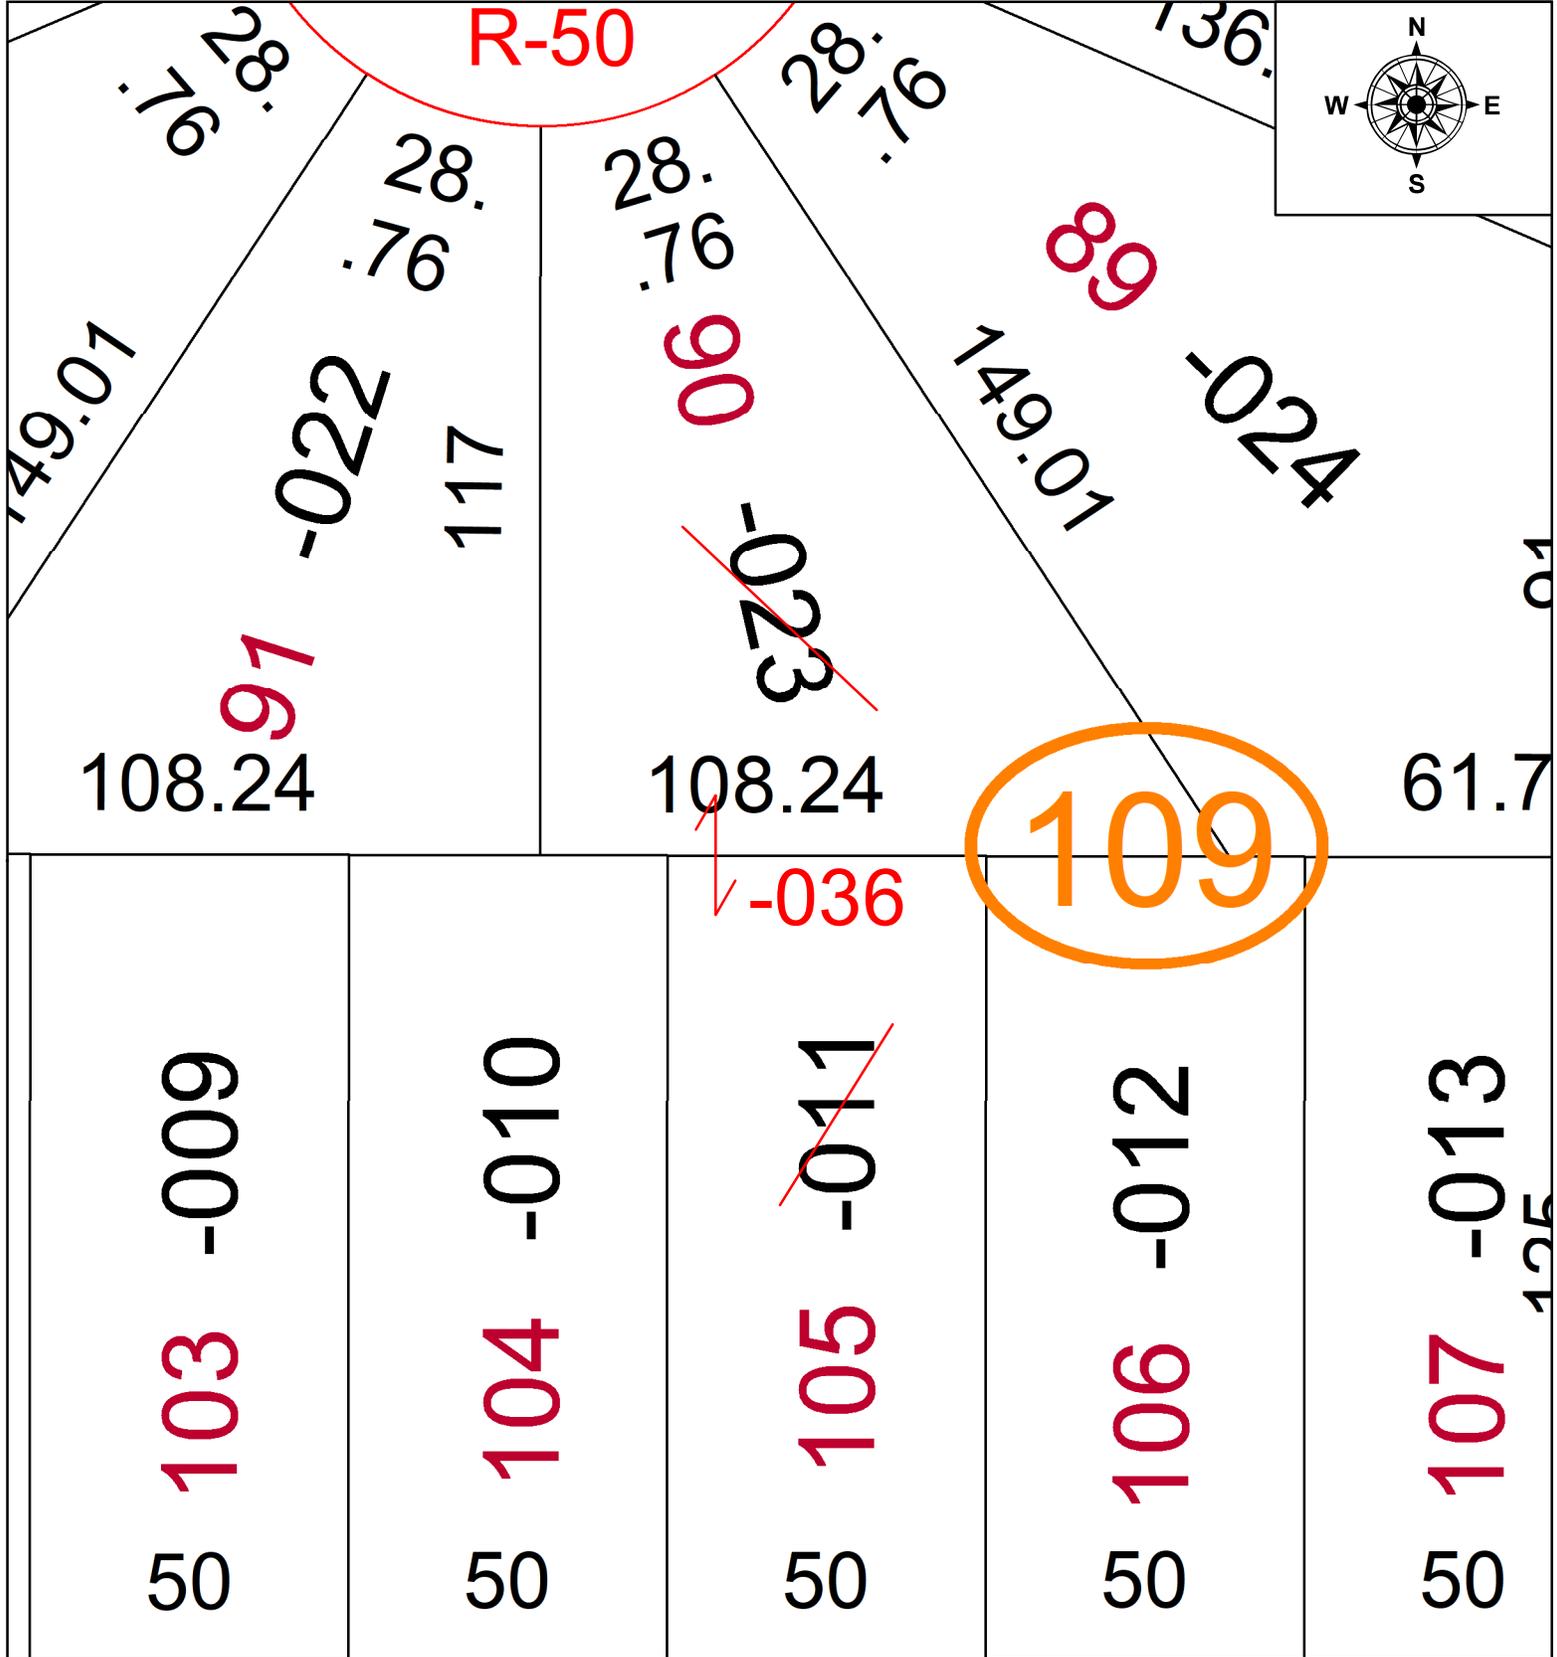

SPLITS/DEEDS PROCESSED
 LORAIN COUNTY TAX MAP DEPARTMENT
 226 MIDDLE AVE. ELYRIA, OH

SURVEYED BY: _____ N/A SURVEY #: N/A
 CLOSURE: _____ N/A
 MAP PAGE(S): _____ 06-24-028
 APPROVED BY: _____ BB DATE: 2/5/2026
 SCALE: 1" = 30' PRIOR INSTRUMENT: _____ #20250066397