
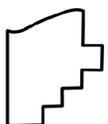


PARENT PARCEL: 03-00-042-106-009

CHILD PARCEL: AC CORR PER SURVEYOR ROBERT M. RUFFING

STARTING POINT: SE CORNER OF SUBLOT 713

26-05662-C

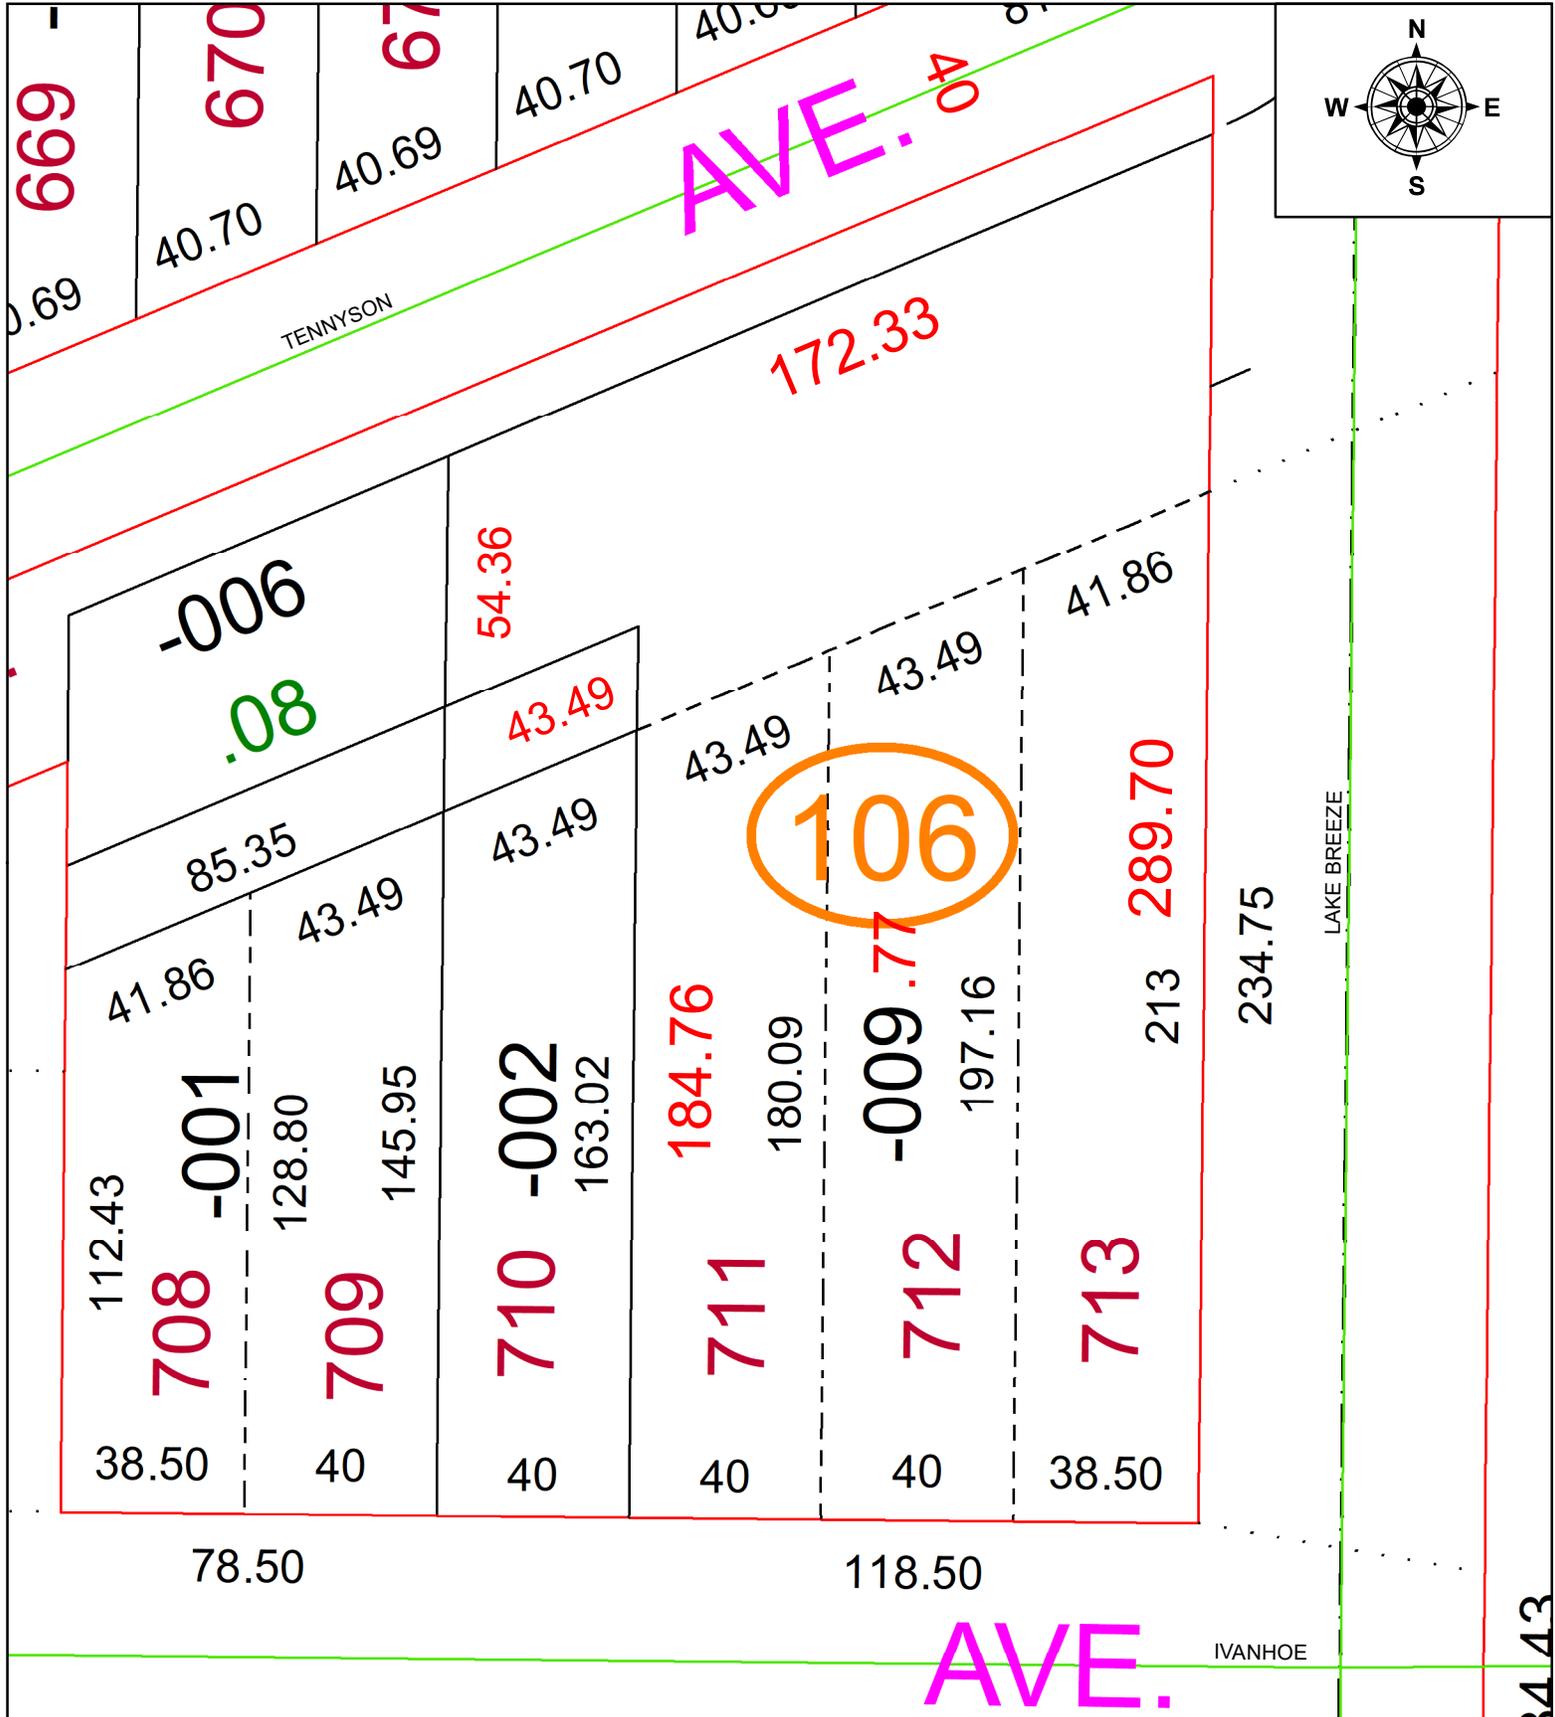

SPLITS/DEEDS PROCESSED
 LORAIN COUNTY TAX MAP DEPARTMENT
 226 MIDDLE AVE. ELYRIA, OH

SURVEYED BY: ROBERT M. RUFFING SURVEY #: 51651
 CLOSURE: 1: 271640
 MAP PAGE(S): 03-00-042
 APPROVED BY: BB DATE: 2/9/2026
 SCALE: 1" = 40' PRIOR INSTRUMENT: #20110380699