
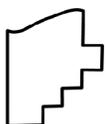


PARENT PARCEL: 10-00-006-120-006

26-05665-A

CHILD PARCEL:

STARTING POINT: AC CORR PER PRIOR DEED #2013-0458517

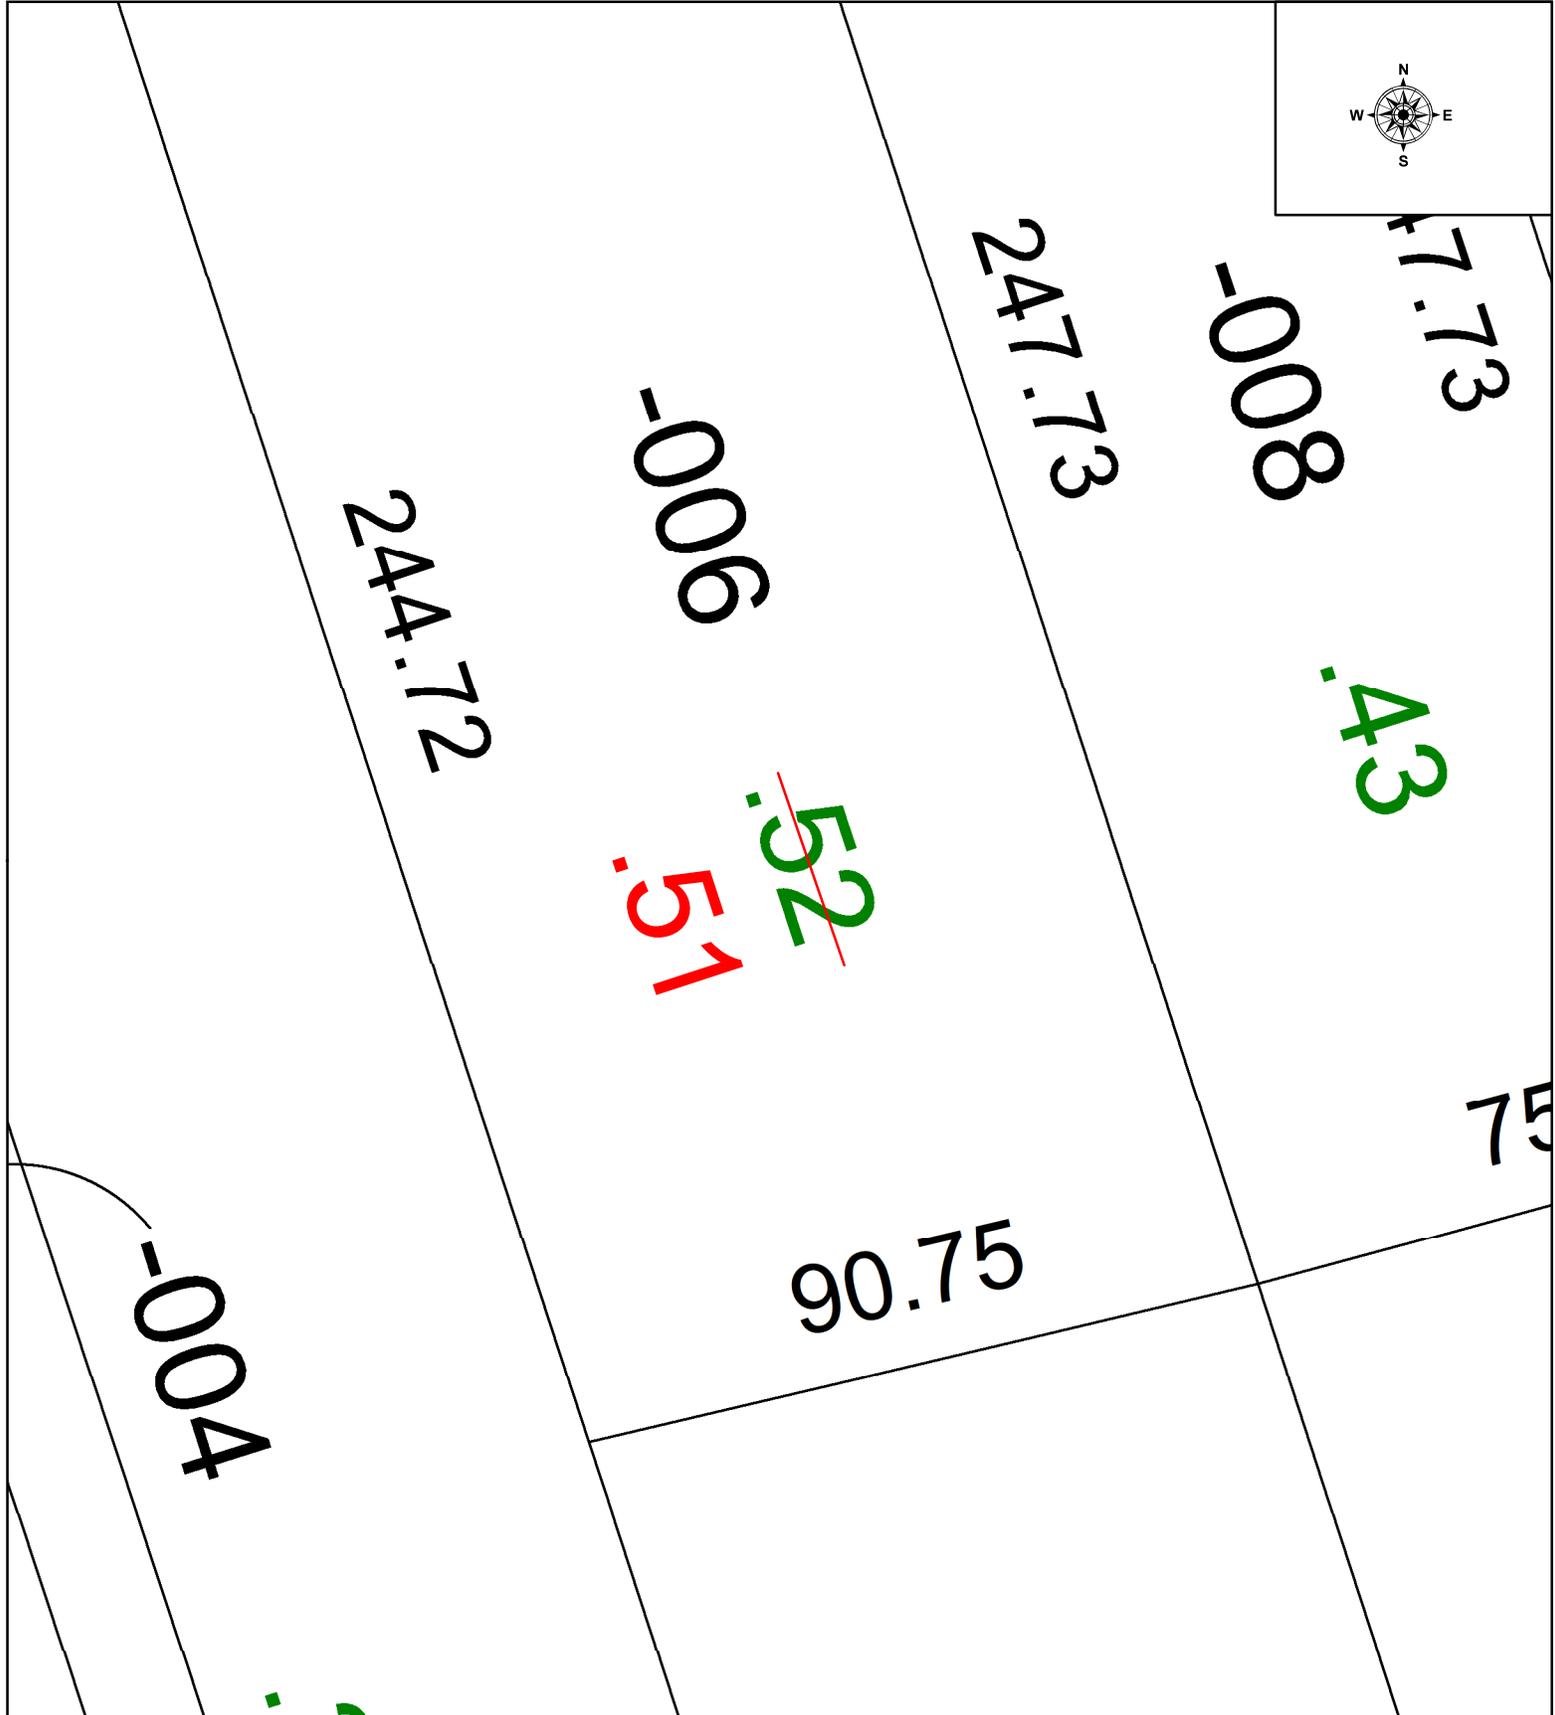

SPLITS/DEEDS PROCESSED
 LORAIN COUNTY TAX MAP DEPARTMENT
 226 MIDDLE AVE. ELYRIA, OH

SURVEYED BY: _____ N/A SURVEY # N/A
 CLOSURE: _____ 1: _____
 MAP PAGE(S): _____ 10-00-006
 APPROVED BY: _____ WRZ DATE: 2/17/2026
 SCALE: 1" = 25' PRIOR INSTRUMENT: #2013-0458517