
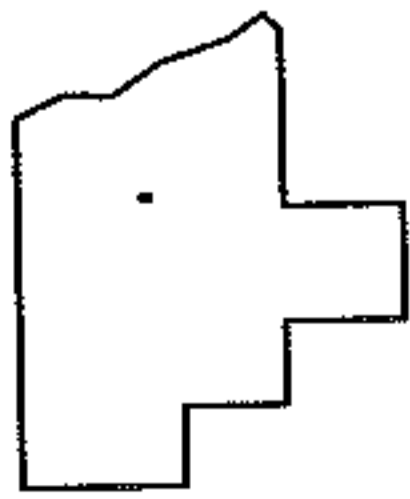
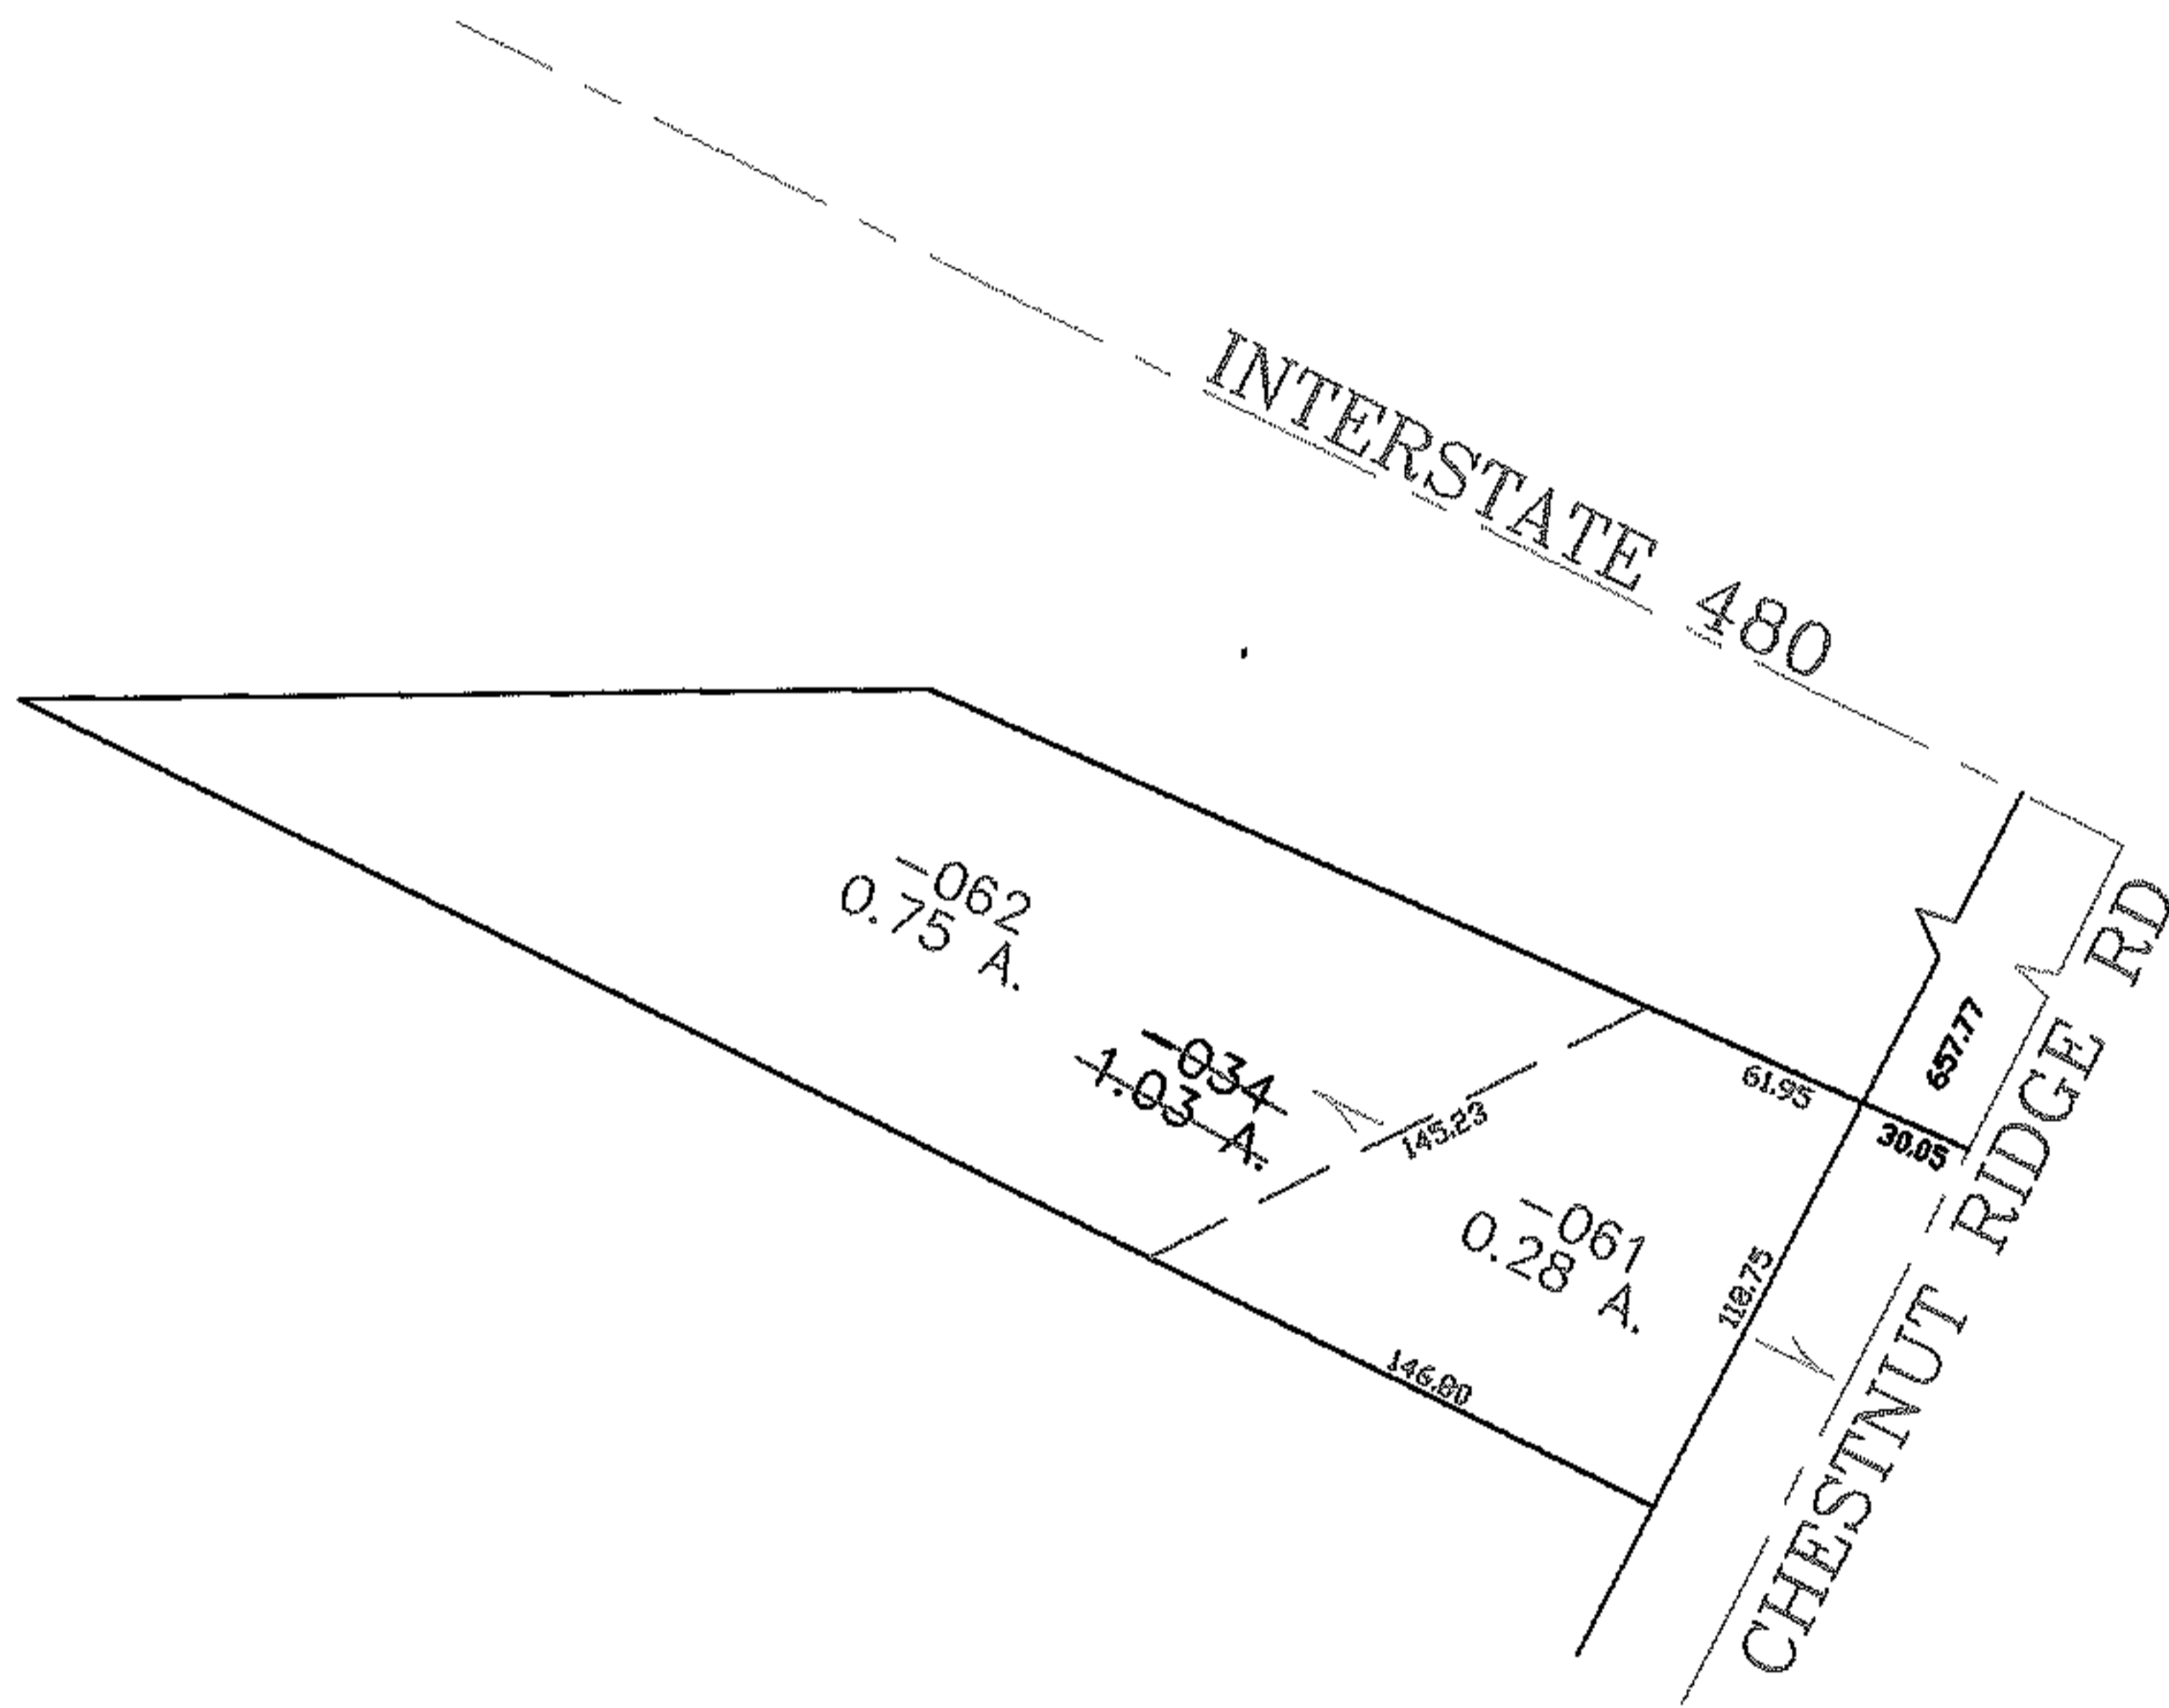


PARENT PARCEL: 07-00-010-106-034

CHILD PARCEL: 07-00-010-106-061, -062

STARTING POINT: CENTERLINE OF CHESTNUT RIDGE RD & INTERSTATE 480

06-00151

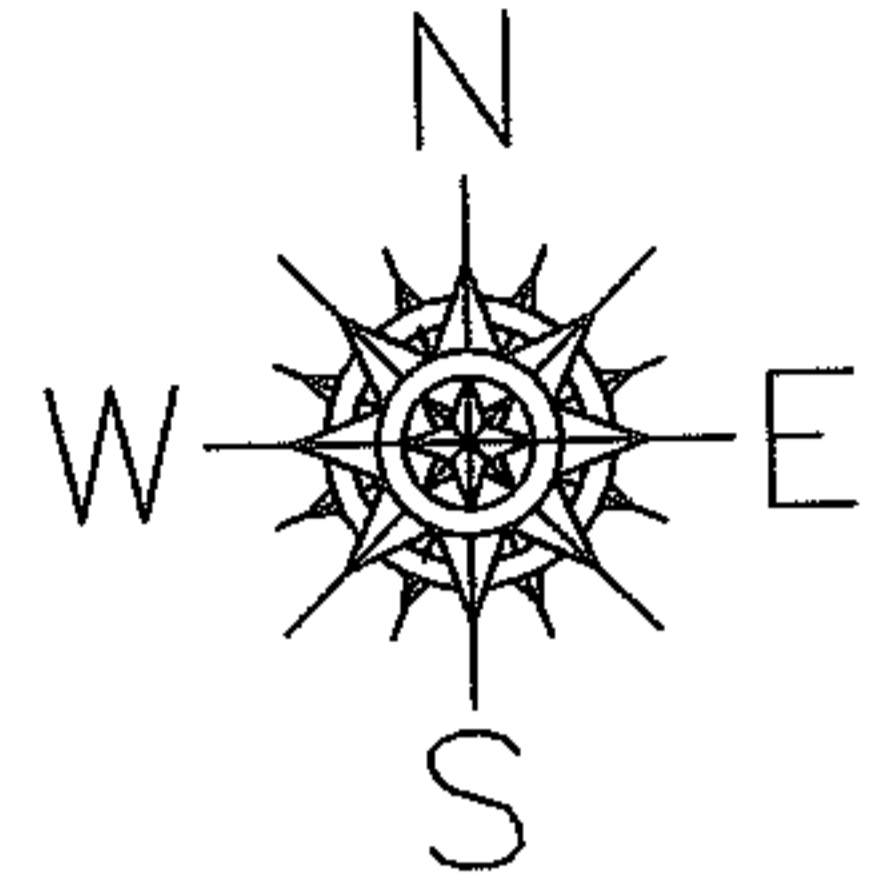

SPLITS/DEEDS PROCESSED

LORAIN COUNTY TAX MAP DEPARTMENT
226 MIDDLE AVE. ELYRIA, OHIO

SURVEYED BY: JAMES KENYON

CLOSURE: 0.00 : 10.000

MAP PAGE(S): 07-00-010-A

APPROVED BY: JAH DATE: 7-31-06

SCALE: 1" = 100 PRIOR INSTRUMENT: DV 1068/871