
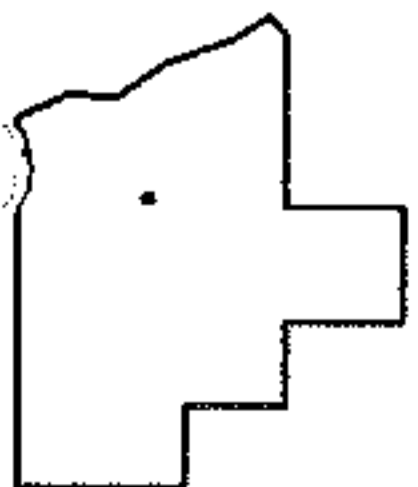
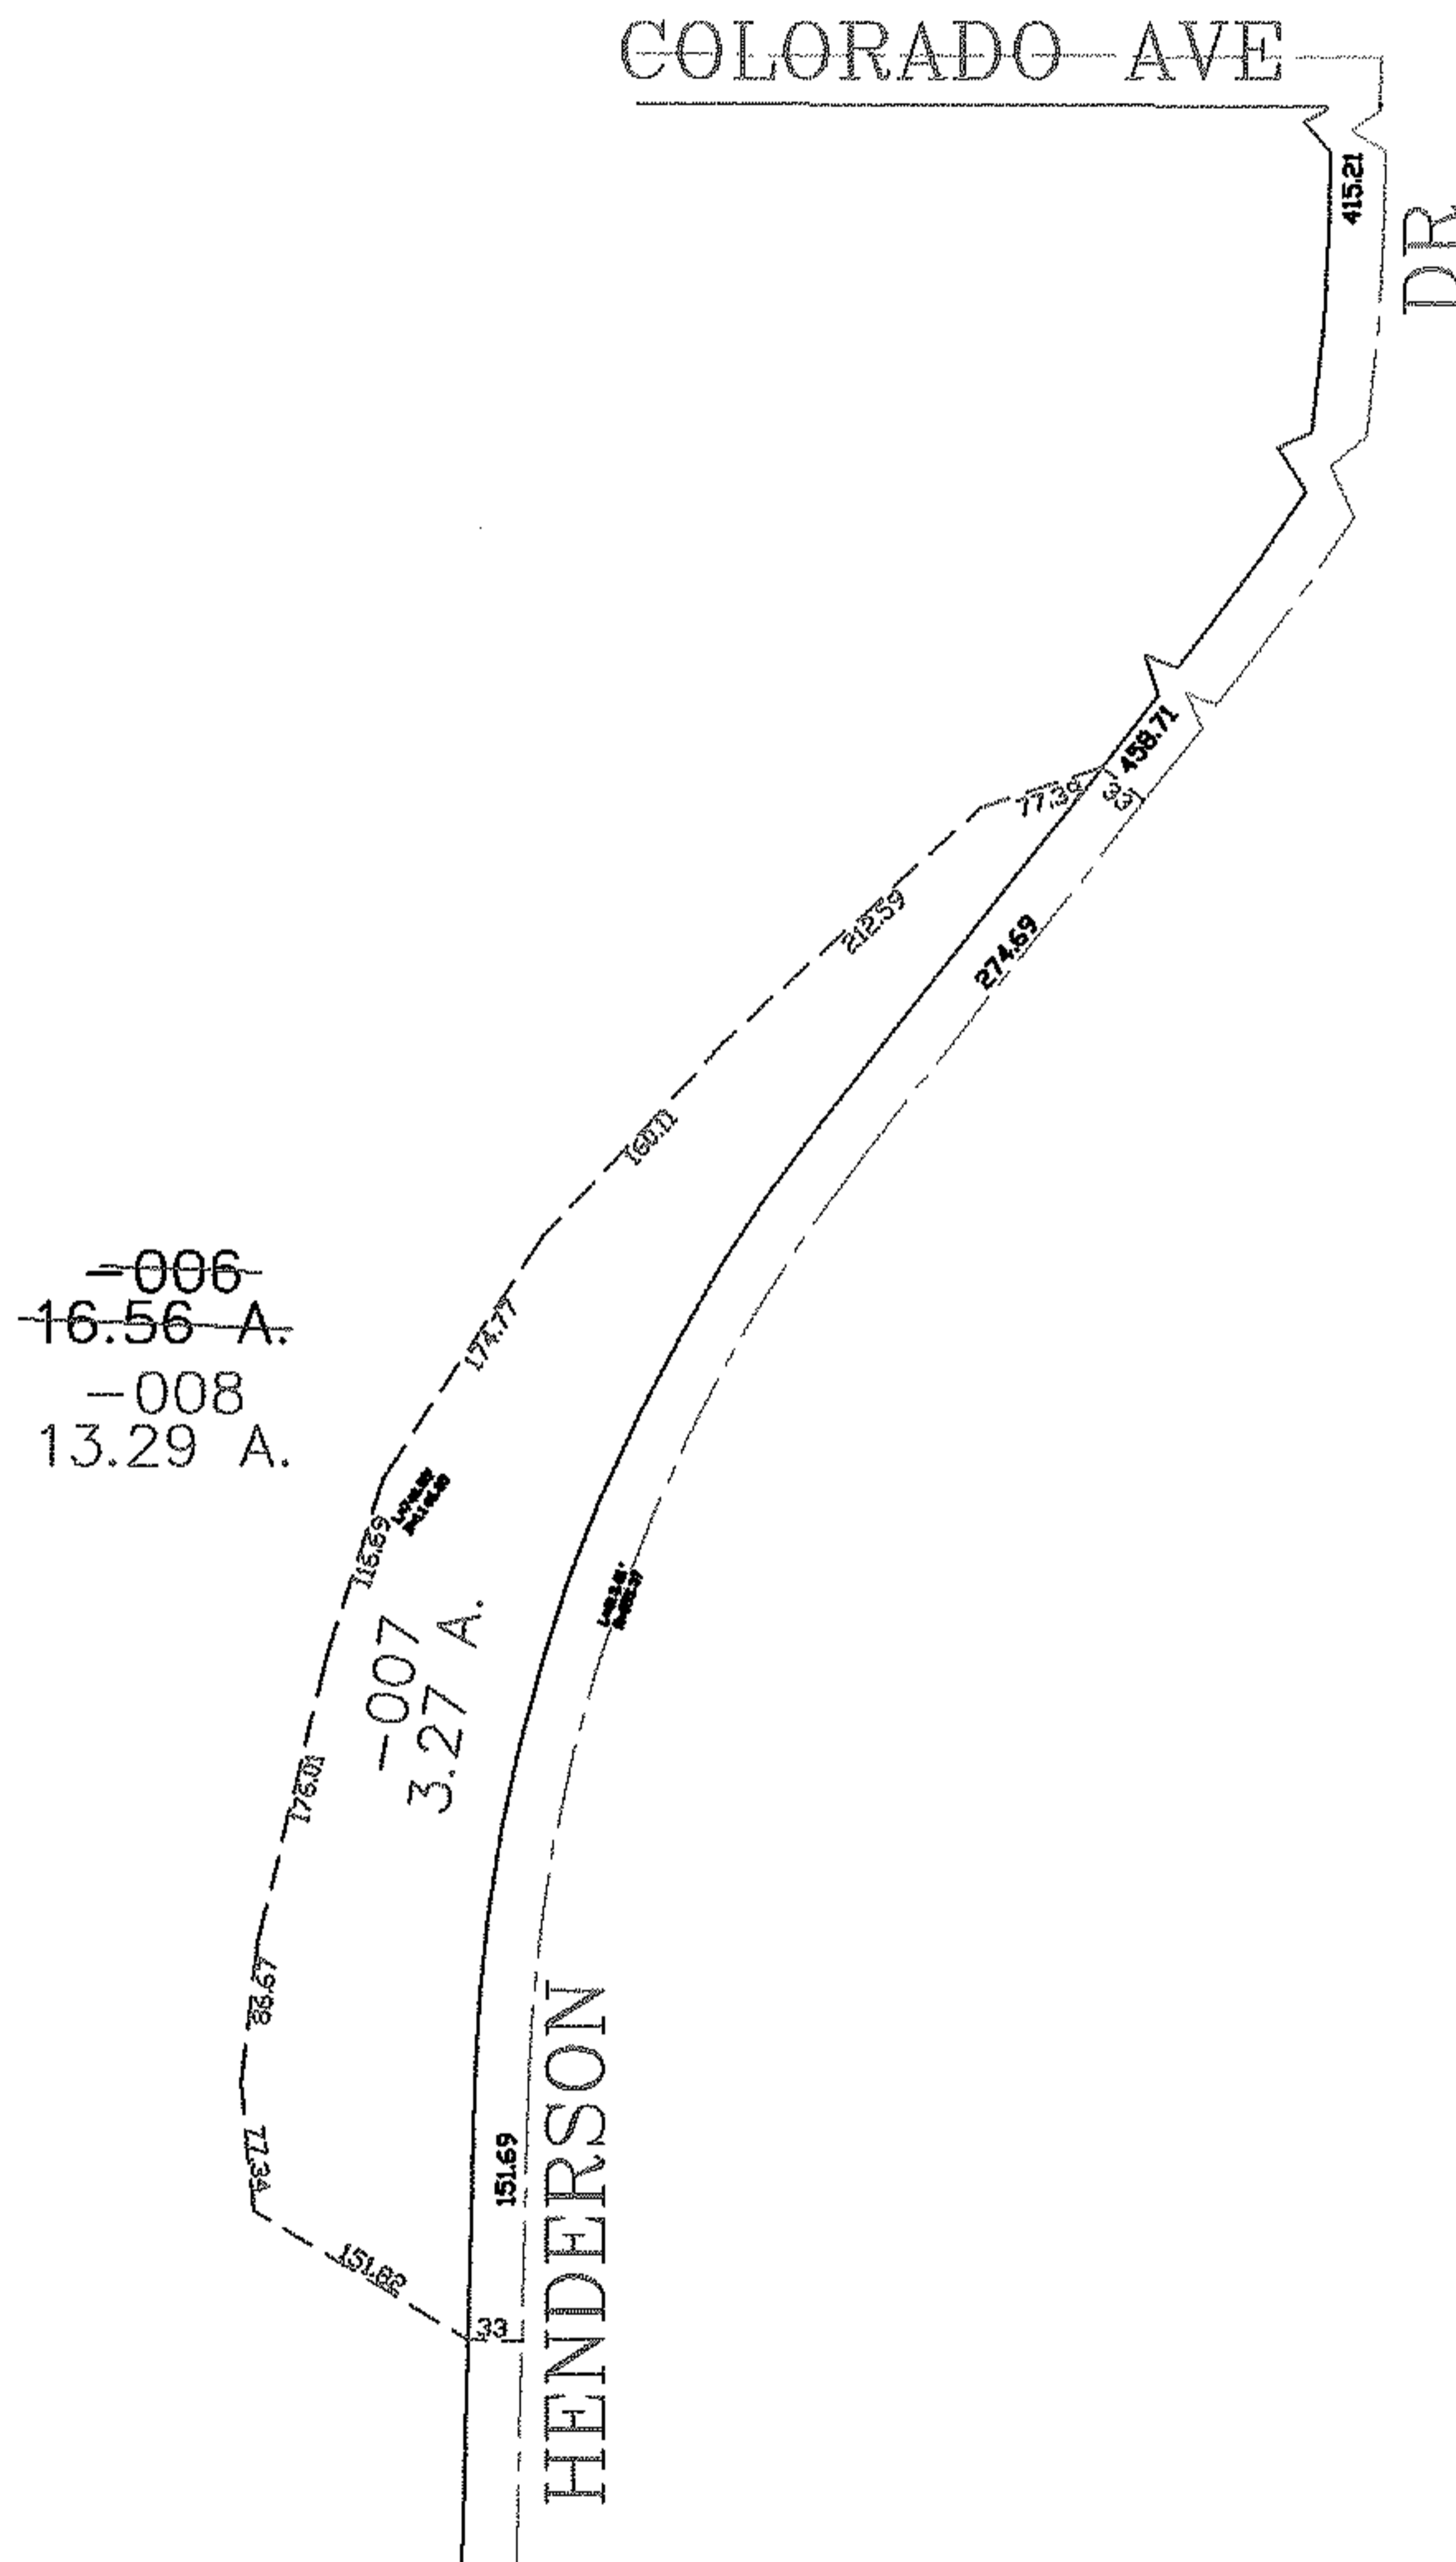


PARENT PARCEL: 02-00-052-000-006

CHILD PARCEL: 02-00-052-000-007, -008

STARTING POINT: CENTERLINE OF COLORADO AVE & HENDERSON RD

06-00152

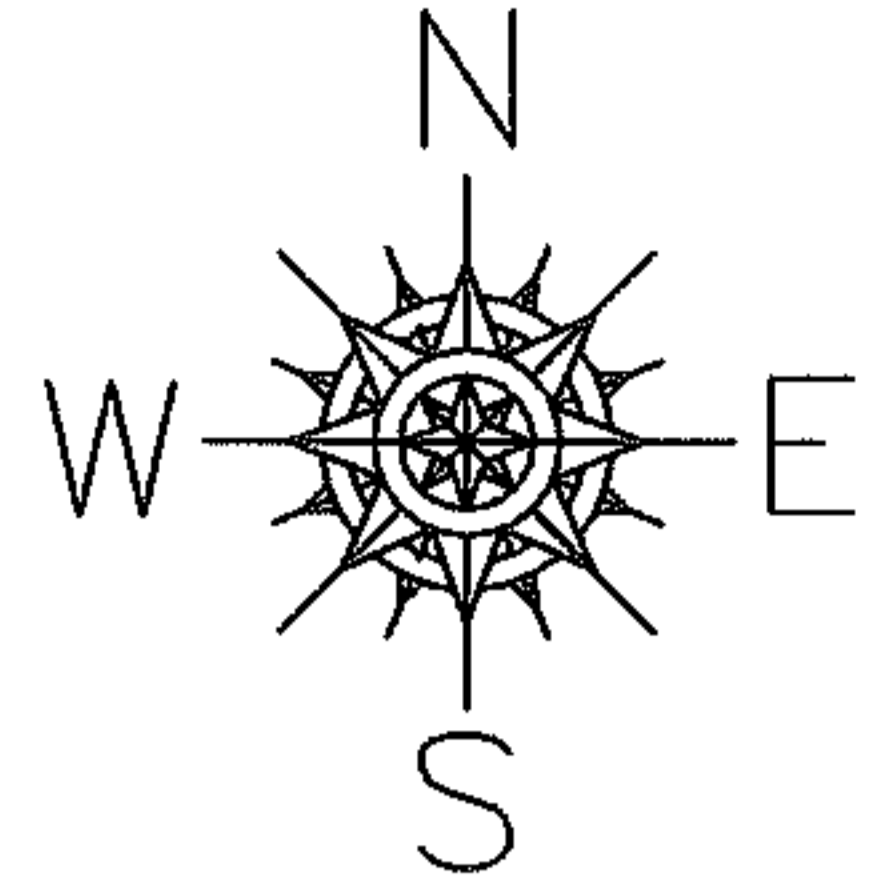

SPLITS/DEEDS PROCESSED
 LORAIN COUNTY TAX MAP DEPARTMENT
 226 MIDDLE AVE. ELYRIA, OHIO

SURVEYED BY: ROBERT J MCAULEY
 CLOSURE: 0.00 : 10.000
 MAP PAGE(S): 02-00-052
 APPROVED BY: JAH DATE: 8-22-06
 SCALE: 1" = 200 PRIOR INSTRUMENT: DV 687/364