
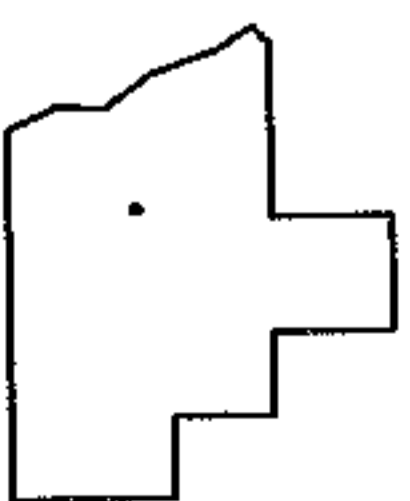
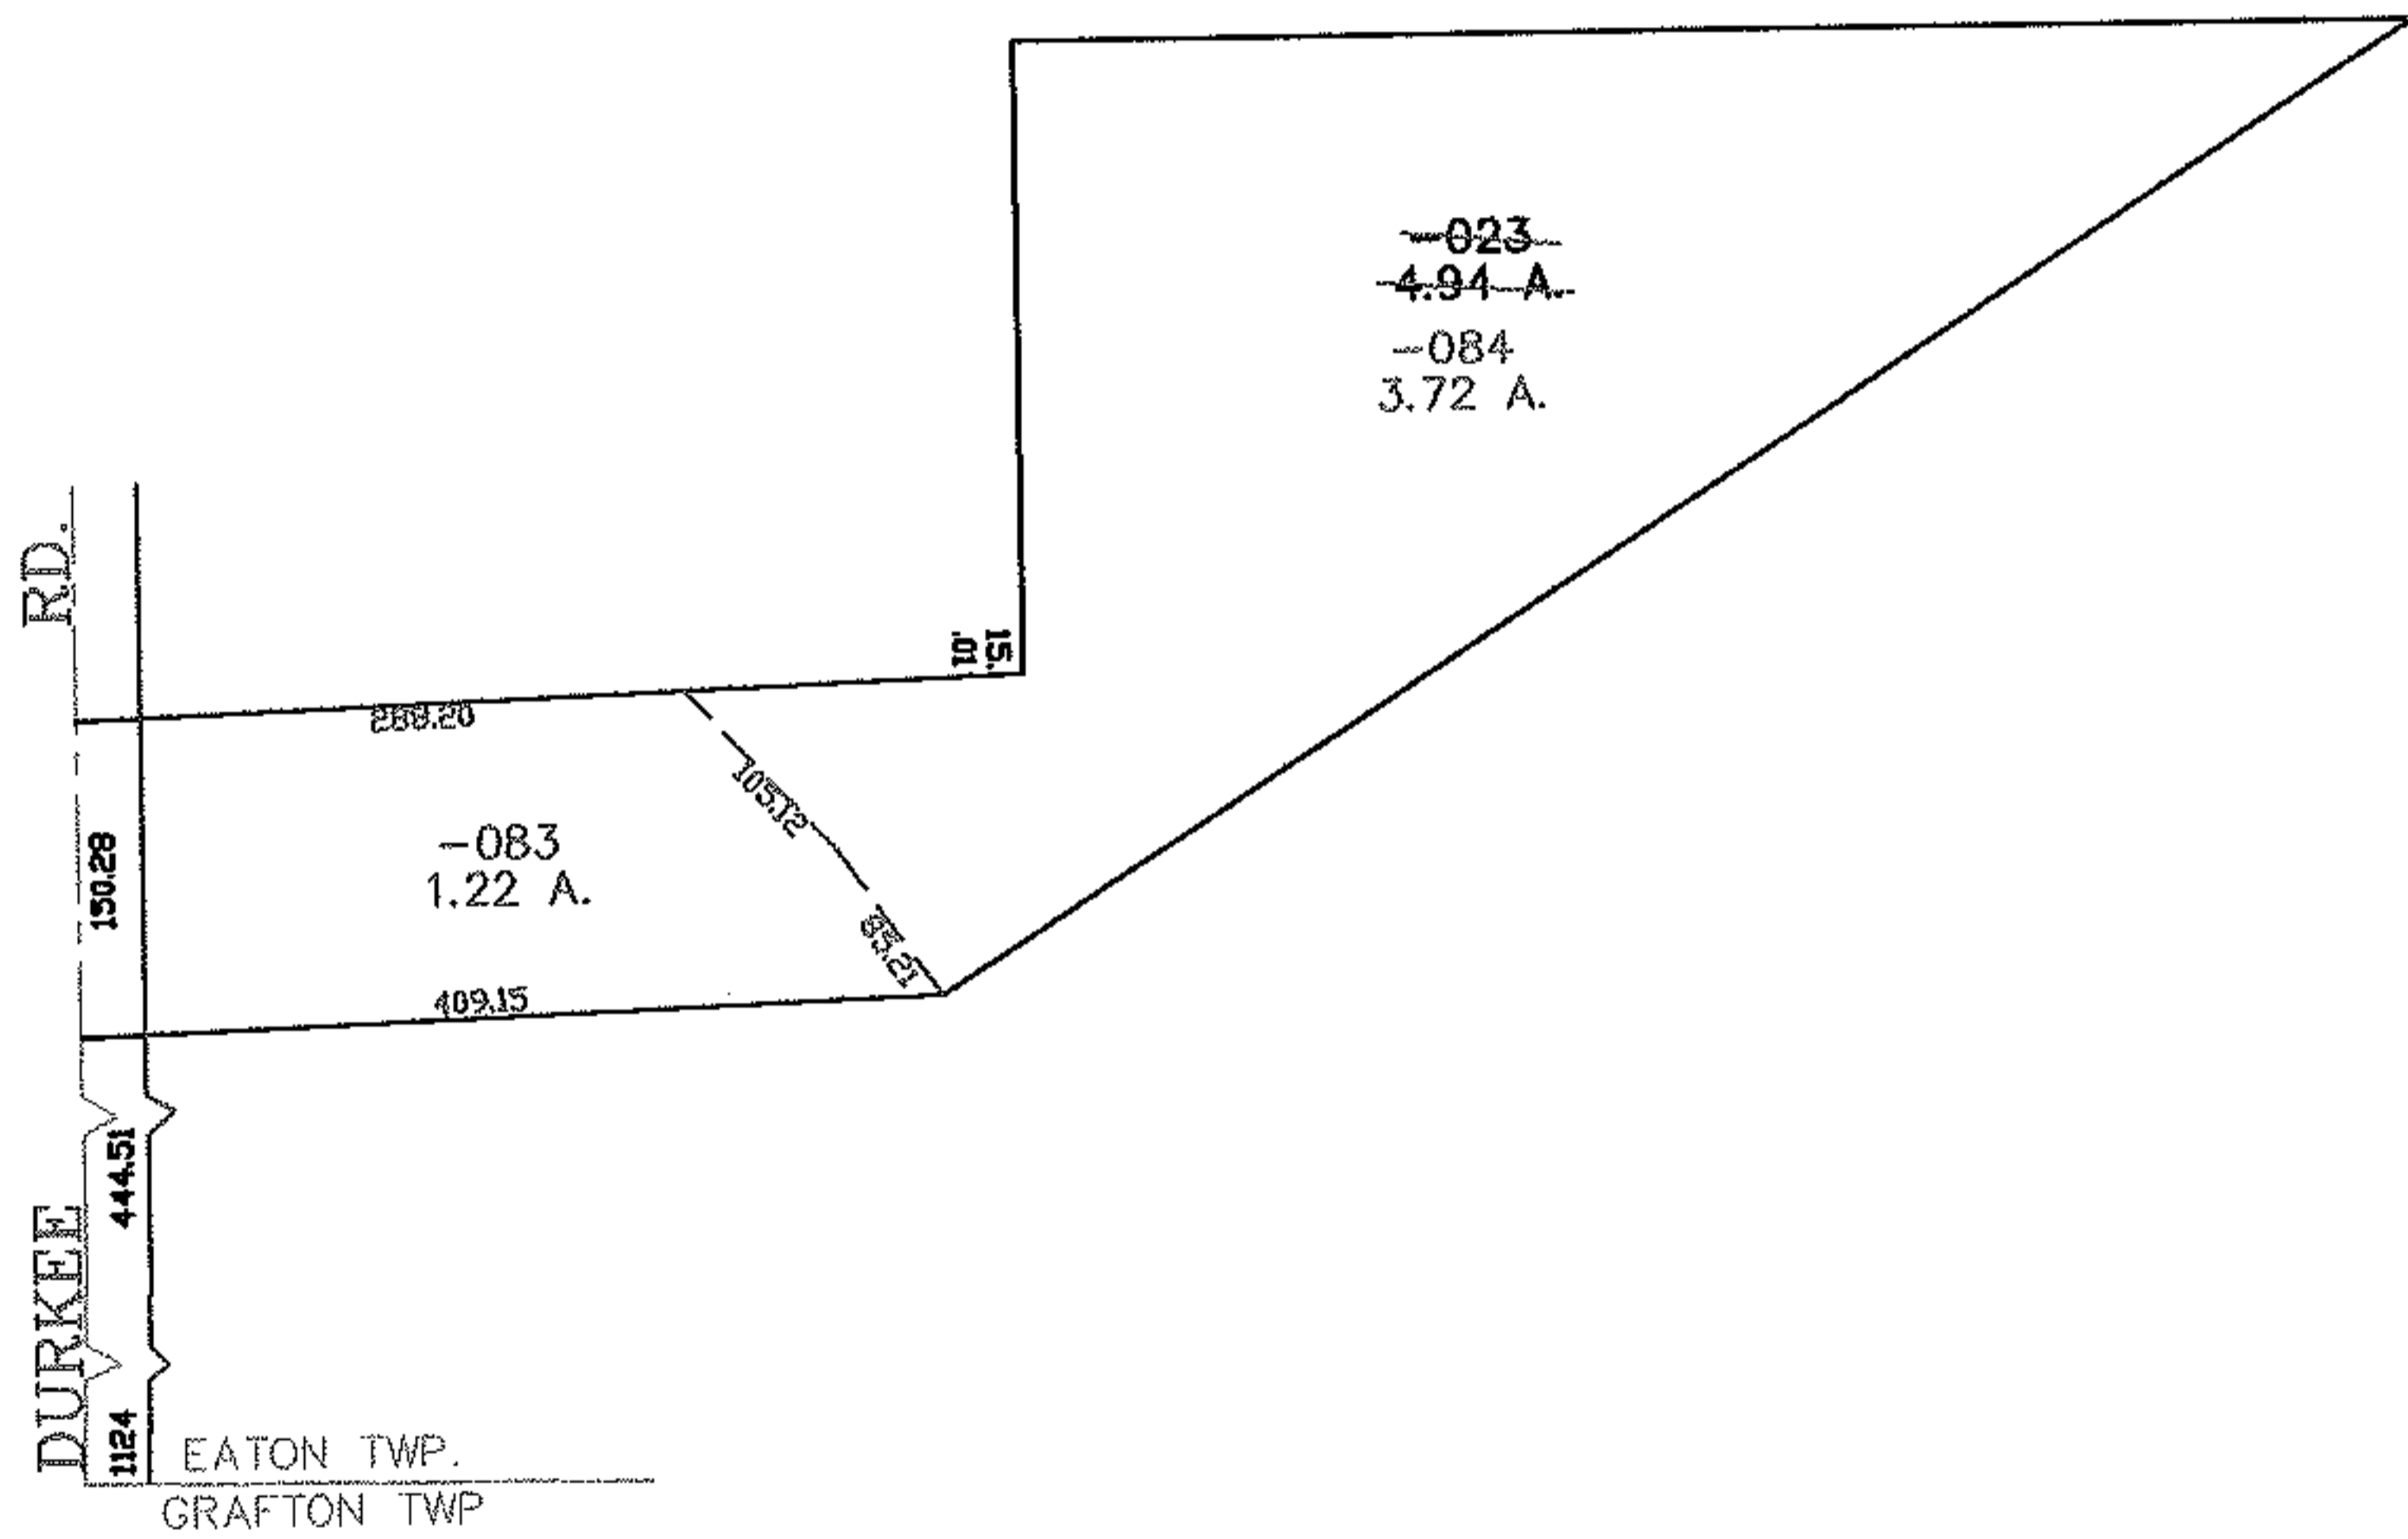


PARENT PARCEL: 11-00-080-000-023

CHILD PARCEL: 11-00-080-000-083, -084

STARTING POINT: CENTERLINE OF DURKEE RD. & O.L. 80

06-00153

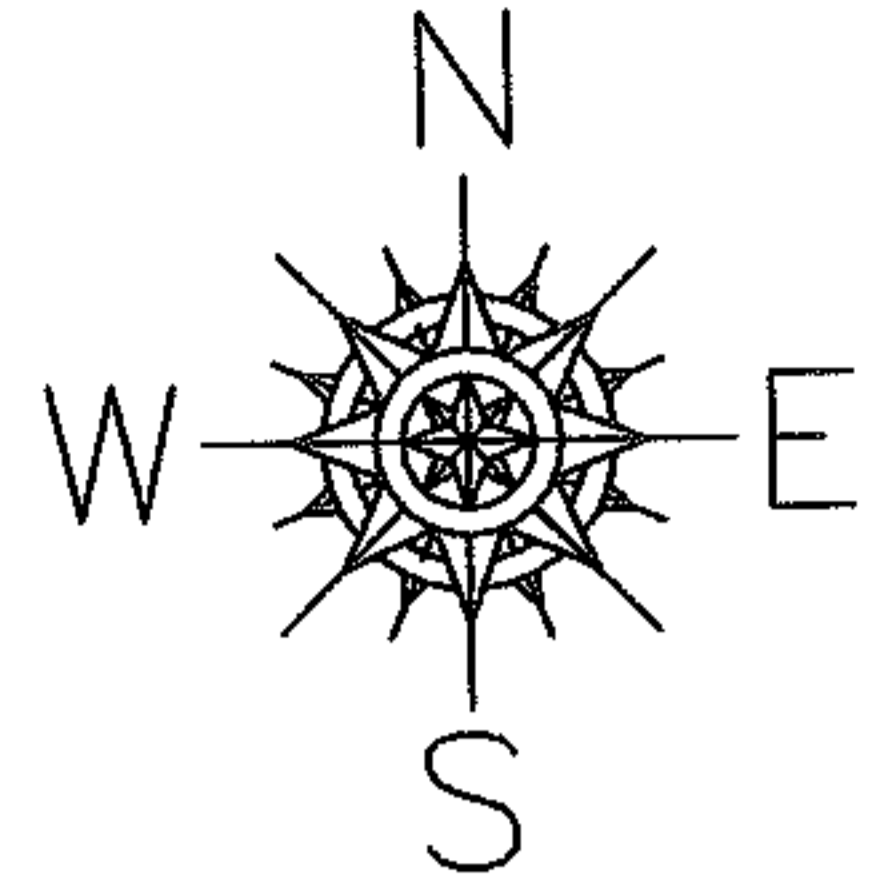

SPLITS/DEEDS PROCESSED
LORAIN COUNTY TAX MAP DEPARTMENT
226 MIDDLE AVE. ELYRIA, OHIO

SURVEYED BY: CHARLES P. UNTERREINER
 CLOSURE: 0.00 : 10,000
 MAP PAGE(S): 11-00-080-A
 APPROVED BY: JAH DATE: 9-7-06
 SCALE: 1" = 200 PRIOR INSTRUMENT: DV 1414/777