
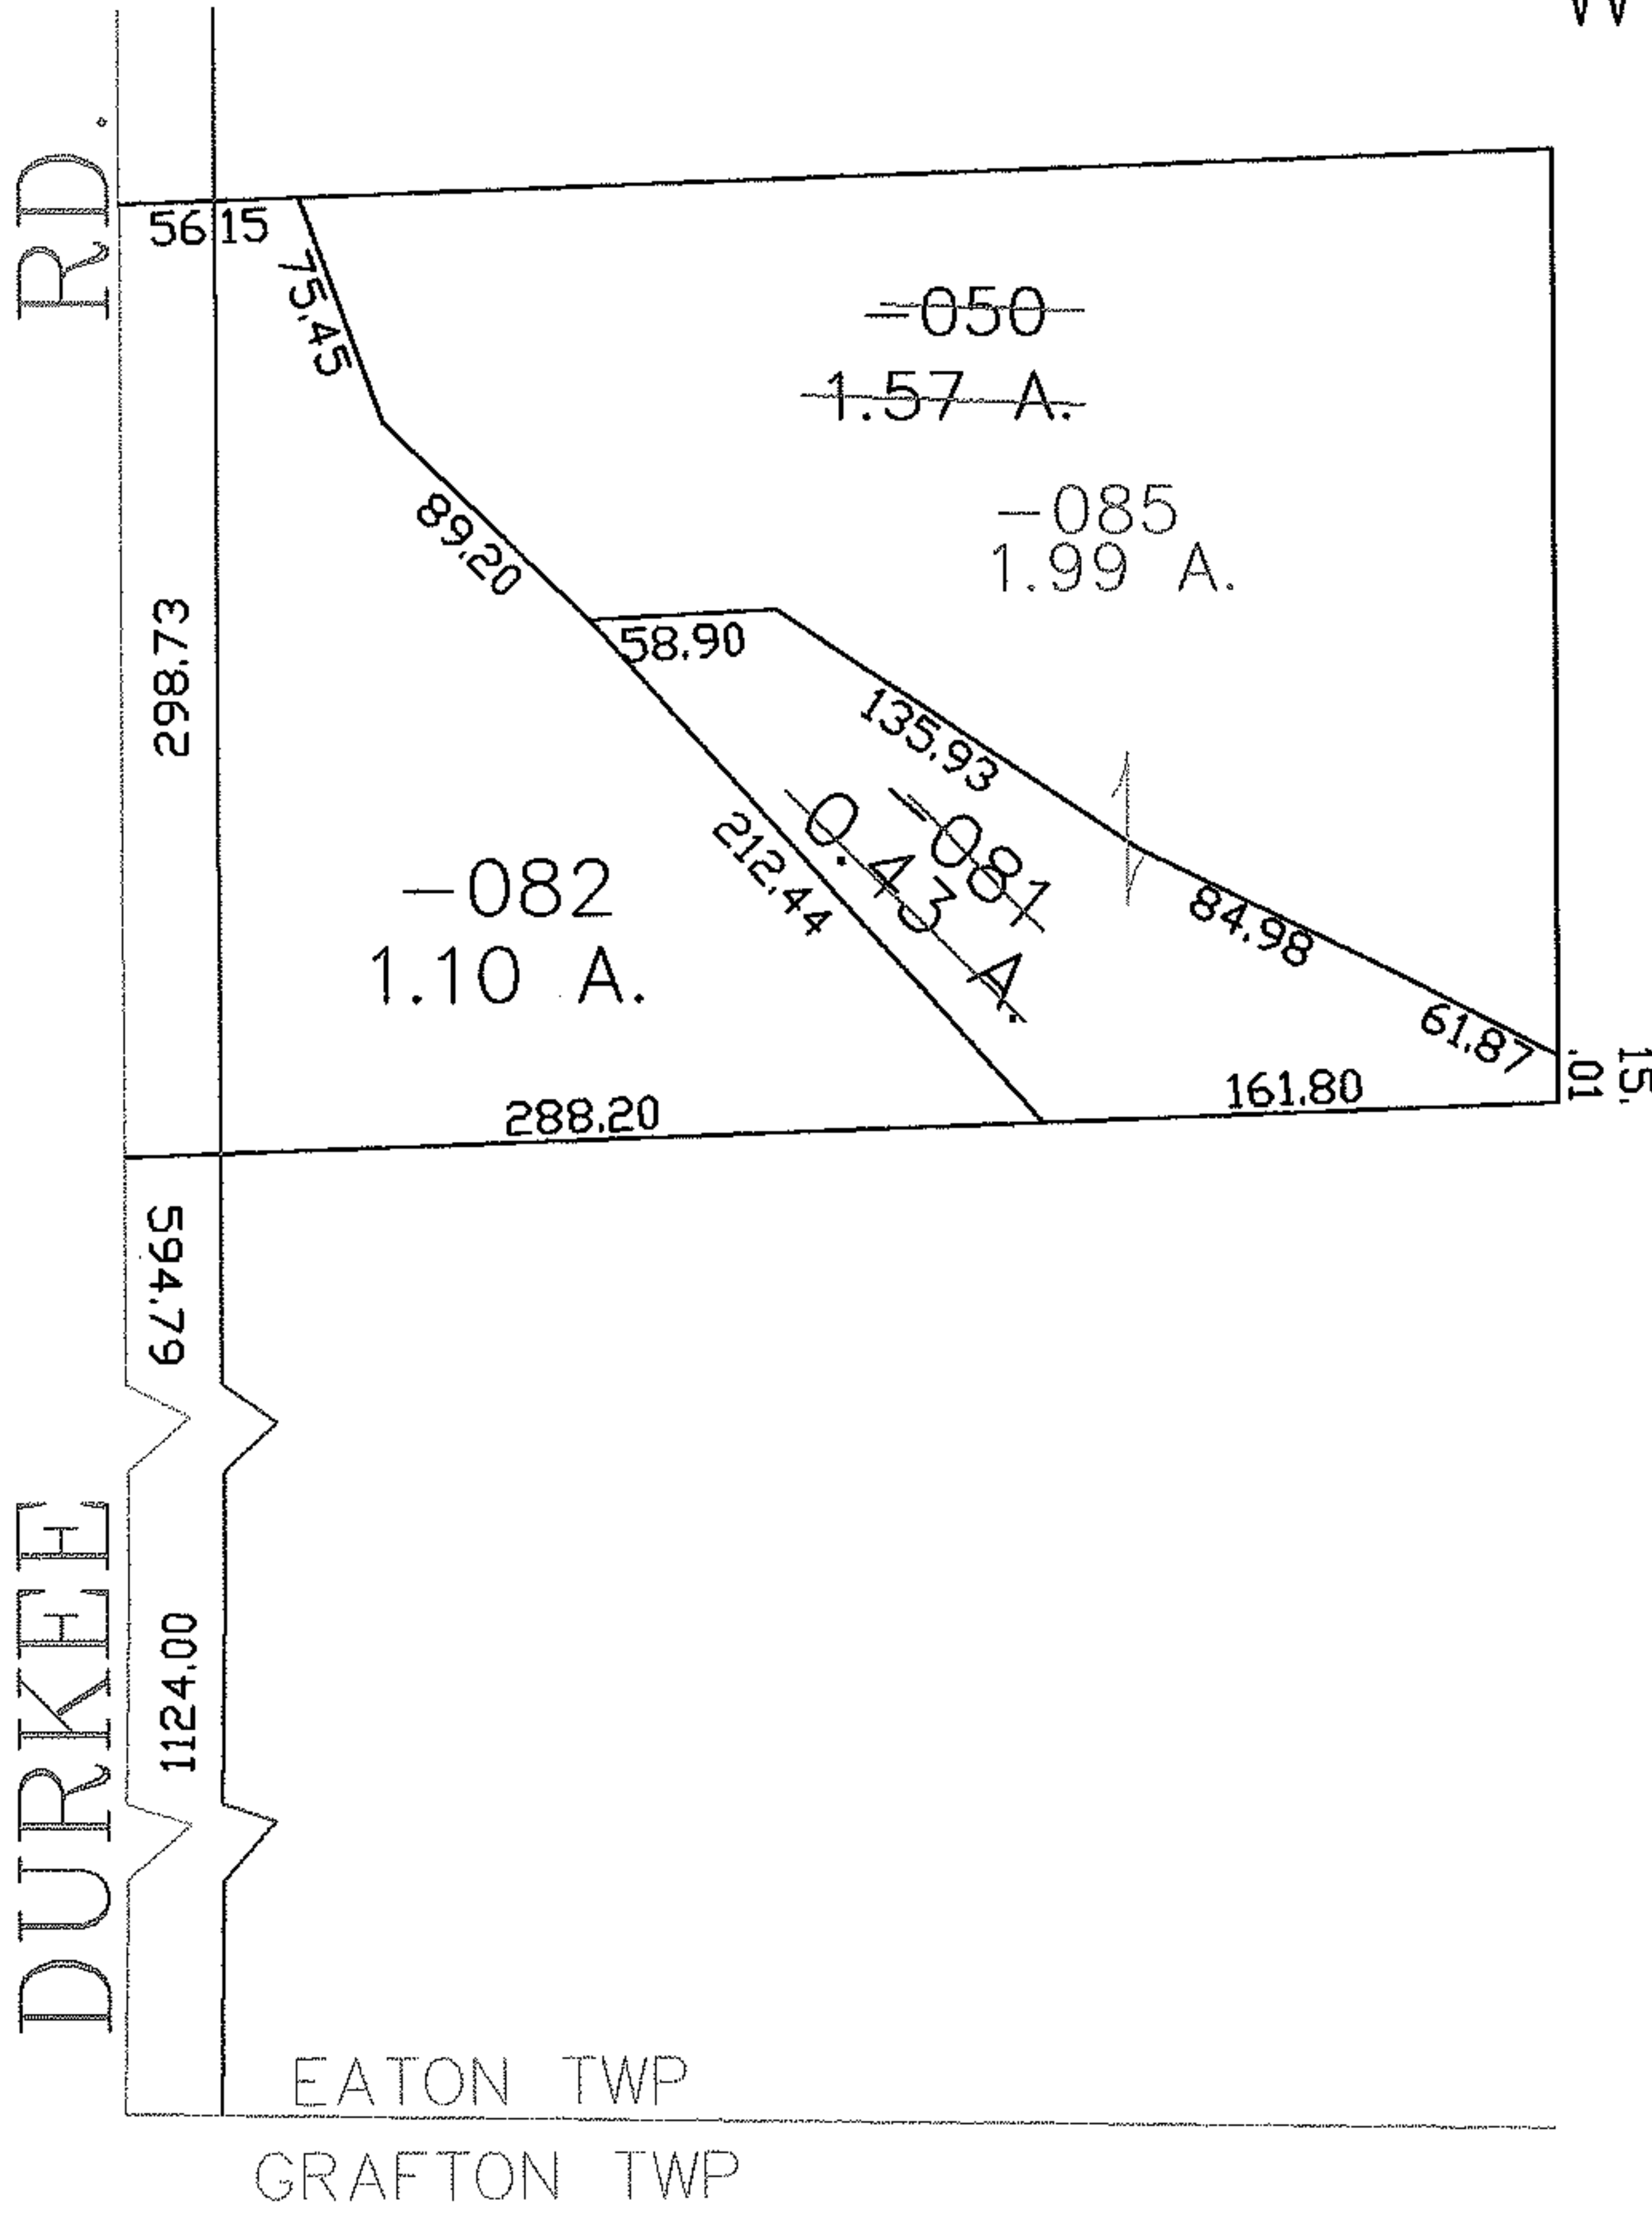


PARENT PARCEL: 11-00-080-000-081 & -050

CHILD PARCEL: 11-00-080-000-085

STARTING POINT: CENTERLINE OF DURKEE RD & EATON TWP LINE

06-00154

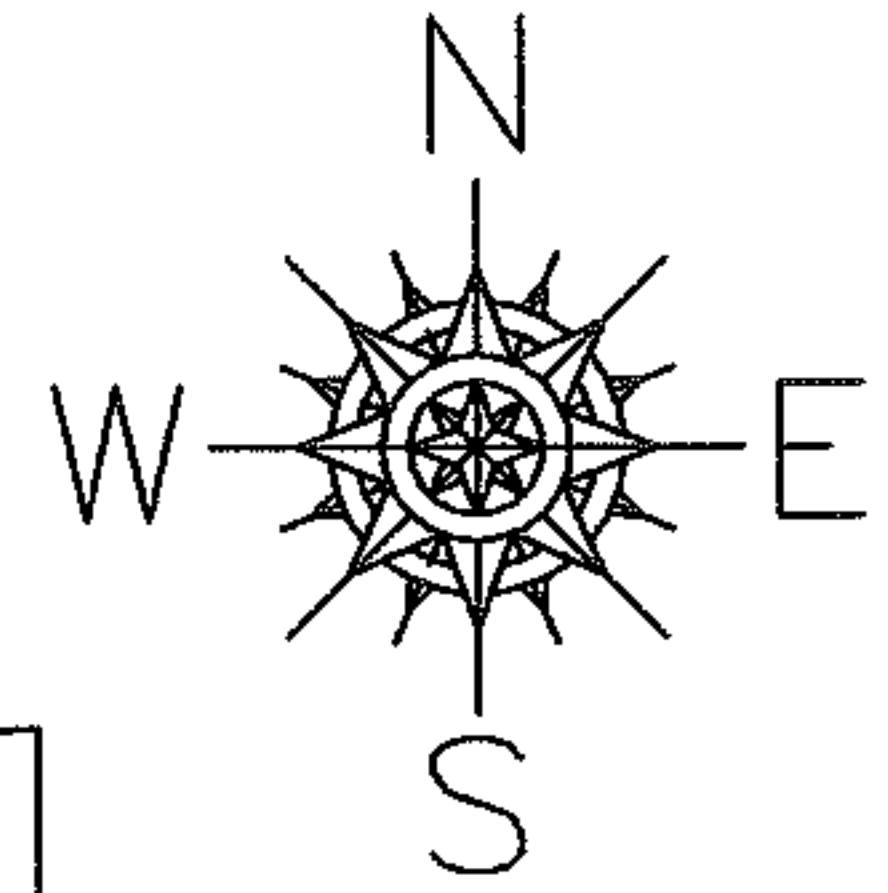

SPLITS/DEEDS PROCESSED

LORAIN COUNTY TAX MAP DEPARTMENT
226 MIDDLE AVE. ELYRIA, OHIO

SURVEYED BY: CHARLES P UNTERREINER

CLOSURE: 0.00 : 10.000

MAP PAGE(S): 11-00-080-A

APPROVED BY: JAH DATE: 10-10-06

SCALE: 1" = 100 PRIOR INSTRUMENT: 20050078328