


PARENT PARCEL: 20-05-013-000-003

CHILD PARCEL: 20-05-013-000-008, -009

STARTING POINT: CENTERLINE OF NEW LONDON LAFAYETTE RD & ASHLAND KIPTON RD

06-00157

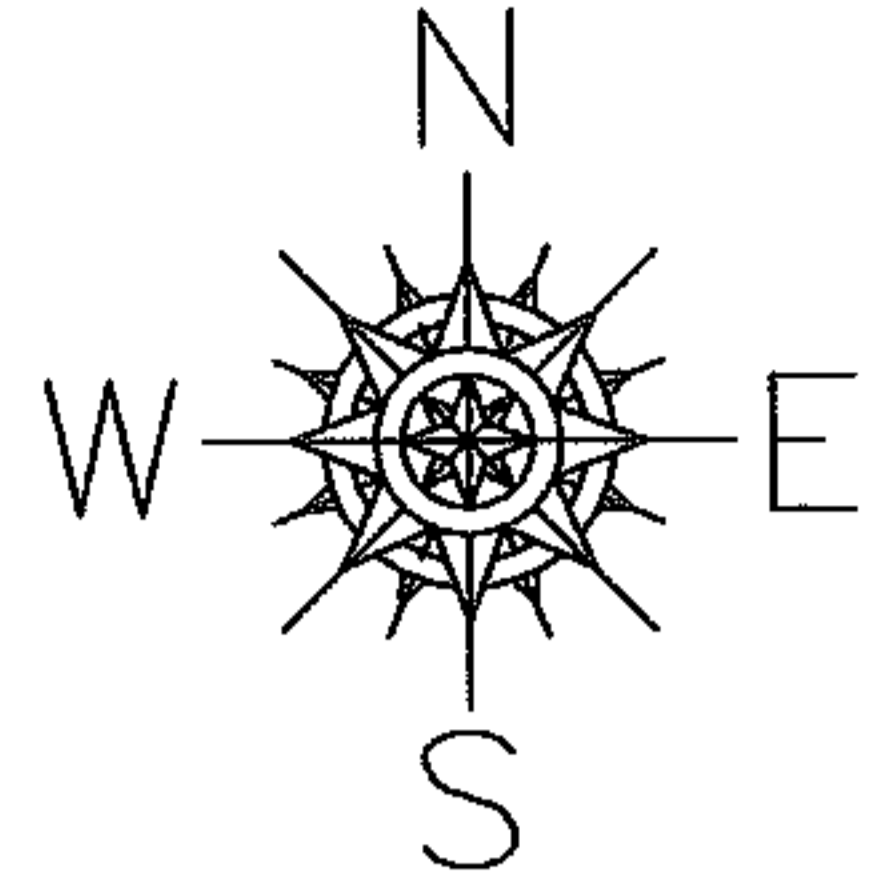

ASHLAND KIPTON RD

~~=003~~
~~53.50 A.~~
~~-009~~
53.06 A.

-008
0.44 A.

NEW LONDON LAFAYETTE RD

885.32


60.06

202.35

412.86

215.39

30.00

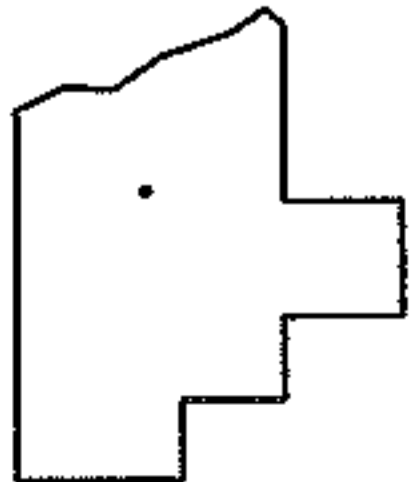

SPLITS/DEEDS PROCESSED

LORAIN COUNTY TAX MAP DEPARTMENT
226 MIDDLE AVE. ELYRIA, OHIO

SURVEYED BY: WILLIAM THOMAS

CLOSURE: 0.00 : 10.000

MAP PAGE(S): 20-G

APPROVED BY: JAH DATE: 12-12-06

SCALE: 1" = 100' PRIOR INSTRUMENT: 20010779519