


PARENT PARCEL: 21-05-033-000-003

CHILD PARCEL: 21-05-033-000-004, -005

STARTING POINT: CENTERLINE OF NEW LONDON LAFAYETTE RD * O.L. 33

06-00160

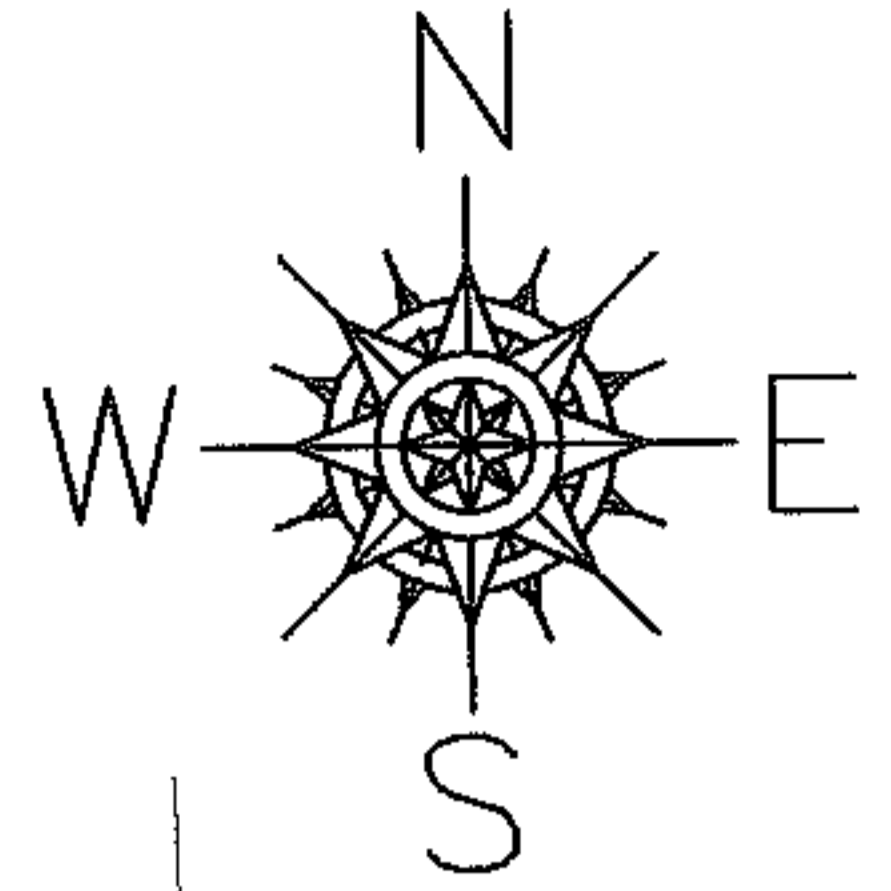


~~-003~~
~~68.01 A.~~
-005
67.79 A.

-004
0.22 A.
125.40
42.43
64.75

O.L. 33
O.L. 25

NEW LONDON LAFAYETTE RD
30.00
214.48
44.98

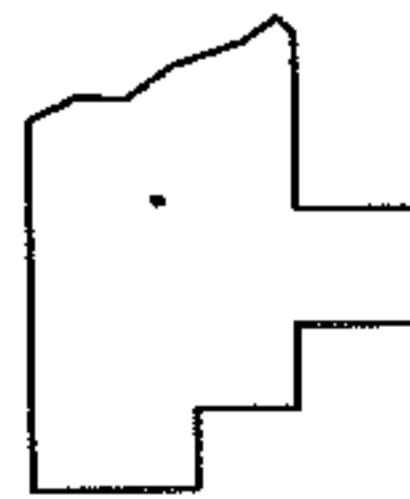

SPLITS/DEEDS PROCESSED
LORAIN COUNTY TAX MAP DEPARTMENT
226 MIDDLE AVE. ELYRIA, OHIO

SURVEYED BY: WILLIAM THOMAS
CLOSURE: 0.00 : 10.000
MAP PAGE(S): 21-A
APPROVED BY: JAH DATE: 12-19-06
SCALE: 1" = 100 PRIOR INSTRUMENT: DV 446/66