


PARENT PARCEL: 21-05-009-000-016

CHILD PARCEL: 21-05-009-000-021, -022

STARTING POINT: CENTERLINE OF NEW LONDON LAFAYETTE RD & CLARK RD

06-00164

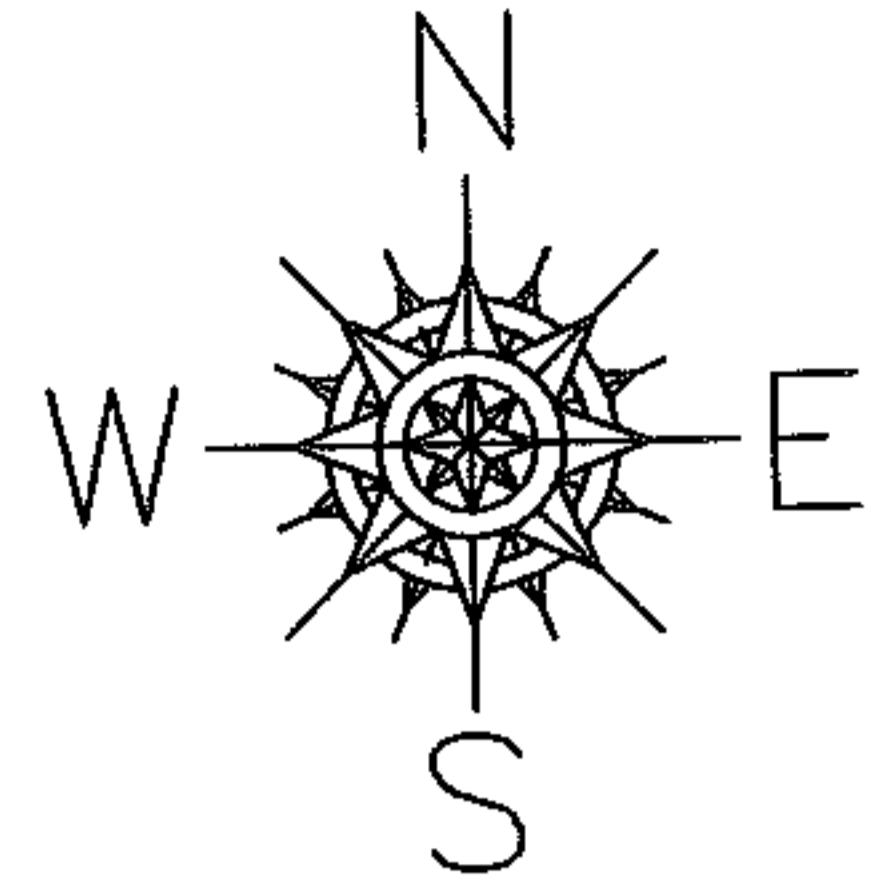

CLARK RD

~~-016~~  
~~50.45 A.~~  
~~-022~~  
49.98 A.

35.00  
168.21 -021 0.47 A. 155.21

1123.85

30.00

347.96

48.53

NEW LONDON LAFAYETTE RD

RD

SPLITS/DEEDS PROCESSED

LORAIN COUNTY TAX MAP DEPARTMENT  
226 MIDDLE AVE. ELYRIA, OHIO

SURVEYED BY: WILLIAM THOMAS

CLOSURE: 0.00 : 10.000

MAP PAGE(S): 21-B

APPROVED BY: JAH DATE: 12-19-06

SCALE: 1" = 100 PRIOR INSTRUMENT: 19990649873