
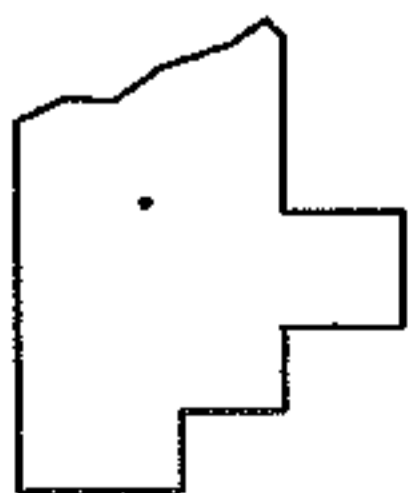
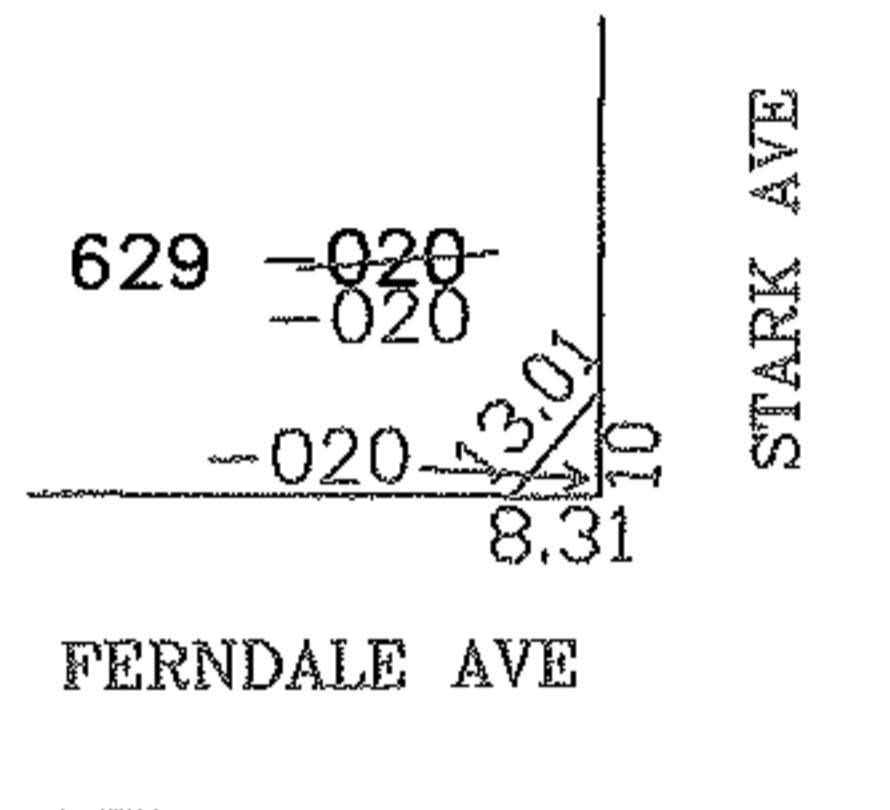


PARENT PARCEL: 03-00-042-107-020

CHILD PARCEL: 3-00-042-107-032, -033

STARTING POINT: SIDELINE OF FERNDALE AVE & STARK AVE

07-00167

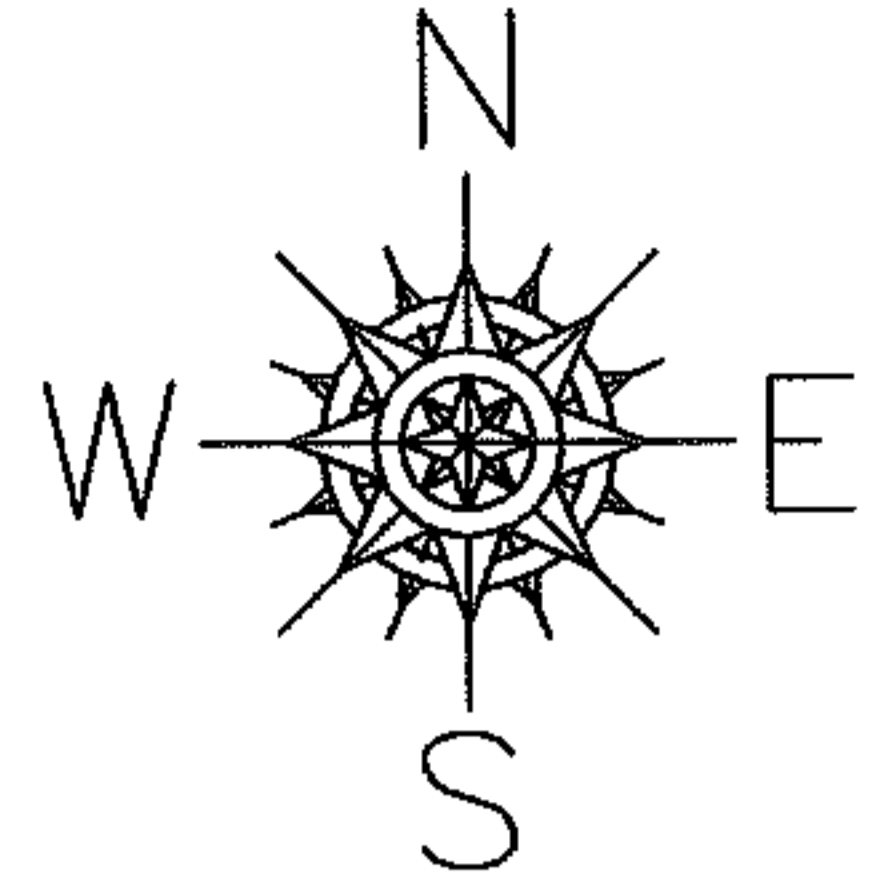

SPLITS/DEEDS PROCESSED

LORAIN COUNTY TAX MAP DEPARTMENT
226 MIDDLE AVE. ELYRIA, OHIO

SURVEYED BY: ROBERT J MCAULEY

CLOSURE: 0.00 ; 10.000

MAP PAGE(S): 03-00-042-A

APPROVED BY: JAH DATE: 3-1-07

SCALE: 1" = 100 PRIOR INSTRUMENT: 20030913510