
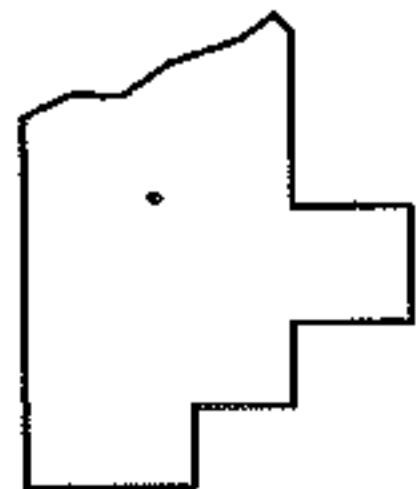
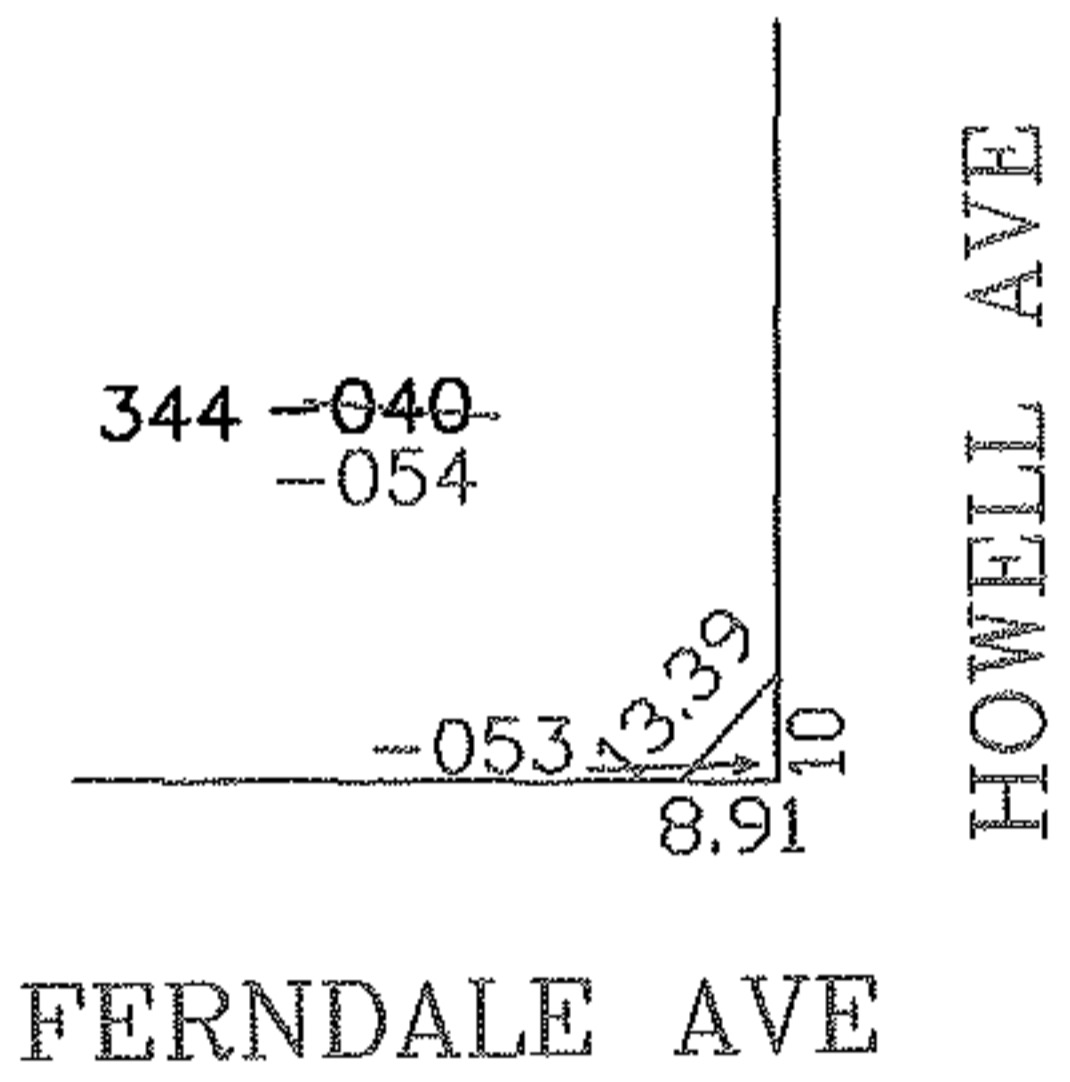


PARENT PARCEL: 03-00-042-109-040

CHILD PARCEL: 03-00-042-109-053, -054

STARTING POINT: SIDELINE OF FERNDALE AVE & HOWELL AVE

07-00171

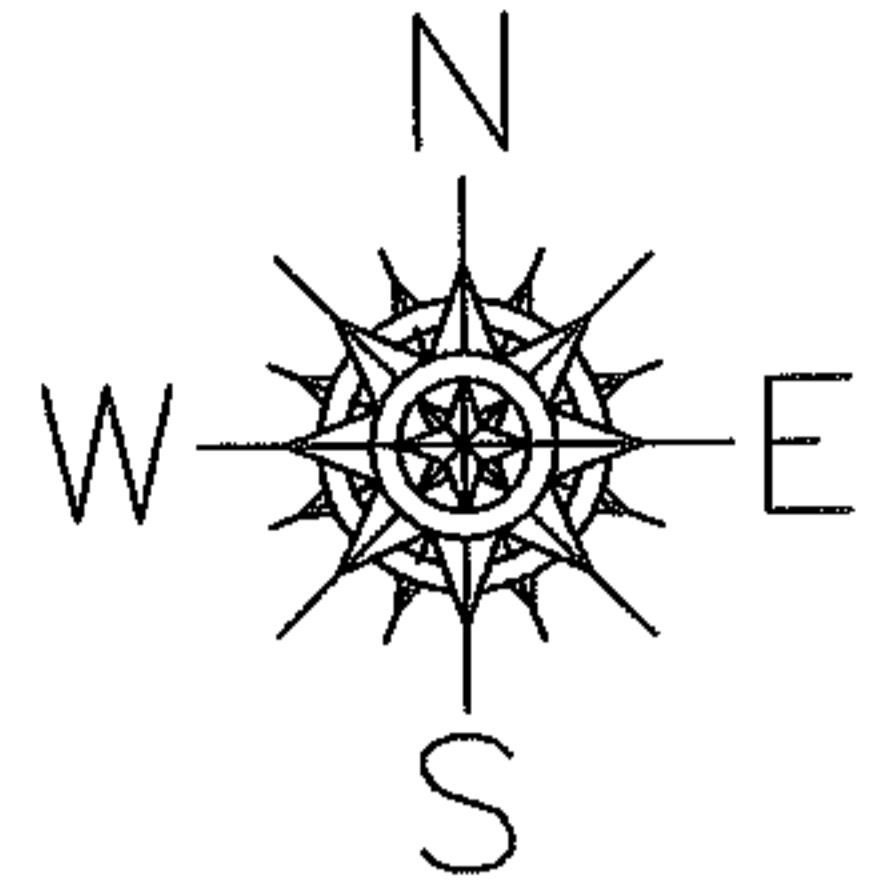

**SPLITS/DEEDS PROCESSED**

LORAIN COUNTY TAX MAP DEPARTMENT  
226 MIDDLE AVE. ELYRIA, OHIO

SURVEYED BY: ROBERT J MCAULEY

CLOSURE: 0.00 : 10.000

MAP PAGE(S): 03-00-042-A

APPROVED BY: JAH DATE: 3-1-07

SCALE: 1" = 100' PRIOR INSTRUMENT: DV 970/429