
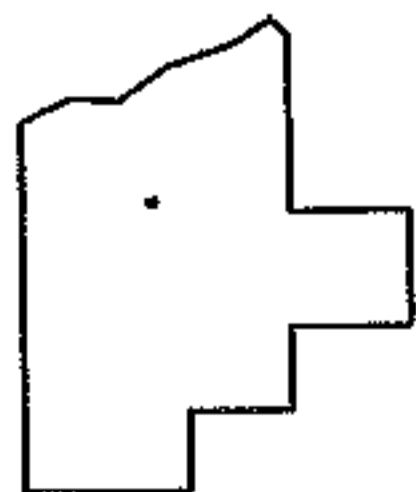
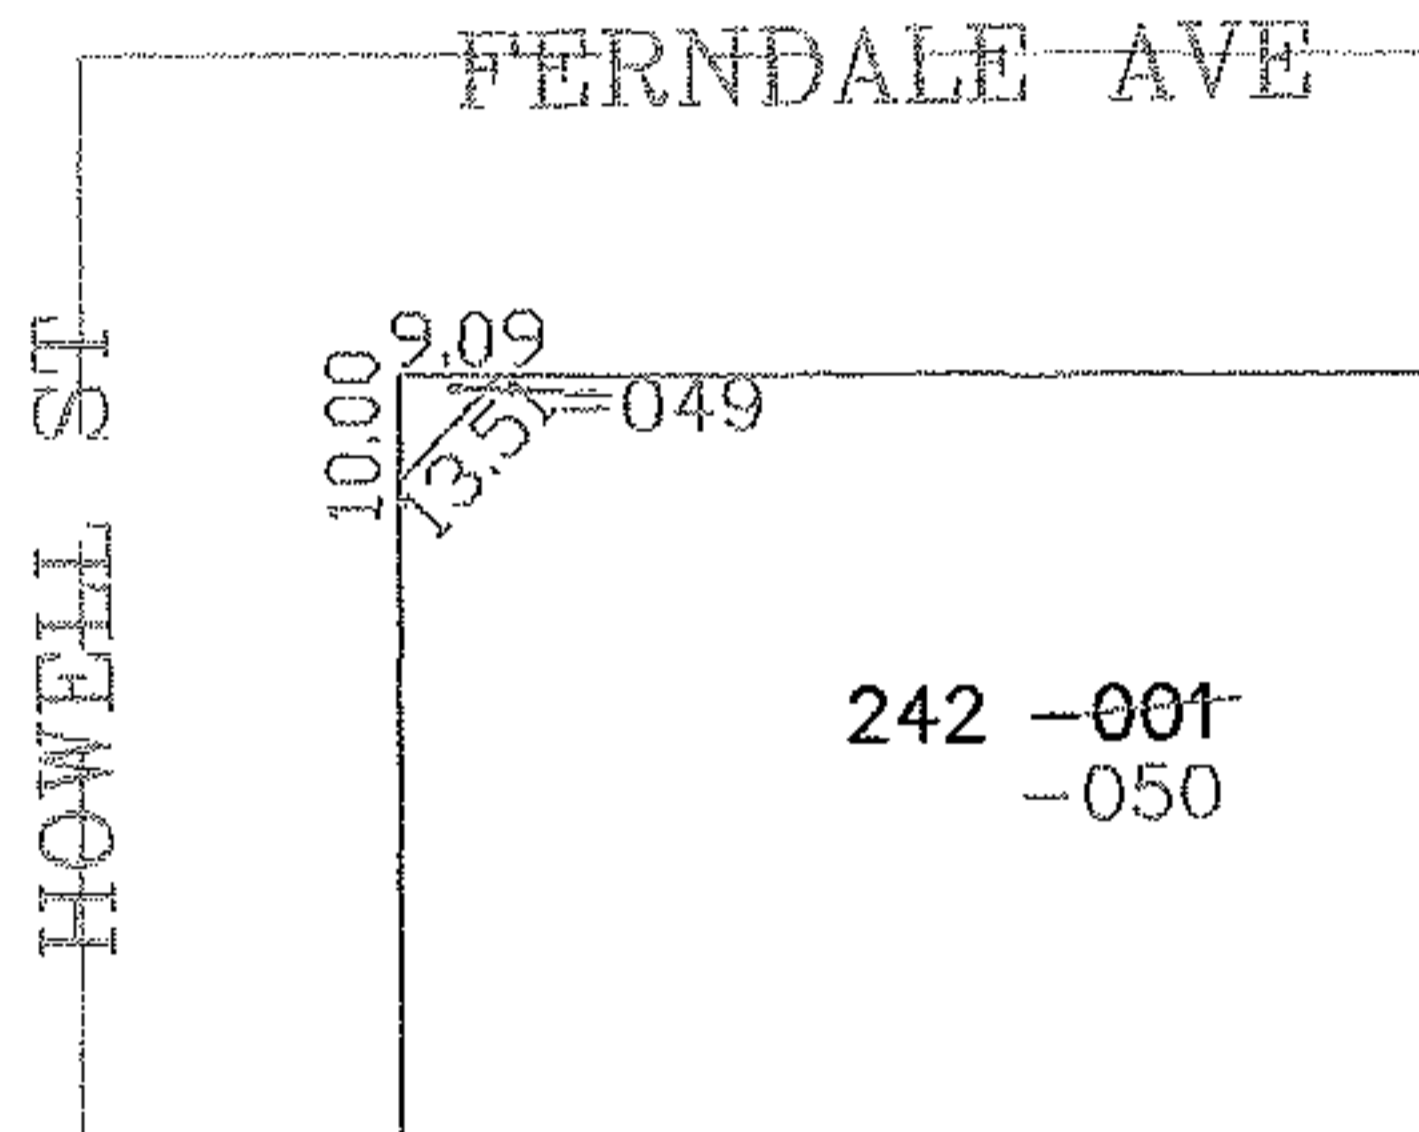


PARENT PARCEL: 03-00-042-114-001

CHILD PARCEL: 03-00-042-114-049, -050

STARTING POINT: SIDELINE OF FERNDALE AVE & HOWELL ST

07-00174

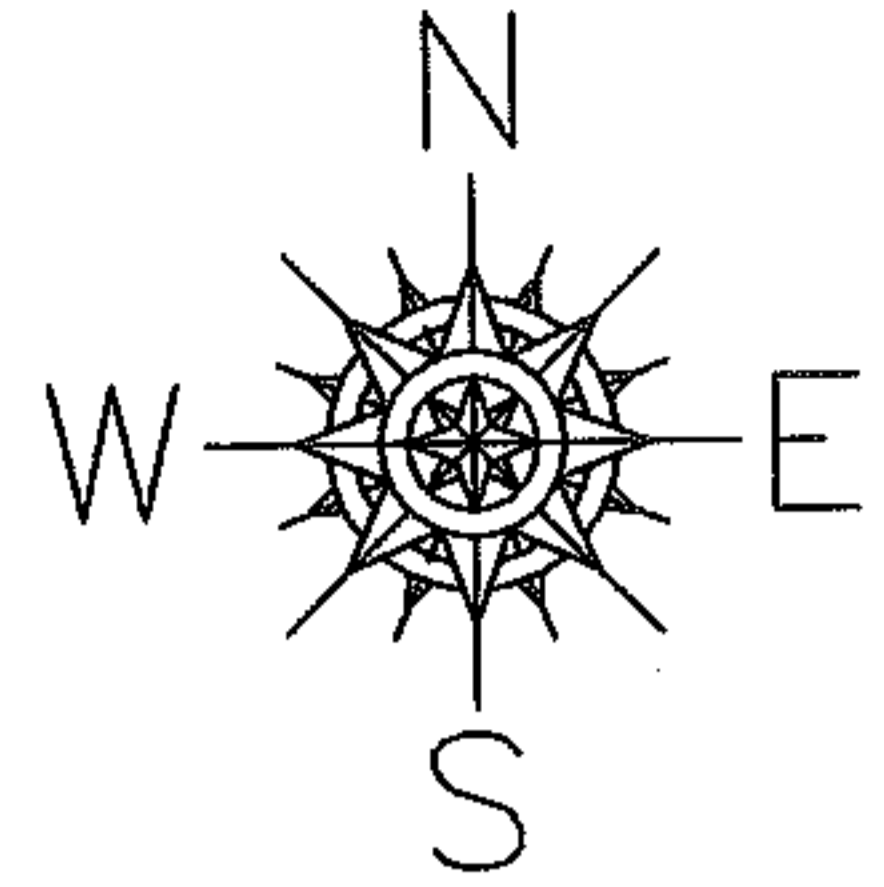

SPLITS/DEEDS PROCESSED

LORAIN COUNTY TAX MAP DEPARTMENT
226 MIDDLE AVE. ELYRIA, OHIO

SURVEYED BY: ROBERT J. MCAULEY

CLOSURE: 0.00 : 10.000

MAP PAGE(S): 03-00-042-B

APPROVED BY: JAH DATE: 3-5-07

SCALE: 1" = 100 PRIOR INSTRUMENT: 20040024833