
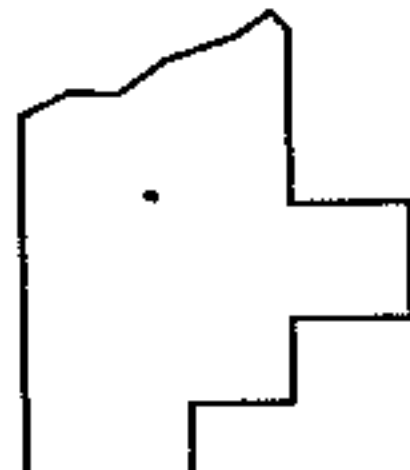
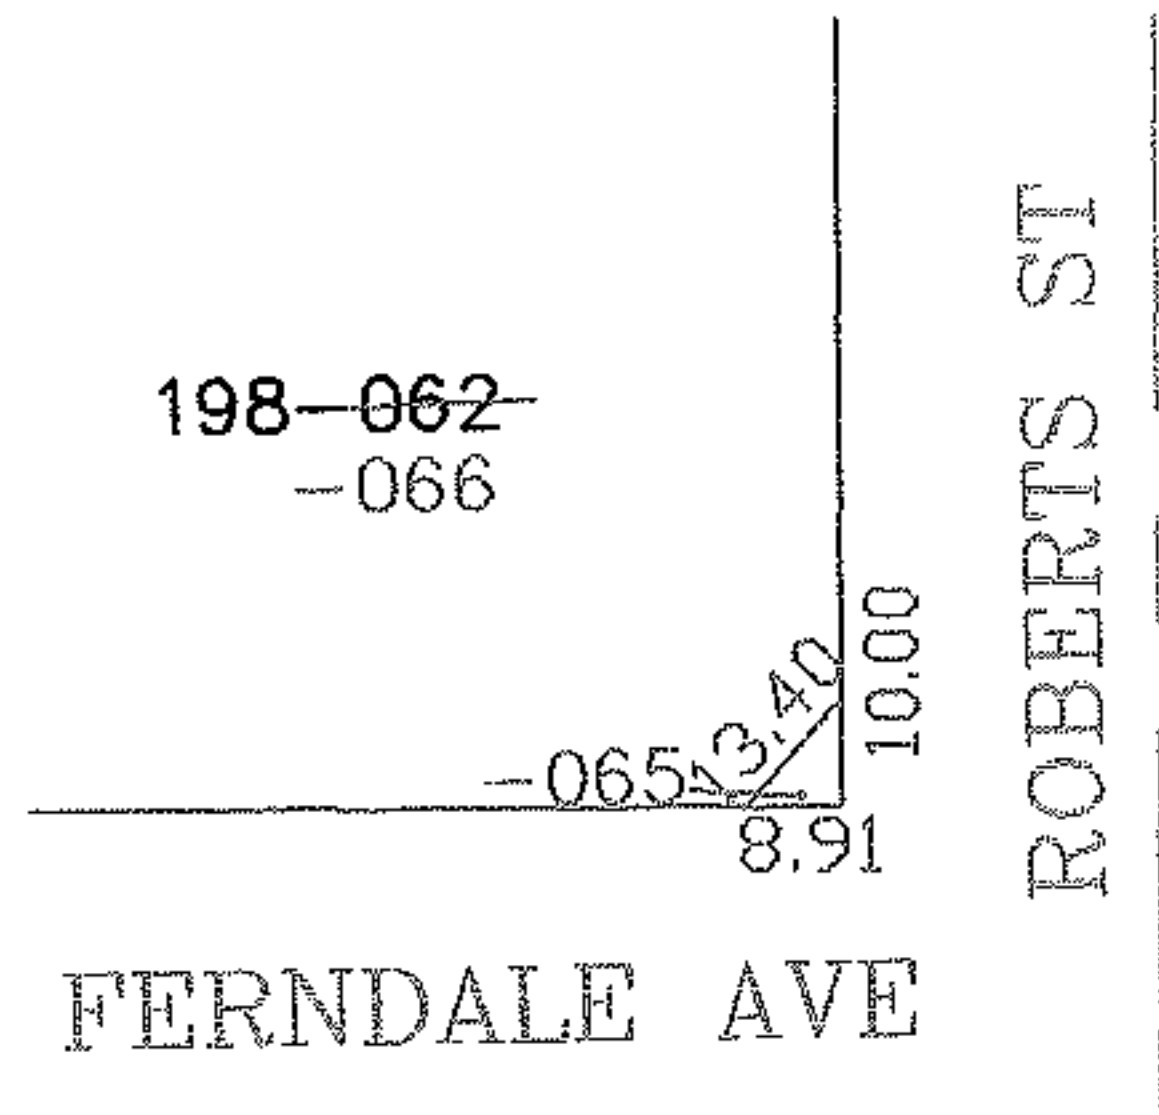


PARENT PARCEL: 03-00-042-110-062

CHILD PARCEL: 03-00-042-110-065, -066

STARTING POINT: SIDELINE OF FERNDALE AVE & ROBERTS ST

07-00175

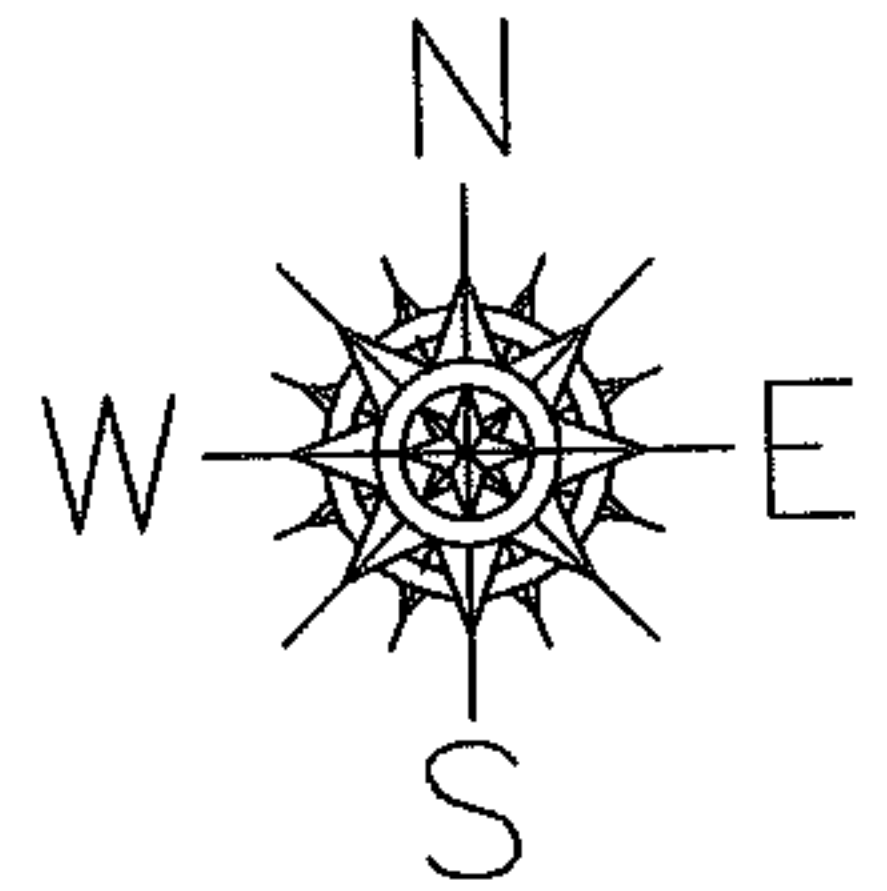

SPLITS/DEEDS PROCESSED

LORAIN COUNTY TAX MAP DEPARTMENT
226 MIDDLE AVE. ELYRIA, OHIO

SURVEYED BY: ROBERT J MCAULEY

CLOSURE: 0.00 : 10.000

MAP PAGE(S): 03-00-042-B

APPROVED BY: JAH DATE: 3-5-07

SCALE: 1" = 100 PRIOR INSTRUMENT: DV 1345/84