
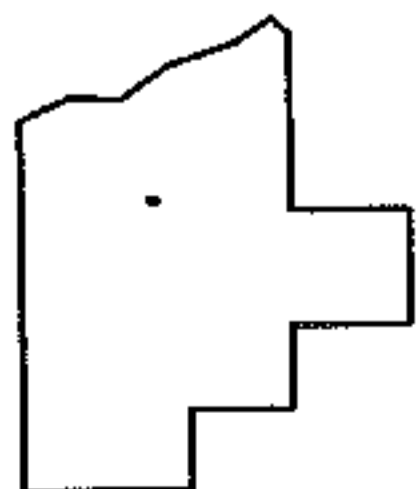
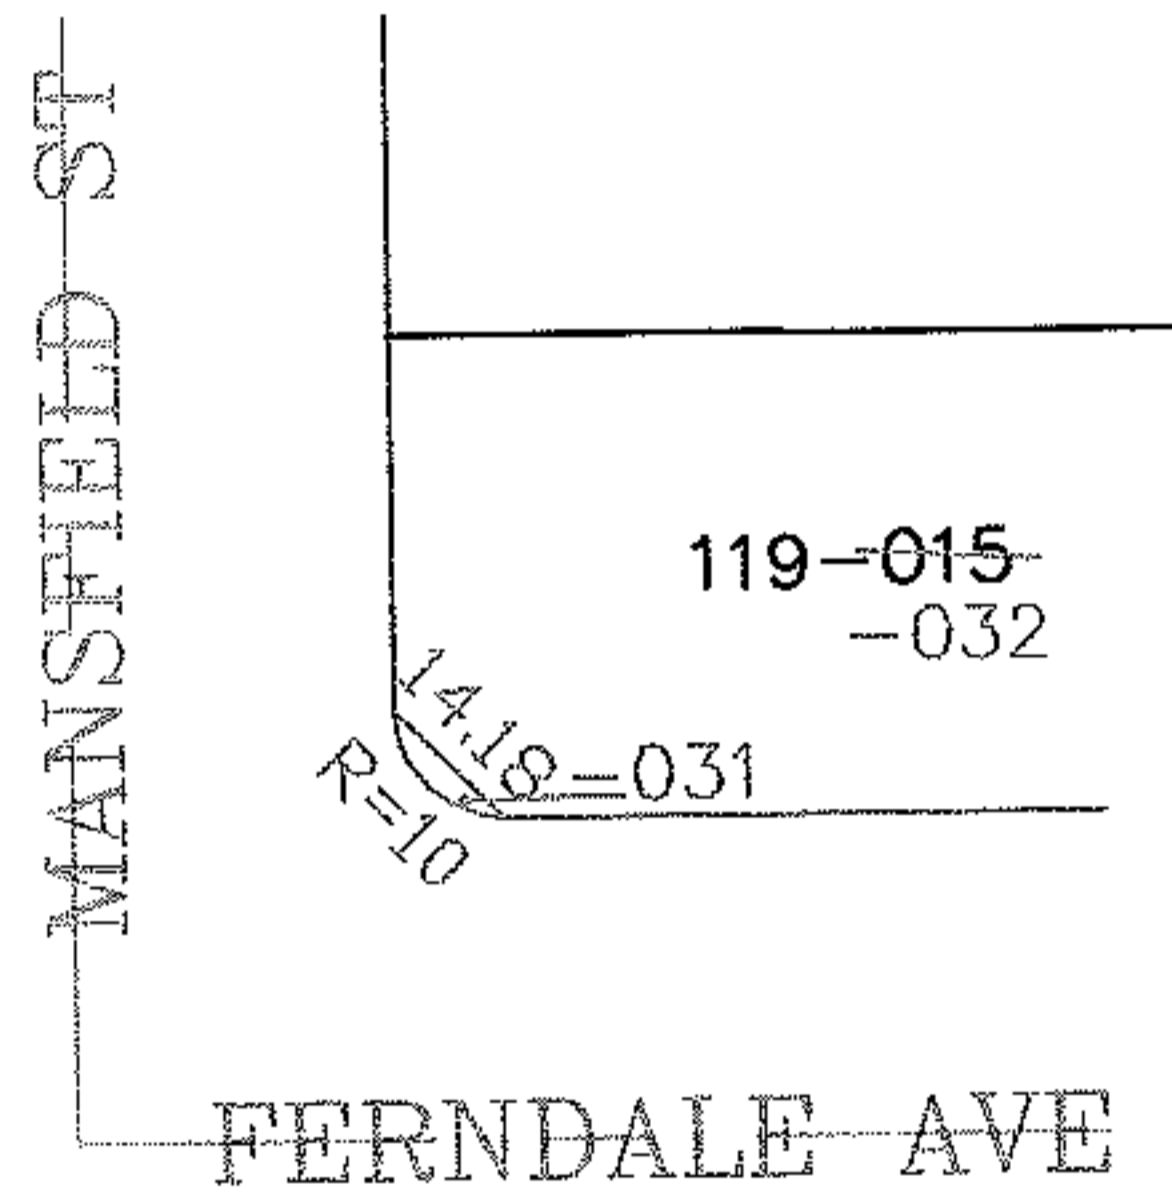


PARENT PARCEL: 03-00-041-111-015

CHILD PARCEL: 03-00-041-111-031, -032

STARTING POINT: SIDELINE OF FERNDALE AVE & MANSFIELD ST

07-00182

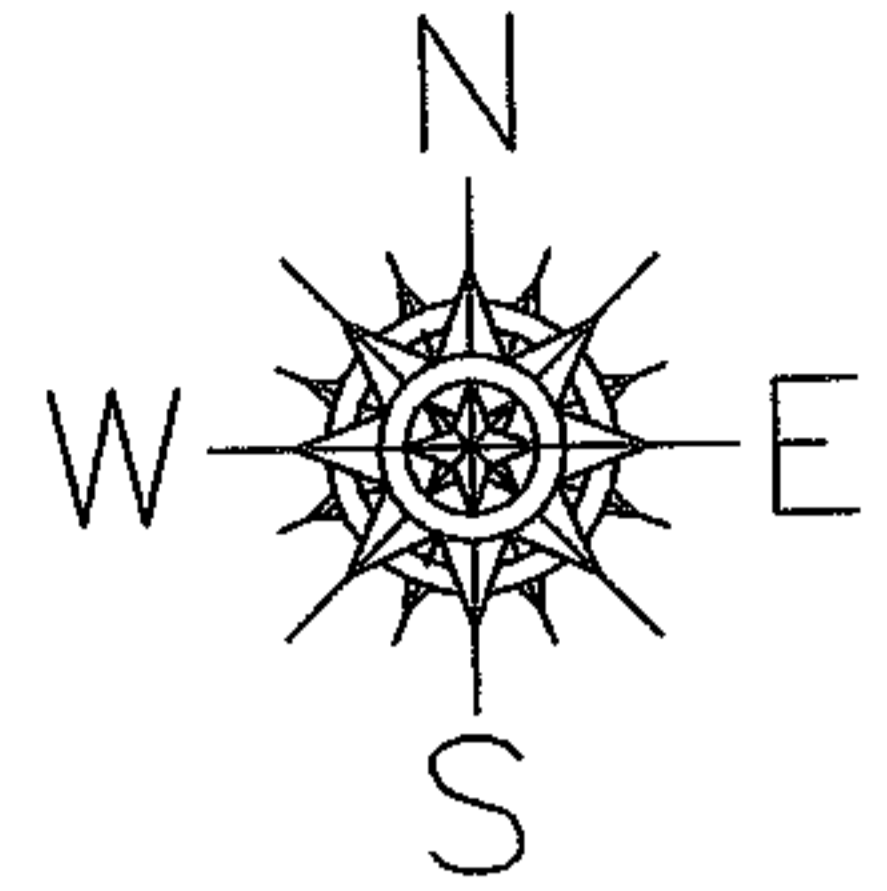

SPLITS/DEEDS PROCESSED

LORAIN COUNTY TAX MAP DEPARTMENT  
226 MIDDLE AVE. ELYRIA, OHIO

SURVEYED BY: ROBERT J MCAULEY

CLOSURE: 0.00 : 10,000

MAP PAGE(S): 03-00-041

APPROVED BY: JAH DATE: 3-6-07

SCALE: 1" = 100 PRIOR INSTRUMENT: DV 749/491