
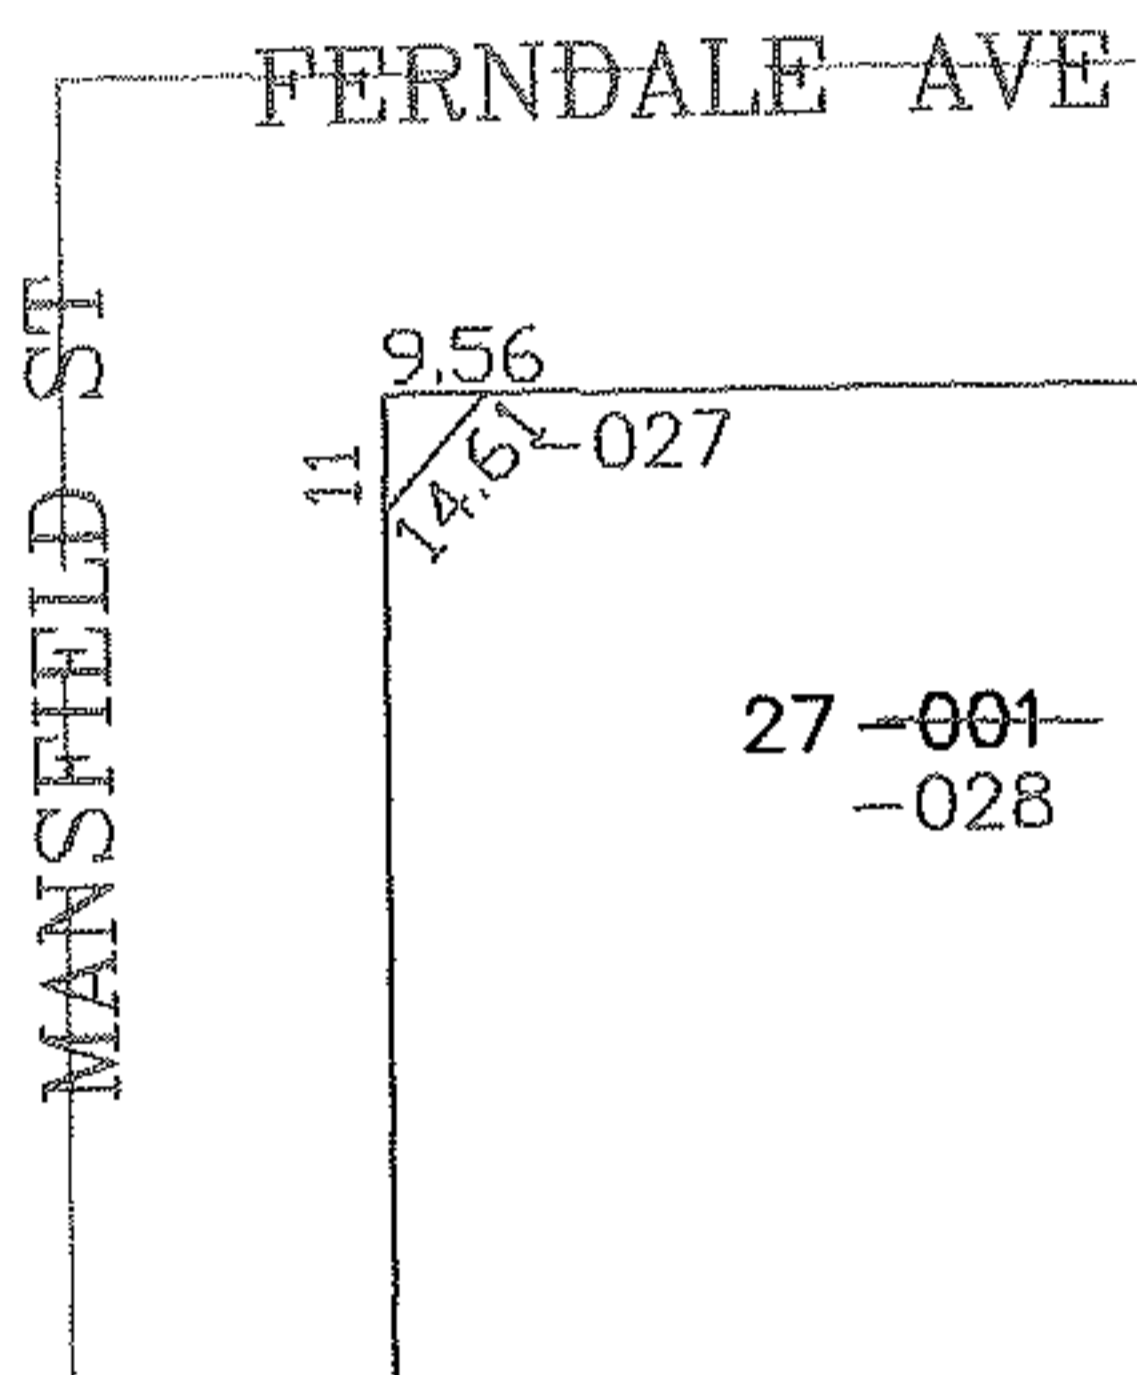


PARENT PARCEL: 03-00-041-116-001

CHILD PARCEL: 03-00-041-116-027, -028

STARTING POINT: SIDELINE OF FERNDALE AVE & MANSFIELD ST

07-0188

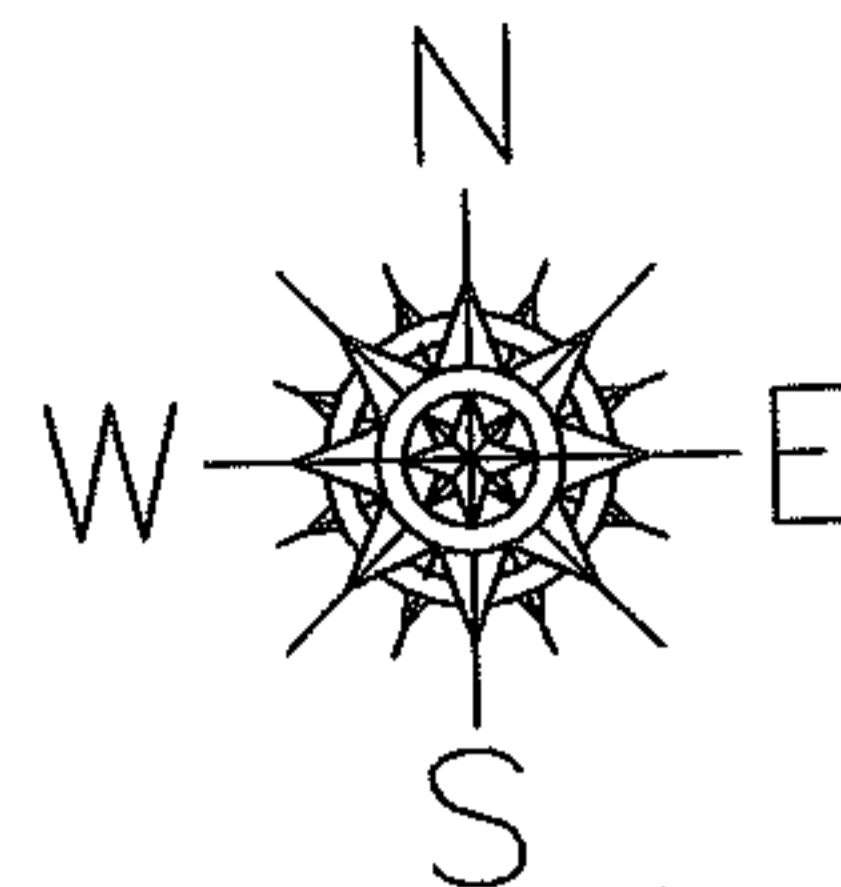

SPLITS/DEEDS PROCESSED

LORAIN COUNTY TAX MAP DEPARTMENT
226 MIDDLE AVE. ELYRIA, OHIO

SURVEYED BY: ROBERT J MCAULEY

CLOSURE: 0.00 : 10.000

MAP PAGE(S): 03-00-041

APPROVED BY: JAH DATE: 3-7-07

SCALE: 1" = 100 PRIOR INSTRUMENT: DV 1325/554