
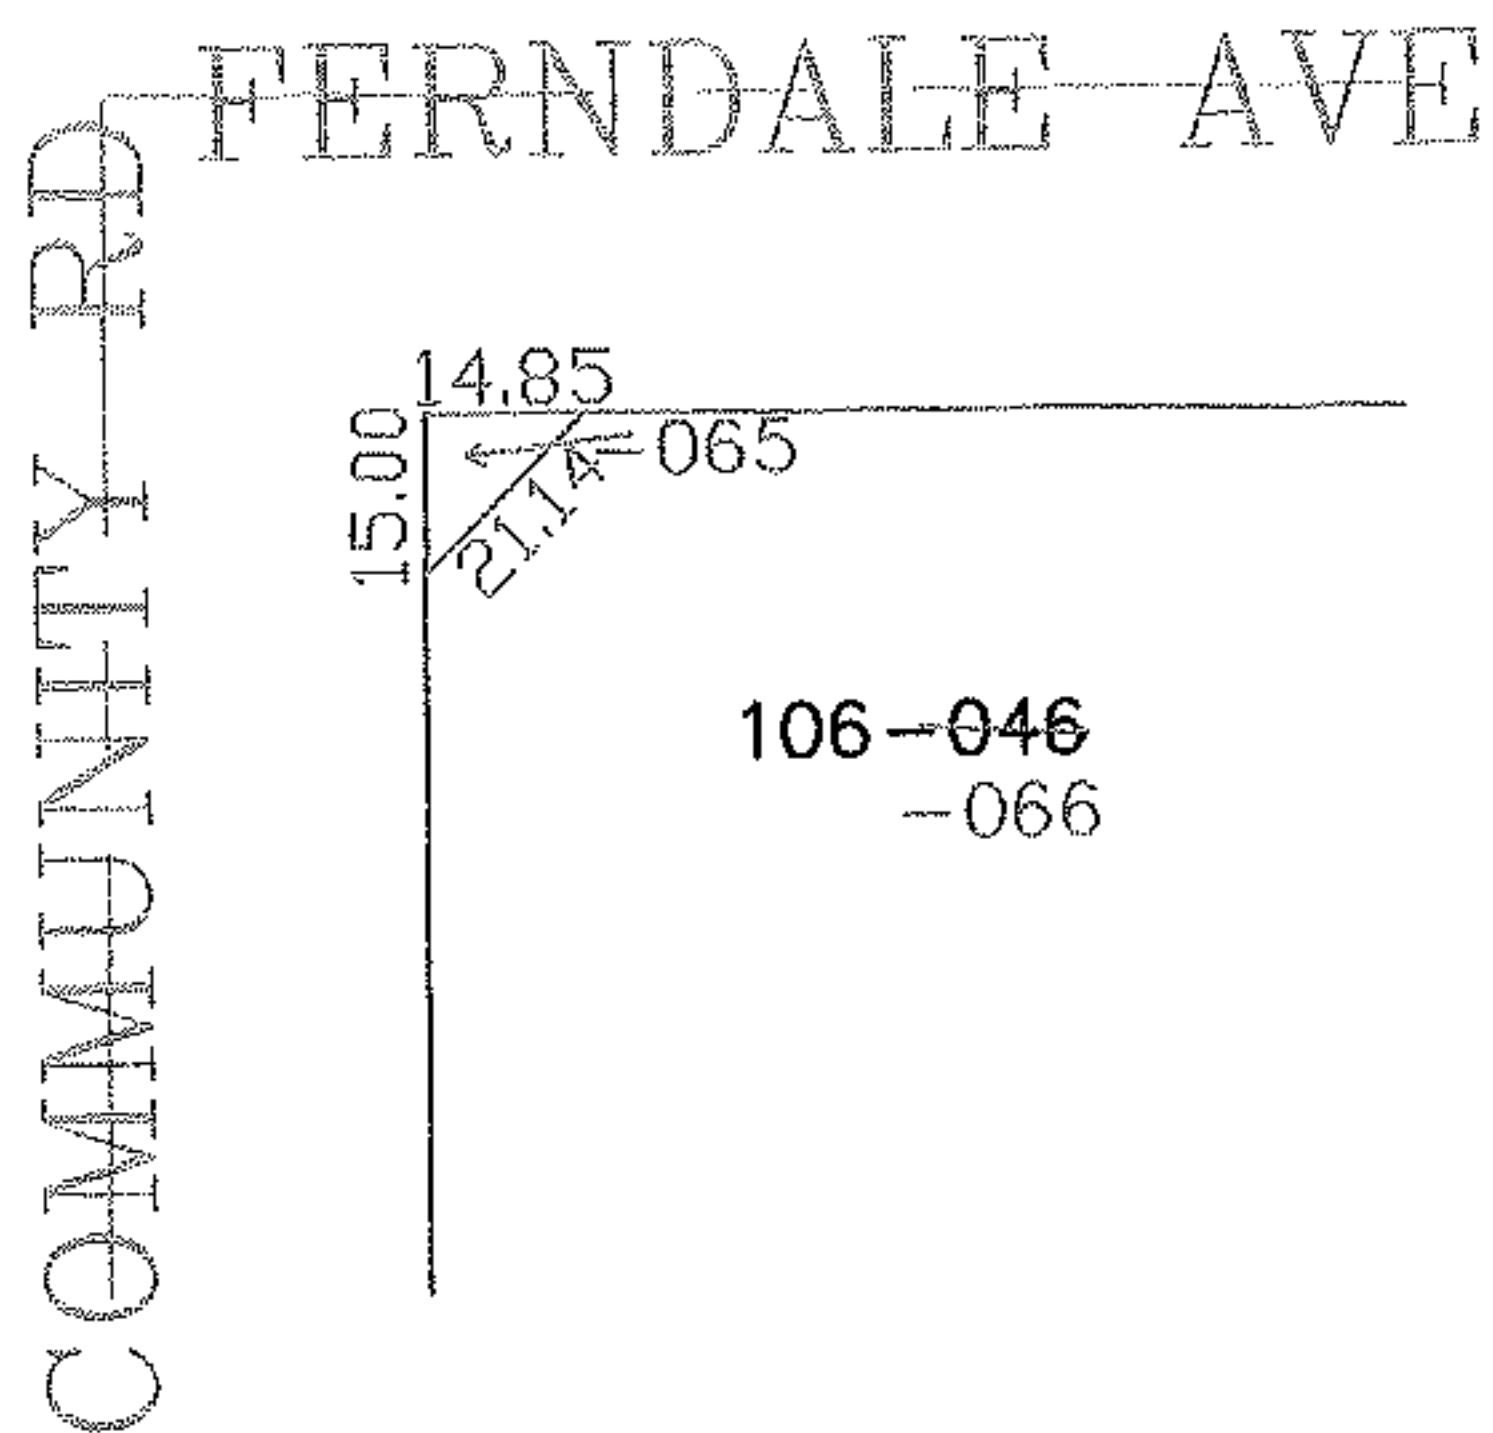


PARENT PARCEL: 03-00-041-118-046

CHILD PARCEL: 03-00-041-118-065, -066

STARTING POINT: SIDELINE OF COMMUNITY RD & FERNDALE AVE

07-00193

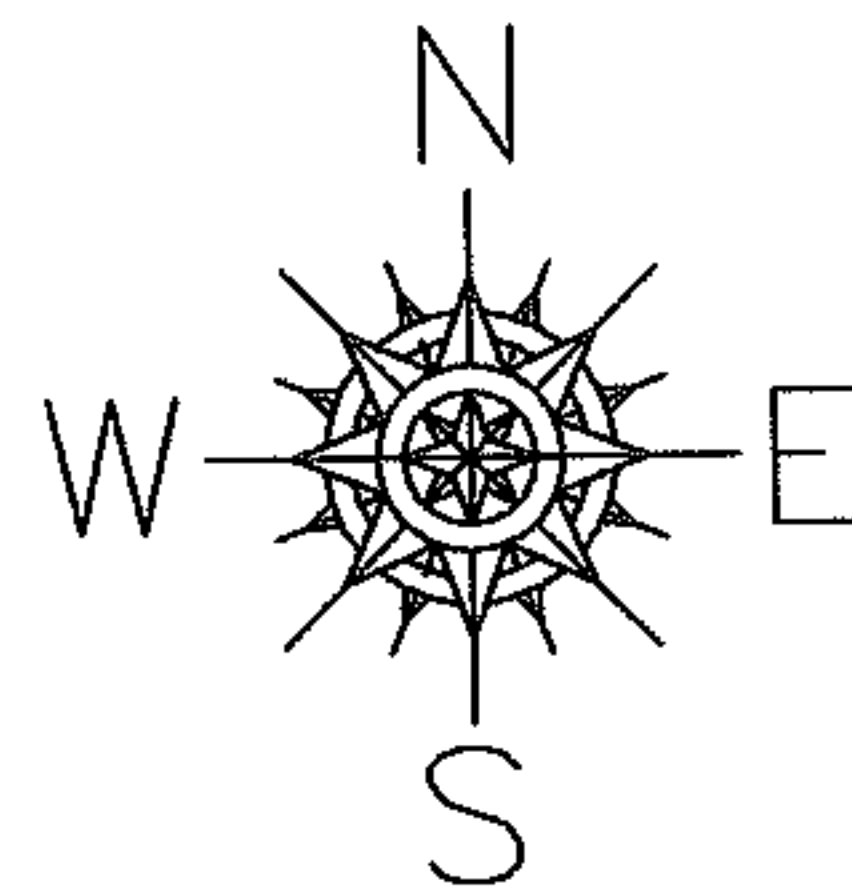

SPLITS/DEEDS PROCESSED

LORAIN COUNTY TAX MAP DEPARTMENT
226 MIDDLE AVE. ELYRIA, OHIO

SURVEYED BY: ROBERT J MCAULEY

CLOSURE: 0.00 : 10.000

MAP PAGE(S): 03-00-041

APPROVED BY: JAH DATE: 3-6-07

SCALE: 1" = 100 PRIOR INSTRUMENT: 19990649333